

S.S. Avon

Received at Middlesbrough Office 12th Nov 1890

Lloyd's Register of British and Foreign Shipping.

(Report on Vessel No. 364 Port Inbro.)

Middlesbrough

No. 1726A SHIP FORGINGS OR CASTINGS.

I have to report that the undermentioned Iron or Steel Forgings or Castings, manufactured by

The Stockton Forge Co. of Stockton

for the Vessel No. 378, being built by Messrs Richardson Duck & Co.

of Stockton have been inspected by me as set forth below, and found to be, so far as can be seen, sound

The words FORGINGS or CASTINGS, IRON or STEEL, should be struck out as may be required.

Mark on Forgings.


Lloyd's No. 1726A S.S. Avon

Wm Cameron

London 11. 11. 90.

Table with 4 columns: Material, How made, Dimensions, Progress on Inspection, Dates when Inspected. Rows for STERN FRAME, RUDDER FRAME, and STEM.

SKETCHES OF FRAMES SHEWING POSITION AND DESCRIPTION OF WELDS OF FORGINGS, OR PARTICULARS OF TESTS APPLIED TO CASTINGS.

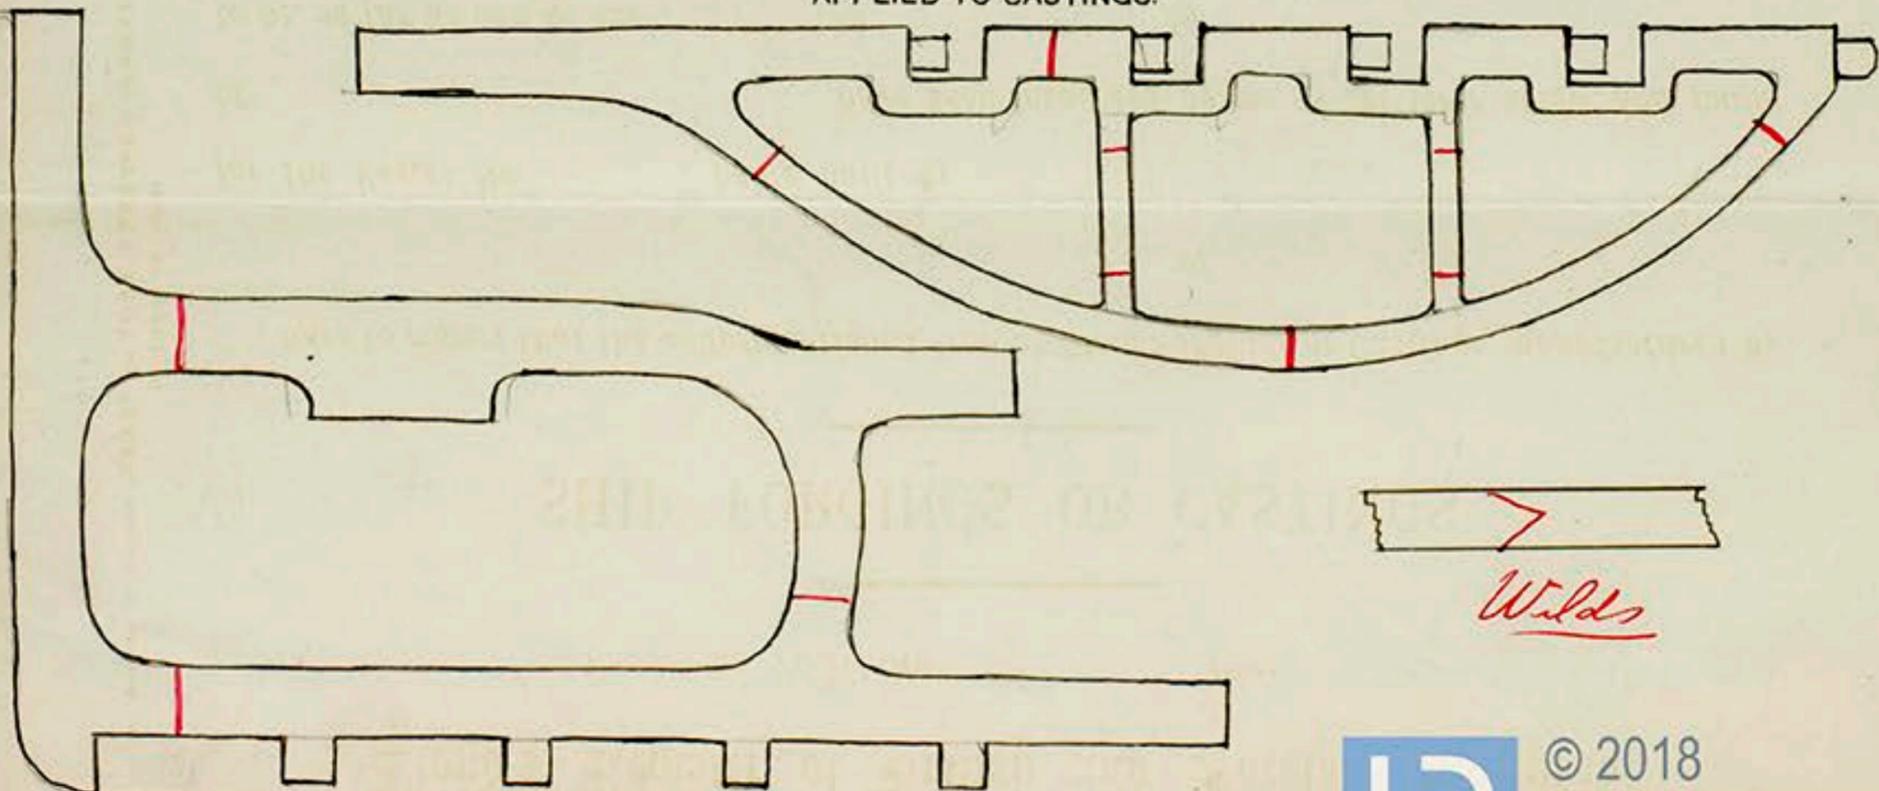

Welds

* If of Iron, state whether scrap or puddled Iron.

