

S. J. Lammernoor "Received at Middlesbro' office, 18<sup>th</sup> March 1891

Lloyd's Register of British and Foreign Shipping.

Middlesbro (Report on Vessel No. 384 Port Middlesbrough)

No. 1782a. SHIP FORGINGS OR CASTINGS.

I have to report that the undermentioned Iron or Steel Forgings or Castings, manufactured by  
*The Stockton Forge Co. of Stockton*  
 for the Vessel No. 257, being built by *Messrs Roper Son*  
 of *Stockton* have been inspected by me as set forth below, and found  
 to be, so far as can be seen, *sound*.

The words FORGINGS OR CASTINGS, IRON OR STEEL, should be struck out as may be required.


Mark on Forgings.

Lloyd's  
 No. 1782a  
 S. J. L.

*Hugh Cameron*  
*Sunderland*

	STERN FRAME.	RUDDER FRAME.	STEM.
Material* . . . . .	<i>Scrap iron</i>	<i>Scrap iron</i>	<i>scrap iron</i>
How made . . . . .	<i>Forged</i>	<i>Forged</i>	<i>Forged</i>
Dimensions . . . . .	<i>10' x 6'</i>	<i>8' x 4'</i>	<i>10' x 2 3/4'</i>
Progress on Inspection . . . . .	<i>Forged &amp; smithed</i>	<i>Forged &amp; smithed</i>	<i>Forged</i>
Dates when Inspected	<i>Oct 10-17-21-30/90</i>	<i>Feb 11-16-26 March 4-10/91</i>	<i>Nov 29/90</i>

SKETCHES OF FRAMES SHEWING POSITION AND DESCRIPTION OF WELDS OF FORGINGS, OR PARTICULARS OF TESTS APPLIED TO CASTINGS.

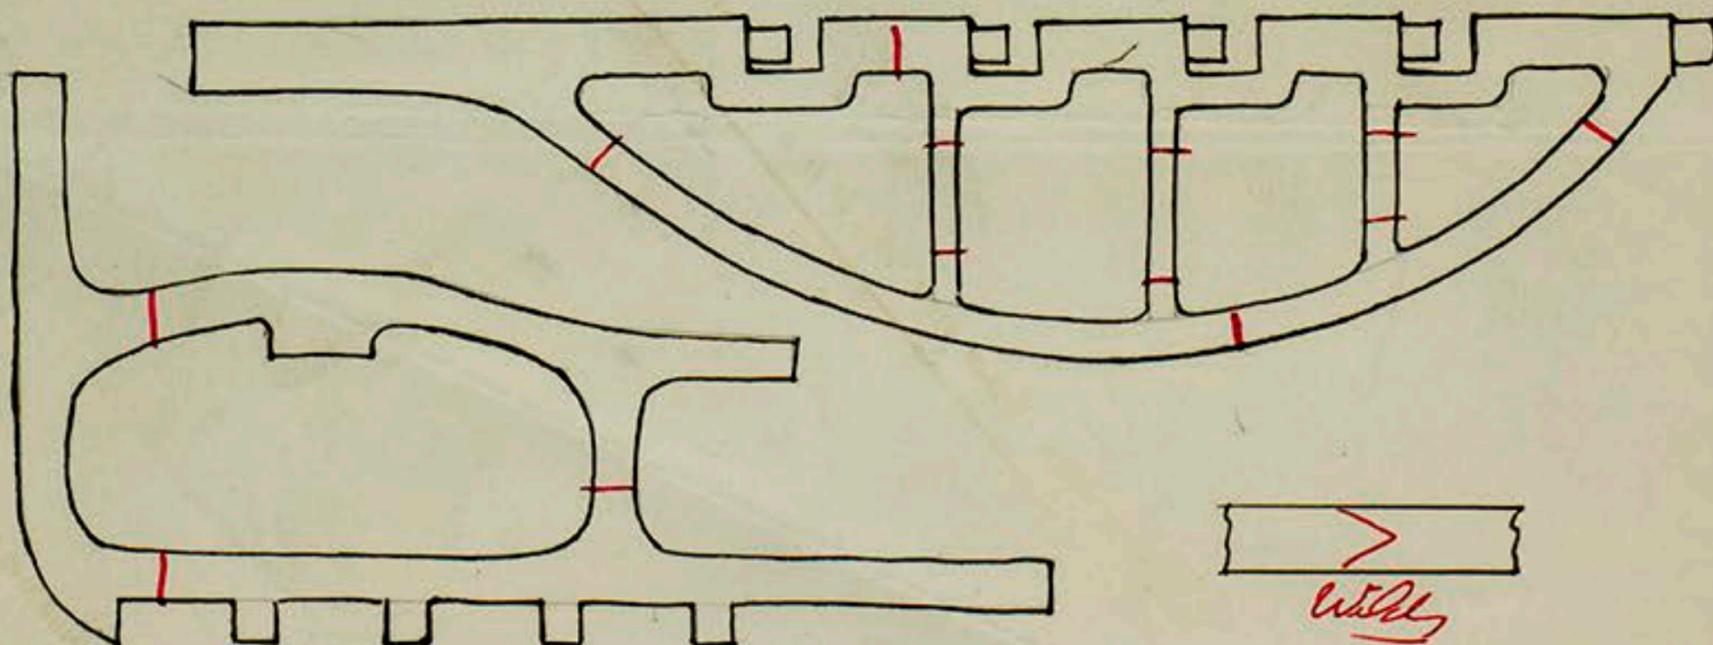

\* If of Iron, state whether scrap or puddled Iron.