


188 20" 90

PUMPING ARRANGEMENT

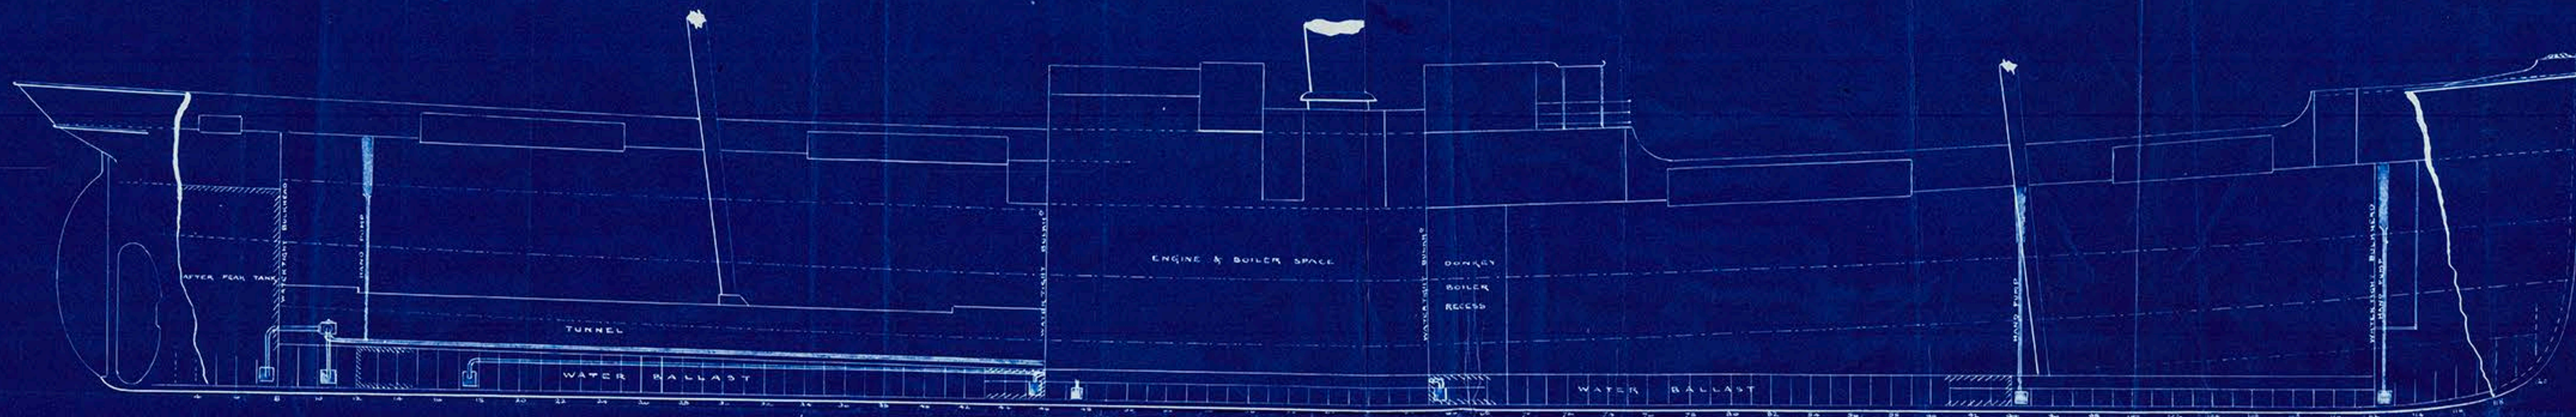

Nº 336

SCALE 1/8 INCH TO A FOOT

*Bilge suction
& separate suction
to Dunky.*

*accessible through
on engine room
bulkheads.*
J.T.M.
18/11/90

SAR RAYSON DIXON & CO
IRON SHIPBUILDERS
CLEVELAND DOCKYARD
MIDDLESBROUGH, ENGLAND



Lloyd's Register
Foundation

'Oscar'

Sld 15990

Wab 390

LIBRARY OF THE LLOYD'S REGISTER FOUNDATION