


N° 336

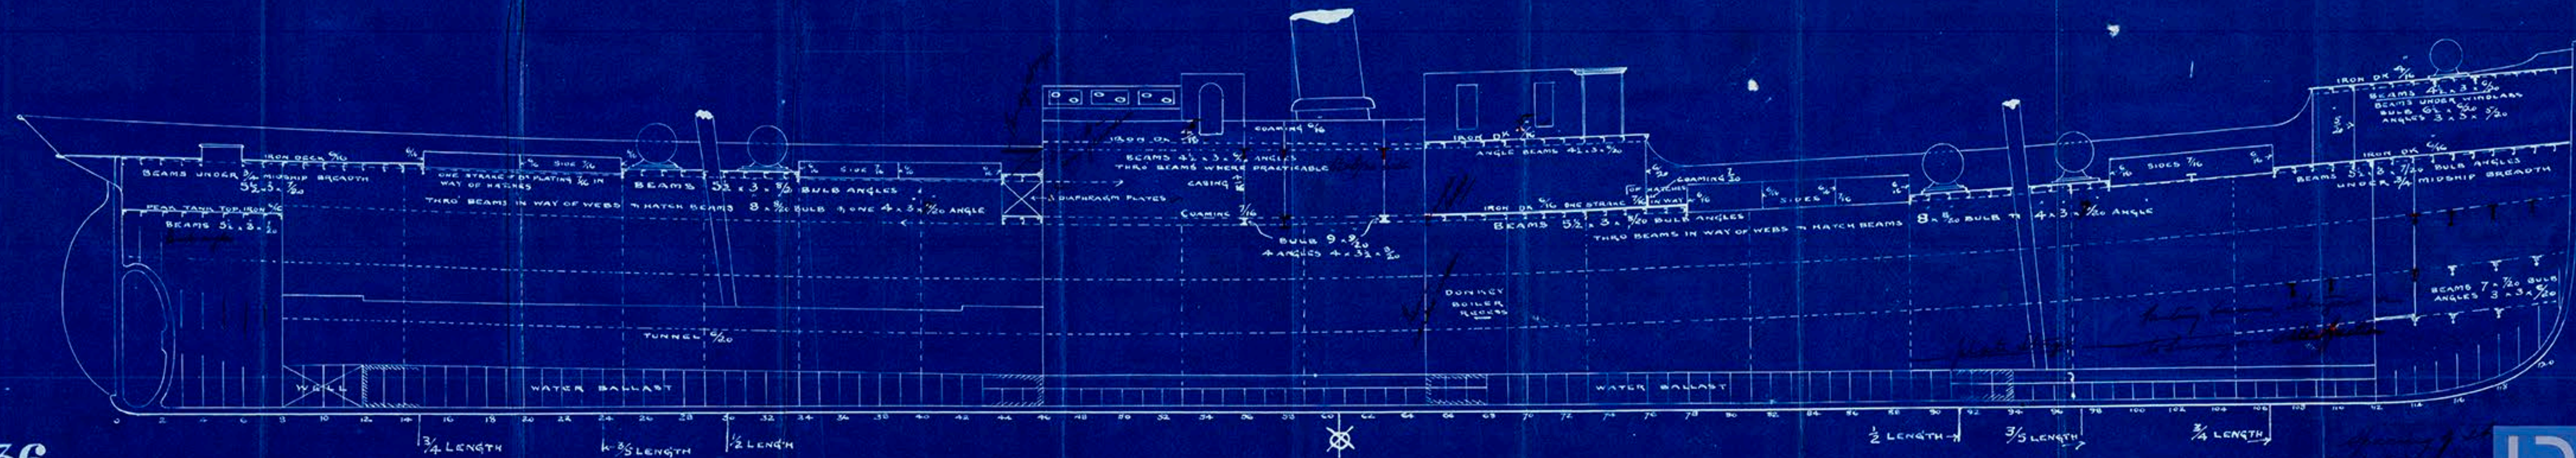

R Dism + Co
Middlesbrough

Ref No 336

Elevation

S.S. "Oscar"

Rep No 390



Sld 15990



© 2018

Lloyd's Register
Foundation