


3.7.96

300 x 42 x 27'6" moulded.  
Steel Spar Decked Steamer

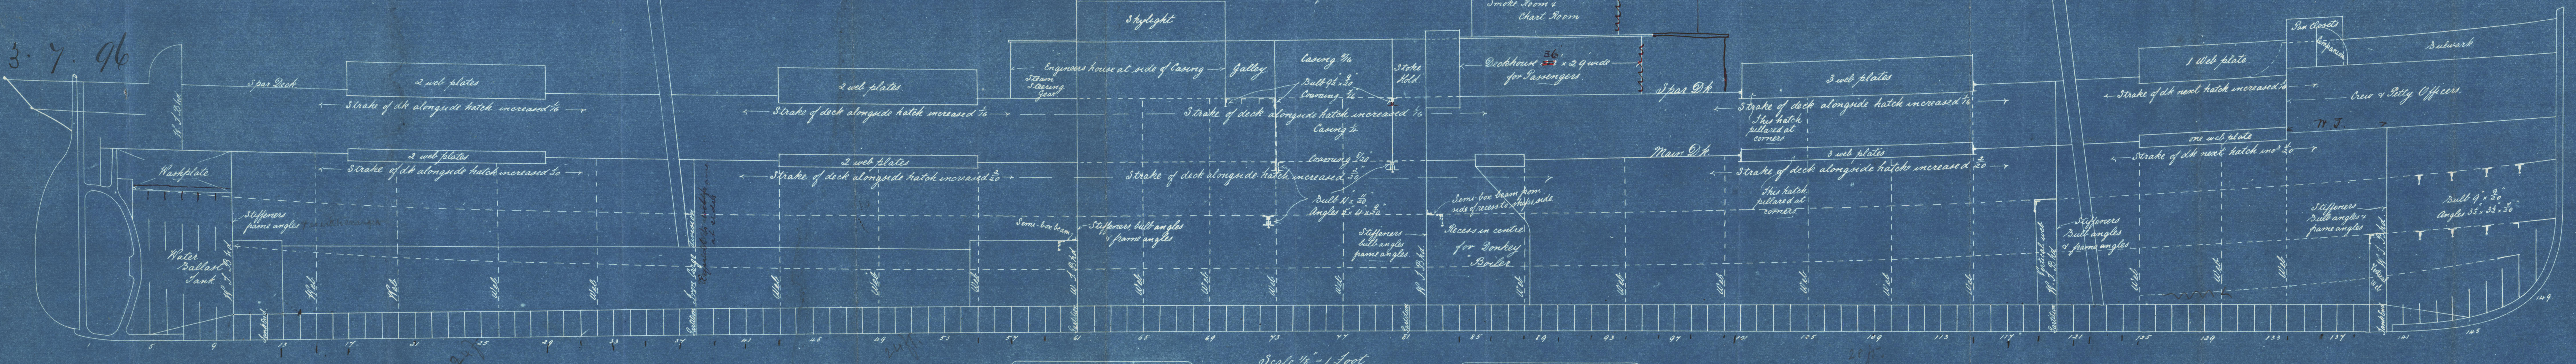

New Richardson Dock Co.  
Shipbuilders  
Stockton-on-Tees  
June 30th 1896



J.V.L.  
3/7/96

No 482.





Profile.  
Richardson Duck Cove  
No 482

S. S. Troja.  
New Report - No 1938



© 2020

Lloyd's Register  
Foundation

MOB755-0232