

*Sp Albertville*

Received at *Middlesbro* Office, *11<sup>th</sup> March 1898*

Lloyd's Register of British and Foreign Shipping.

*Middlesbro* (Report on Vessel No. *2406* Port *Mdb*)

No. *3646a* SHIP FORGINGS OR CASTINGS.

I have to report that the undermentioned Iron or Steel Forgings or Castings, manufactured by *The Darlington Forge Co.* of *Darlington* for the Vessel No. *447*, being built by *Messrs Sir Raylton Dixon & Co.* of *Middlesbro* have been inspected by me as set forth below, and found to be, so far as can be seen, *sound*


Mark on Forgings.

Lloyd's  
No. *3646a*  
*90 C.*

*Rough Cameron*  
*Sunderland*

	STERN FRAME.	RUDDER FRAME.	STEM.
Material*	<i>Scrap iron</i>	<i>Scrap iron</i>	<i>Scrap iron</i>
How made	<i>Forged</i>	<i>Forged</i>	<i>Forged</i>
Dimensions	<i>11 x 6 1/2</i>	<i>8 1/2 - 4 1/4</i>	<i>11 x 2 3/4</i>
Progress on Inspection	<i>Forged &amp; smithed</i>	<i>Forged &amp; smithed</i>	<i>Forged</i>
Date when Inspected	<i>Oct 1st &amp; 15/97</i>	<i>Dec 2/97 to Feb 4/98</i>	<i>Oct 15/97</i>

SKETCHES OF FRAMES SHOWING POSITION AND DESCRIPTION OF WELDS OF FORGINGS, OR PARTICULARS OF TESTS APPLIED TO CASTINGS.

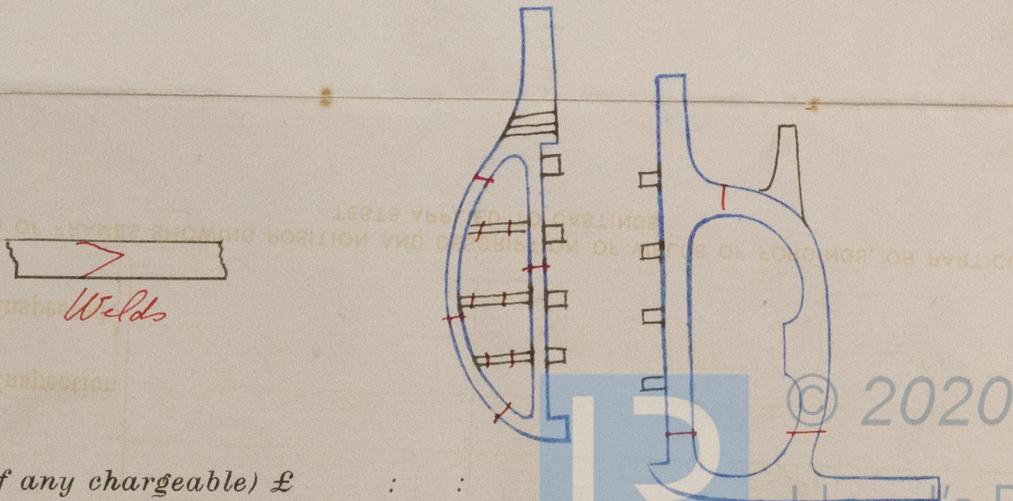

Fee (if any chargeable) £ : :

To be paid at \_\_\_\_\_

\* If of Iron, state whether scrap or puddled Iron.