

1/2 Alf

Received at *Middlesbro'* office, *11th October 1898*

Lloyd's Register of British and Foreign Shipping.

(Report on Vessel No. *2471* Port *Mdb.*)
Middlesbro'

No. *3746.a.* SHIP FORGINGS OR CASTINGS.

I have to report that the undermentioned Iron or Steel Forgings or Castings, manufactured by *Messrs Wad Nicholson & Co.* of *Stretton* for the Vessel No. *351*, being built by *Messrs Roper & Son* of *Stretton* have been inspected by me as set forth below, and found to be, so far as can be seen, *sound*

The words FORGINGS or CASTINGS, IRON or STEEL, should be struck out as may be required.


Mark on Forgings.

Lloyd's
No. *3746a*
80 to

W. H. Cannon
Sunderland
15. 10. 98

| | STERN FRAME. | RUDDER FRAME. | STEM. |
|------------------------|---|---|-----------------------|
| Material* | <i>Scrap</i> | <i>Scrap</i> | <i>Scrap</i> |
| How made | <i>Forged</i> | <i>Forged</i> | <i>Forged</i> |
| Dimensions | <i>11" x 6"</i> | <i>8 1/2 - 4 1/4</i> | <i>10 1/2 x 2 3/4</i> |
| Progress on Inspection | <i>Forged + Smithed</i> | <i>Forged Smithed</i> | <i>Forged</i> |
| Date when Inspected | <i>March 15th to May 26/98</i> | <i>June 15th to Sept 12/98</i> | <i>May 16/98</i> |

SKETCHES OF FRAMES SHOWING POSITION AND DESCRIPTION OF WELDS OF FORGINGS, OR PARTICULARS OF TESTS APPLIED TO CASTINGS.

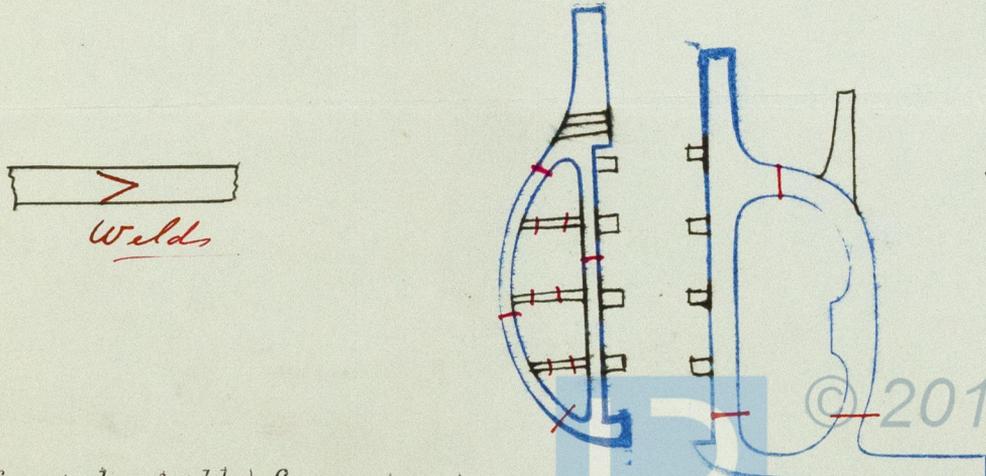

Fee (if any chargeable) £ : :
To be paid at **SUNDERLAND.**

© 2019
Lloyd's Register
Foundation
MDB760-0143

* If of Iron, state whether scrap or puddled Iron.