

Master Plan  
Ropner & Sons  
nos 354 & 355

S.S. "Greenwich"  
Intro Report - 2520.

MDB761-0095



© 2020

Lloyd's Register  
Foundation



MIDDLESBROUGH-ON-TEES.

© 2020

To be returned for guidance  
in the survey of sister vessels

MPB761-0095



MIDDLE  
NUMBER  
in the curve

# STEEL LOWERMMASTS

SCALE  $\frac{1}{4}$ " INCH - 1 FOOT


MASTS TO BE MADE IN TWO PLATES IN THE ROUND FORE STRAKE OUTSIDE ✓

BUTT STRIPS FITTED INSIDE, ALL TREBLE RIVETED AND  $\frac{2}{20}$  THICKER ✓


BUTTS & SEAMS RIVETED WITH  $\frac{3}{4}$  RIVETS, 5 DIARS. APART, SEAMS SINGLE RIVETED ✓

MASTS TO CARRY NO SAILS.

## FOREMAST

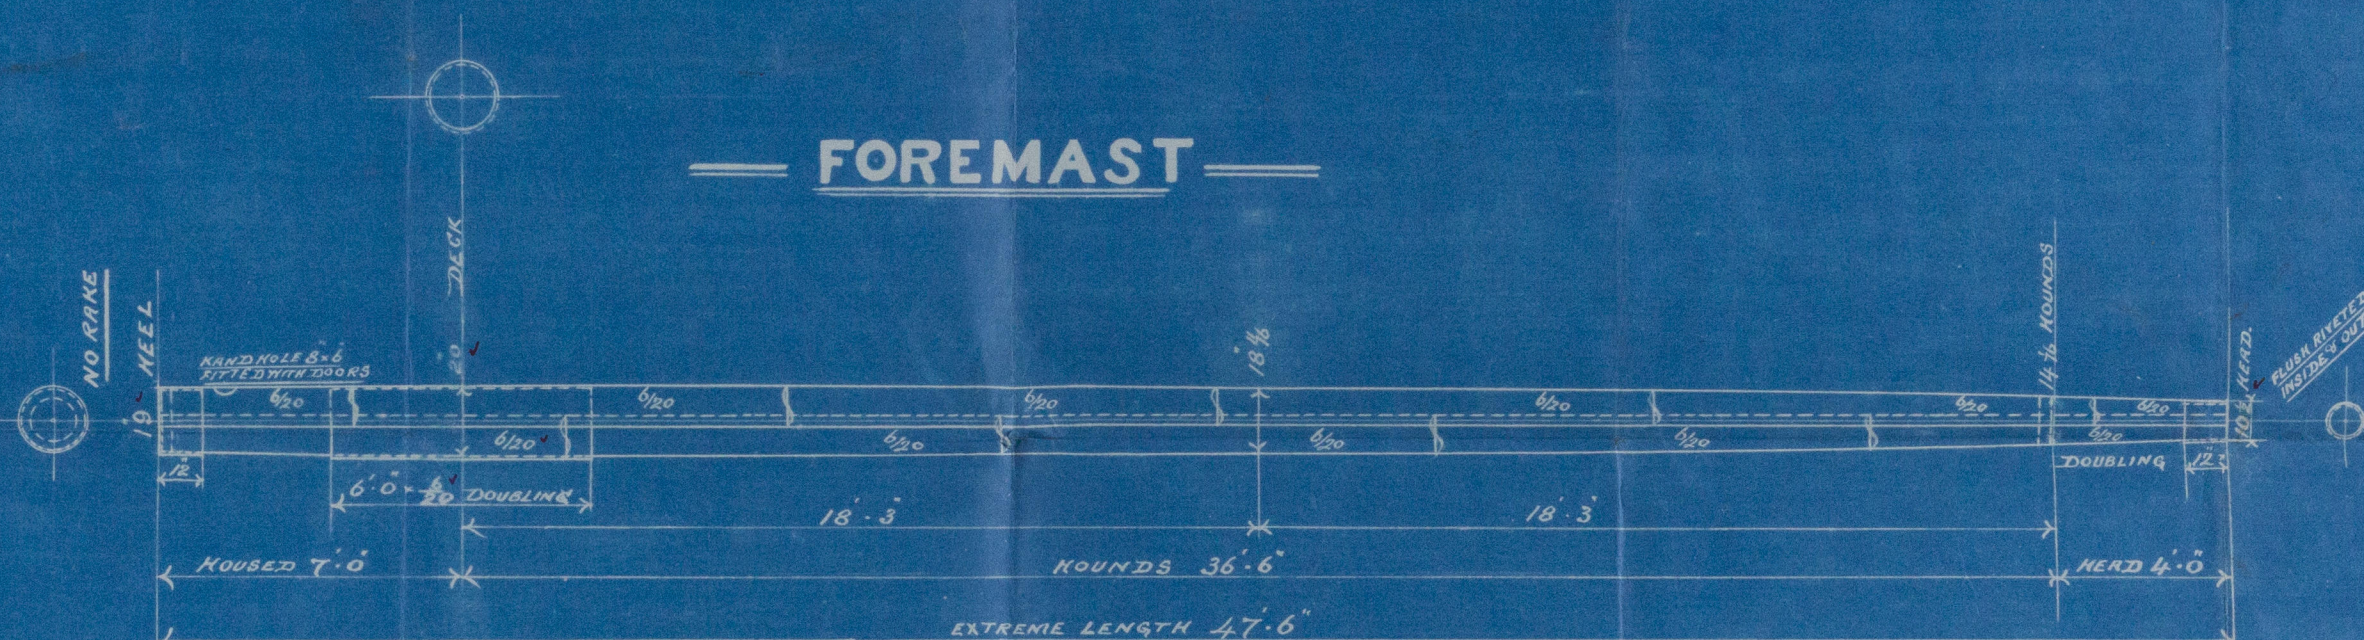

## MAINMAST

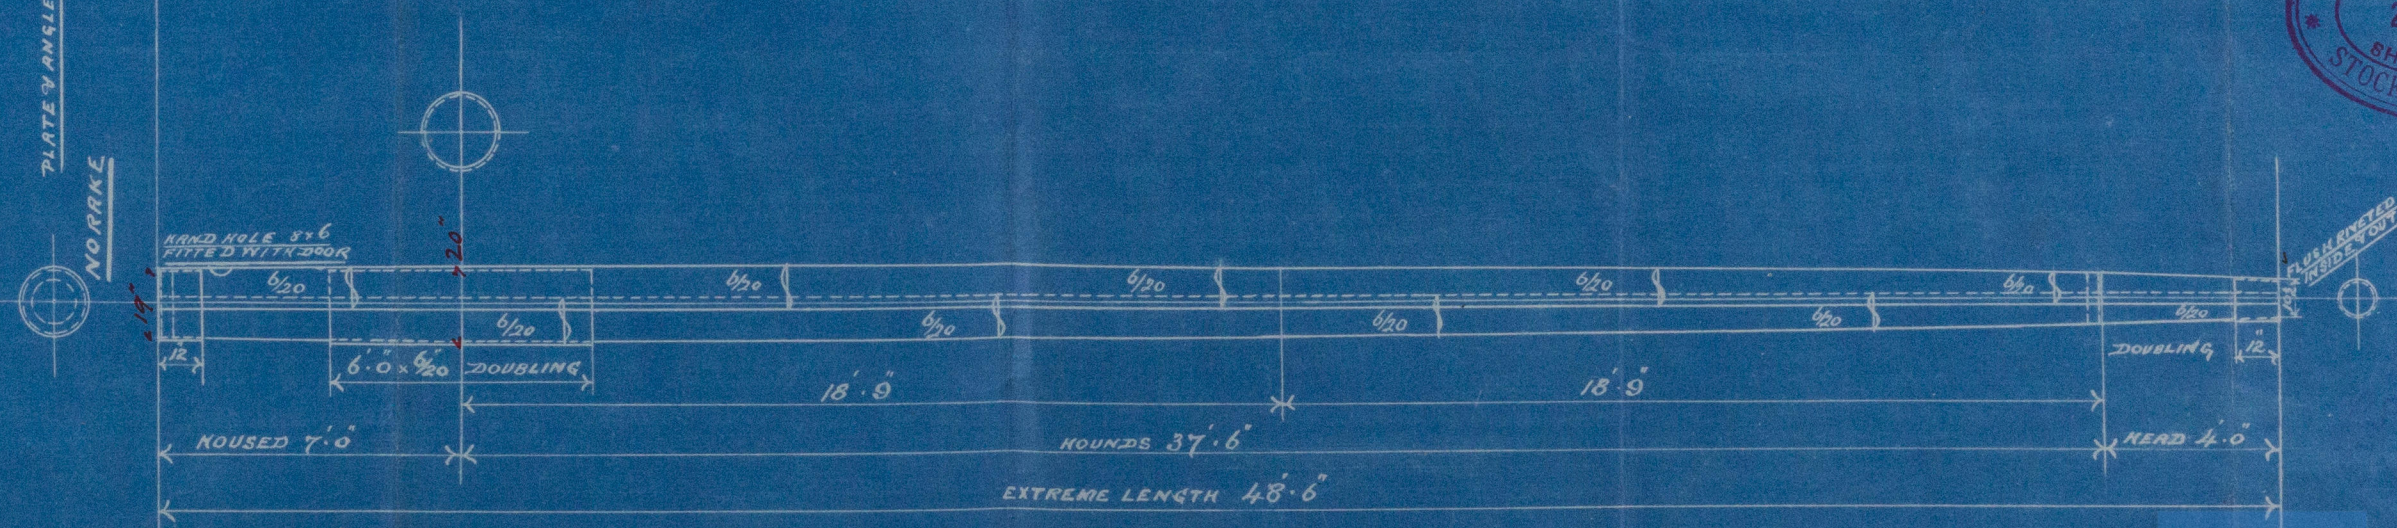

No 354 & 5

27-9-98

MDB761-0085