

For the information of Surveyors and the Committee only.

Received at *Middlesbrough* Office. *5th May* 1899

Lloyd's Register of British and Foreign Shipping.

Middlesbrough (Report on Vessel No. _____ Port *Wab.*)

No. *3911 a* SHIP FORGINGS OR CASTINGS.

I have to report that the undermentioned Iron or Steel Forgings or Castings, manufactured by *Messrs. Reid Wroughton & Co.* of *Stockton* for the Vessel No. *503*, being built by *Messrs. Richardson Duck & Co.* of *Stockton* have been inspected by me as set forth below, and found to be, so far as can be seen, *Sound*

Mark on Forgings.

Lloyd's

No. *3911 a*



10 to

Wm. Cannon

Sunderland
4/5/99

	STERN FRAME.	RUDDER FRAME.	STEM.
Material*	<i>Scrap</i>	<i>Scrap</i>	<i>Scrap</i>
How made	<i>Forged</i>	<i>Forged</i>	<i>Forged</i>
Dimensions	<i>11" x 6"</i>	<i>8 1/2" x 4 1/4"</i>	<i>10 1/2" x 2 3/4"</i>
Progress on Inspection	<i>Forged & Smithed</i>	<i>Forged & Smithed</i>	<i>Forged</i>
Date when Inspected	<i>Oct 4th to Nov 11/98</i>	<i>Jan 5th to March 16/99</i>	<i>Oct 28/98</i>

SKETCHES OF FRAMES SHOWING POSITION AND DESCRIPTION OF WELDS OF FORGINGS, OR PARTICULARS OF TESTS APPLIED TO CASTINGS.

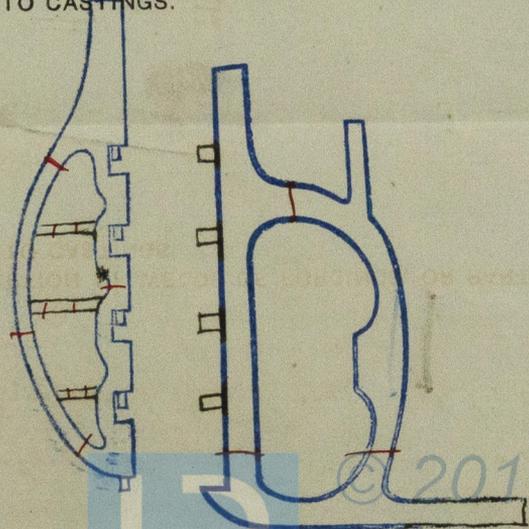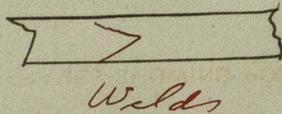

Fee (if any chargeable) £ : :

To be paid at _____

* If of Iron, state whether scrap or puddled Iron.