

J. Oramley
Lloyd's Register of British and Foreign Shipping.

Received at *Middlesbrough* office. *26th April 1909*

Middlesbrough (Report on Vessel No. *2668* Port *Mdb.*)

No. *3926 a* SHIP FORGINGS OR CASTINGS.

I have to report that the undermentioned Iron or Steel Forgings or Castings, manufactured by *The Sunderland Forge Co* of *Pallion* for the Vessel No. *63*, being built by *Messrs Craig Taylor & Co.* of *Stockton* have been inspected by me as set forth below, and found to be, so far as can be seen, *sound*

The words FORGINGS or CASTINGS, IRON or STEEL, should be struck out as may be required.



Mark on Forgings.

Lloyd's
No. *3926 a*
N. 6

Wm H. Barnum
Sunderland
25/4/99

	STERN FRAME.	RUDDER FRAME.	STEM.
Material*	<i>Scrap</i>	<i>Scrap</i>	<i>Scrap</i>
How made	<i>Forged</i>	<i>Forged</i>	<i>Forged</i>
Dimensions	<i>11 x 6 3/4</i>	<i>9 1/2 - 14 3/4</i>	<i>11 x 2 7/8</i>
Progress on Inspection	<i>Forged & Smithed</i>	<i>Forged & Smithed</i>	<i>Forged</i>
Date when Inspected	<i>Oct 1/98 to Feb 3/99</i>	<i>March 10th to April 18/99</i>	<i>Dec 17/98</i>

SKETCHES OF FRAMES SHOWING POSITION AND DESCRIPTION OF WELDS OF FORGINGS, OR PARTICULARS OF TESTS APPLIED TO CASTINGS.

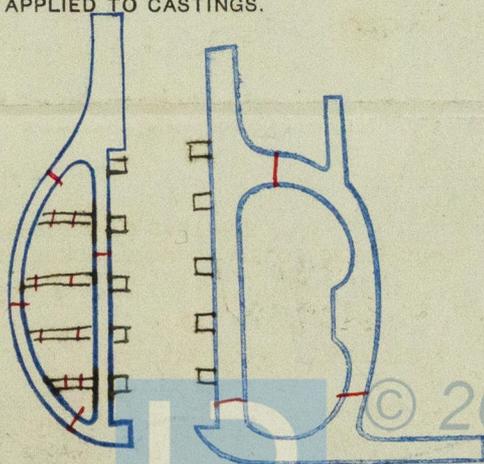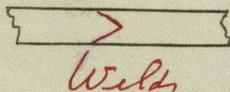

Fee (if any chargeable) £

To be paid at

* If of Iron, state whether scrap or puddled Iron.