

MIDDLESBROUGH-ON-TEES.

© 2020

To be returned for guidance
during construction of
sister vessel


2/2

Rfr
5.11.97
(1763) 4.8.98

S.S. N^o 56

PUMPING ARRANGEMENT

SCALE 1/4" INCH = 1 FOOT

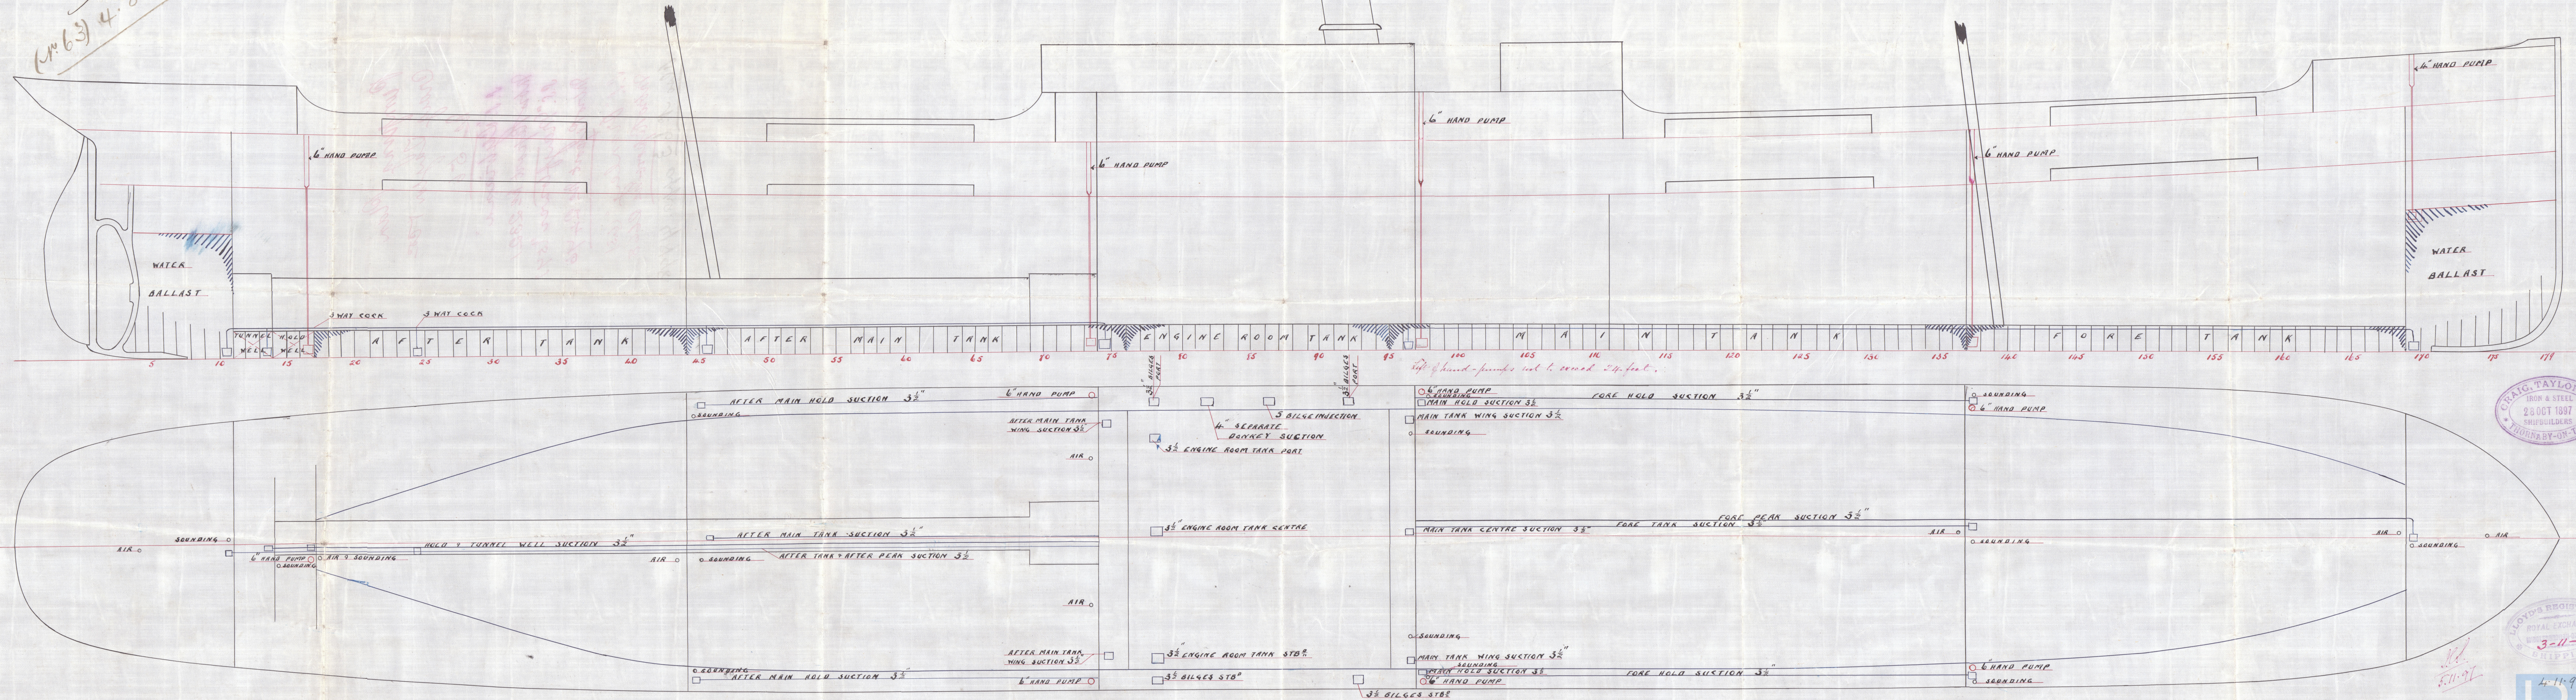

4.11.97
TRACING N^o 4326
Lloyd's Register Foundation

Pumping Plan
Craig Taylor & Co

No 56

S.S. "Cylwiana"

Metro Report No 2321

S.S. "Maryflower" (54)

Metro Report No 2476

S.S. "Orinley" (63)

Metro Report No 2668

Also No 63 appx. 4898.

MD8 763-0074



© 2020

Lloyd's Register
Foundation