

The words FORGINGS or CASTINGS, IRON or STEEL, should be struck out as may be required.

Lloyd's Register of British and Foreign Shipping.

(Report on Vessel No. \_\_\_\_\_ Port \_\_\_\_\_)

No. 33.A. SHIP FORGINGS OR CASTINGS.

I have to report that the undermentioned Iron or Steel Forgings or Castings, manufactured by Messrs J Raimbidge & Co of Pallion for the Vessel No. 90, being built by Messrs J & B Smith of Newcastle have been inspected by me as set forth below, and found to be, so far as can be seen, sound and efficient.


Mark on Forgings.

Lloyd's  
No. 33.A.  
H.C.

H. Cameron,  
Sunderland.

	STERN FRAME.	RUDDER FRAME.	STEM.
Material* - - - -	<u>Scrap Iron</u>	<u>Scrap Iron</u>	<u>Scrap Iron</u>
How made - - - -	<u>Forged</u>	<u>Forged</u>	<u>Forged</u>
Dimensions - - - -	<u>6" x 2 1/2"</u>	<u>3 1/2" - 2"</u>	<u>6" x 1 1/4"</u>
Progress on Inspection -	<u>Forged &amp; smithed</u>	<u>Forged &amp; smithed</u>	<u>Forged</u>
Dates when Inspected {	<u>March 31 April 3-9-18</u> <u>23-28/84</u>	<u>April 3-9-18-23-28/84</u>	<u>April 28/84</u>

SKETCHES OF FRAMES SHEWING POSITION AND DESCRIPTION OF WELDS OF FORGINGS, OR PARTICULARS OF TESTS APPLIED TO CASTINGS.

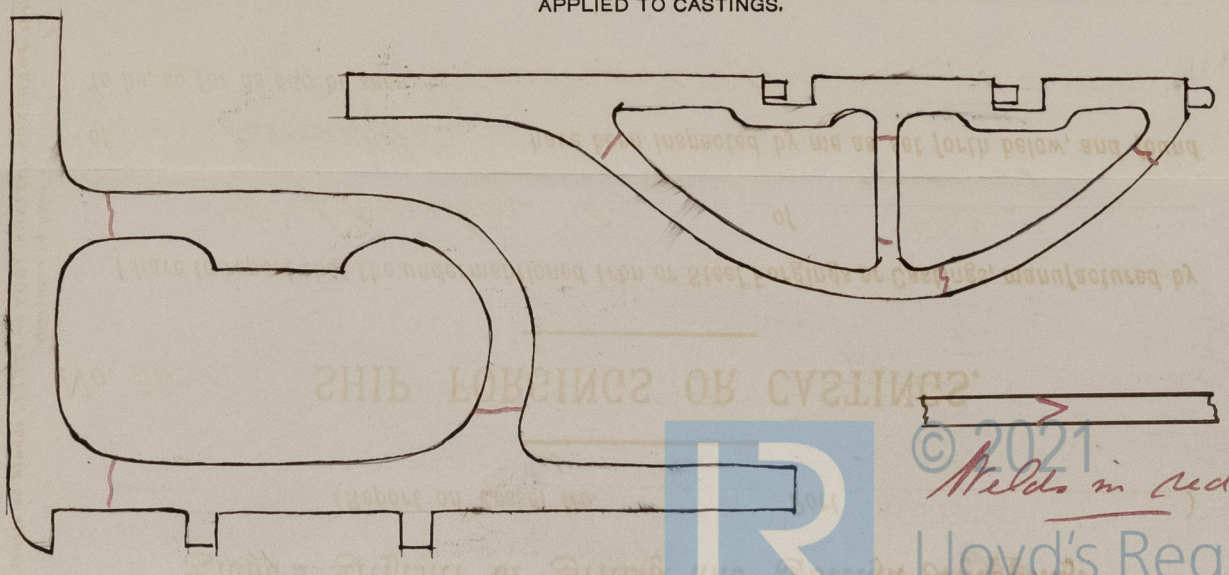

© 2021  
Welds in red  
Lloyd's Register  
Foundation

\* If of Iron, state whether scrap or puddled iron.



Yew. Sautles No. 90  
ss. "Basic"  
Nwc. Report No. 17943



© 2021

Lloyd's Register  
Foundation