

1573/98

The words FORGINGS or CASTINGS, IRON or STEEL, should be struck out as may be required.

*Recd*

# Lloyd's Register of British and Foreign Shipping.

(Report on Vessel No. 21546 Port Newcastle)

No. 681a.

## SHIP FORGINGS OR CASTINGS.

I have to report that the undermentioned Iron or ~~Steel~~ Forgings or ~~Castings~~, manufactured by

Messrs R & W Hawthorn Leslie & Co. of Newburn  
for the Vessel No. 279, being built by Messrs R & W Hawthorn Leslie & Co.  
of Newburn have been inspected by me as set forth below, and found  
to be, so far as can be seen, sound.

Mark on Forgings.

Lloyd's  
No. 681a  
No. C.


Rough Cameron

Sunderland

13/3/88

	STERN FRAME. <i>Port</i>	RUDDER FRAME.	STEM.
Material*	<i>Scrap iron</i>	<i>Scrap iron</i>	<i>Scrap iron</i>
How made	<i>Fayed</i>	<i>Fayed</i>	<i>Fayed</i>
Dimensions	<i>8 1/2 x 5</i>	<i>6 1/4 - 3 1/4</i>	<i>8 1/2 x 2 1/2</i>
Progress on Inspection	<i>Fayed Smoothed</i>	<i>Fayed Smoothed</i>	<i>Fayed</i>
Dates when Inspected	<i>Sept 8-14-19-24 Oct 14/87</i>	<i>Dec 12-15-28/87 Jan 20 31 Feb 3-7-8-13-18/88</i>	<i>Sept 19/87</i>

SKETCHES OF FRAMES SHEWING POSITION AND DESCRIPTION OF WELDS OF FORGINGS, OR PARTICULARS OF TESTS APPLIED TO CASTINGS.

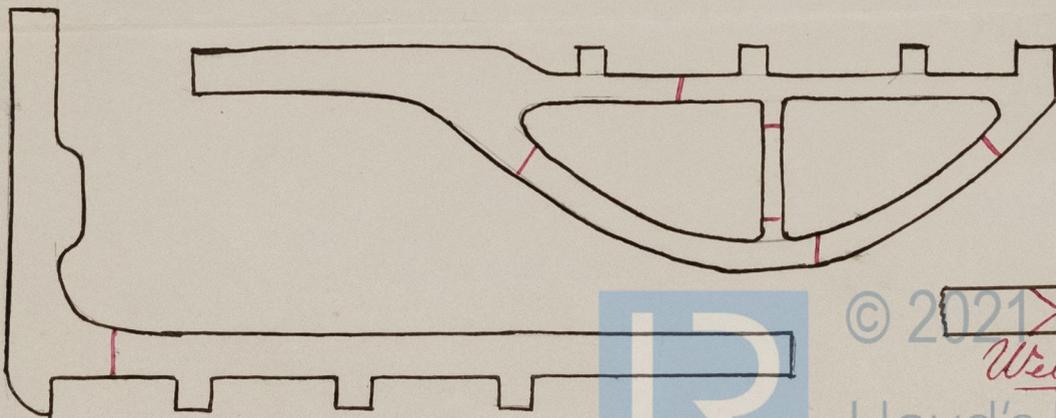

© 2021  
*Welds*

Lloyd's Register  
Foundation

\* If of Iron, state whether scrap or puddled iron.

681

Hawthorn Leslie & Co  
No 249



© 2021

Lloyd's Register  
Foundation