


~ S.S. №49 ~

ELEVATION

— SCALE $\frac{1}{8}$ IN = 1 FT. —

TO CLASS 100-A.1 AT LLOYDS

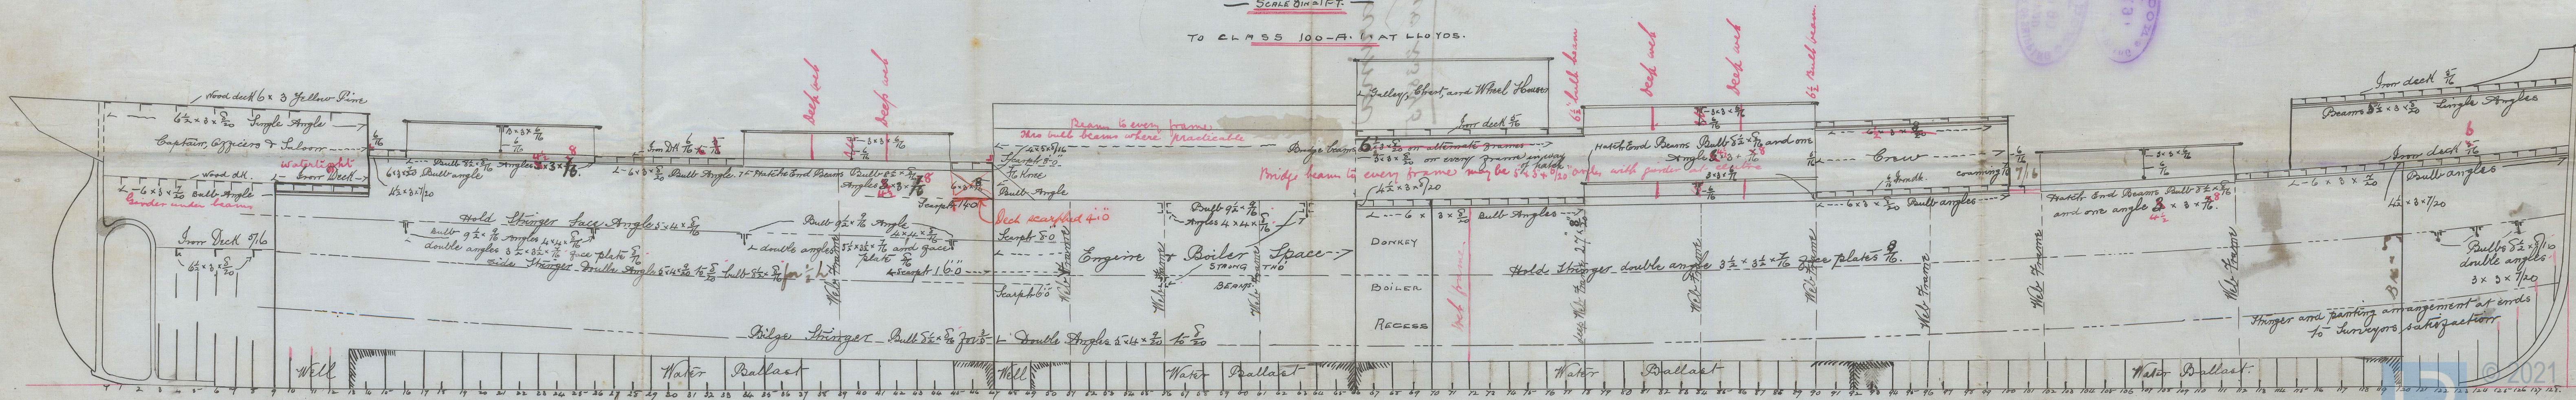

1/8/89

Tracing No. 24.
24/7/89

28 FEB. 91
LLOYDS LONDON

© 202

Lloyd's Register
Foundation