


SCALE $\frac{1}{2}'' = 1 \text{ FOOT.}$

CLASS 100 A.I. AT LLOYDS.

$\frac{1}{2}$ GIATH 34.37 ✓
 $\frac{1}{2}$ Beam 18.00 ✓
 Depth $\frac{19.91}{72.28} \cdot 1^{\frac{1}{2}}$ ✓
 $72.28 \times 258.59 = 18690.88 = 2^{\frac{1}{2}}$ ✓

$$\begin{array}{rcl} B \text{ to } L & = & 7.18 \\ \underline{D \text{ to } L} & = & 12.9 \end{array}$$

Dimensions		
Length	B. P.	260.0
Breadth	extreme	36.2
Depth	moulded.	19.3
1 hold	to Sank Top	16.10 $\frac{1}{2}$

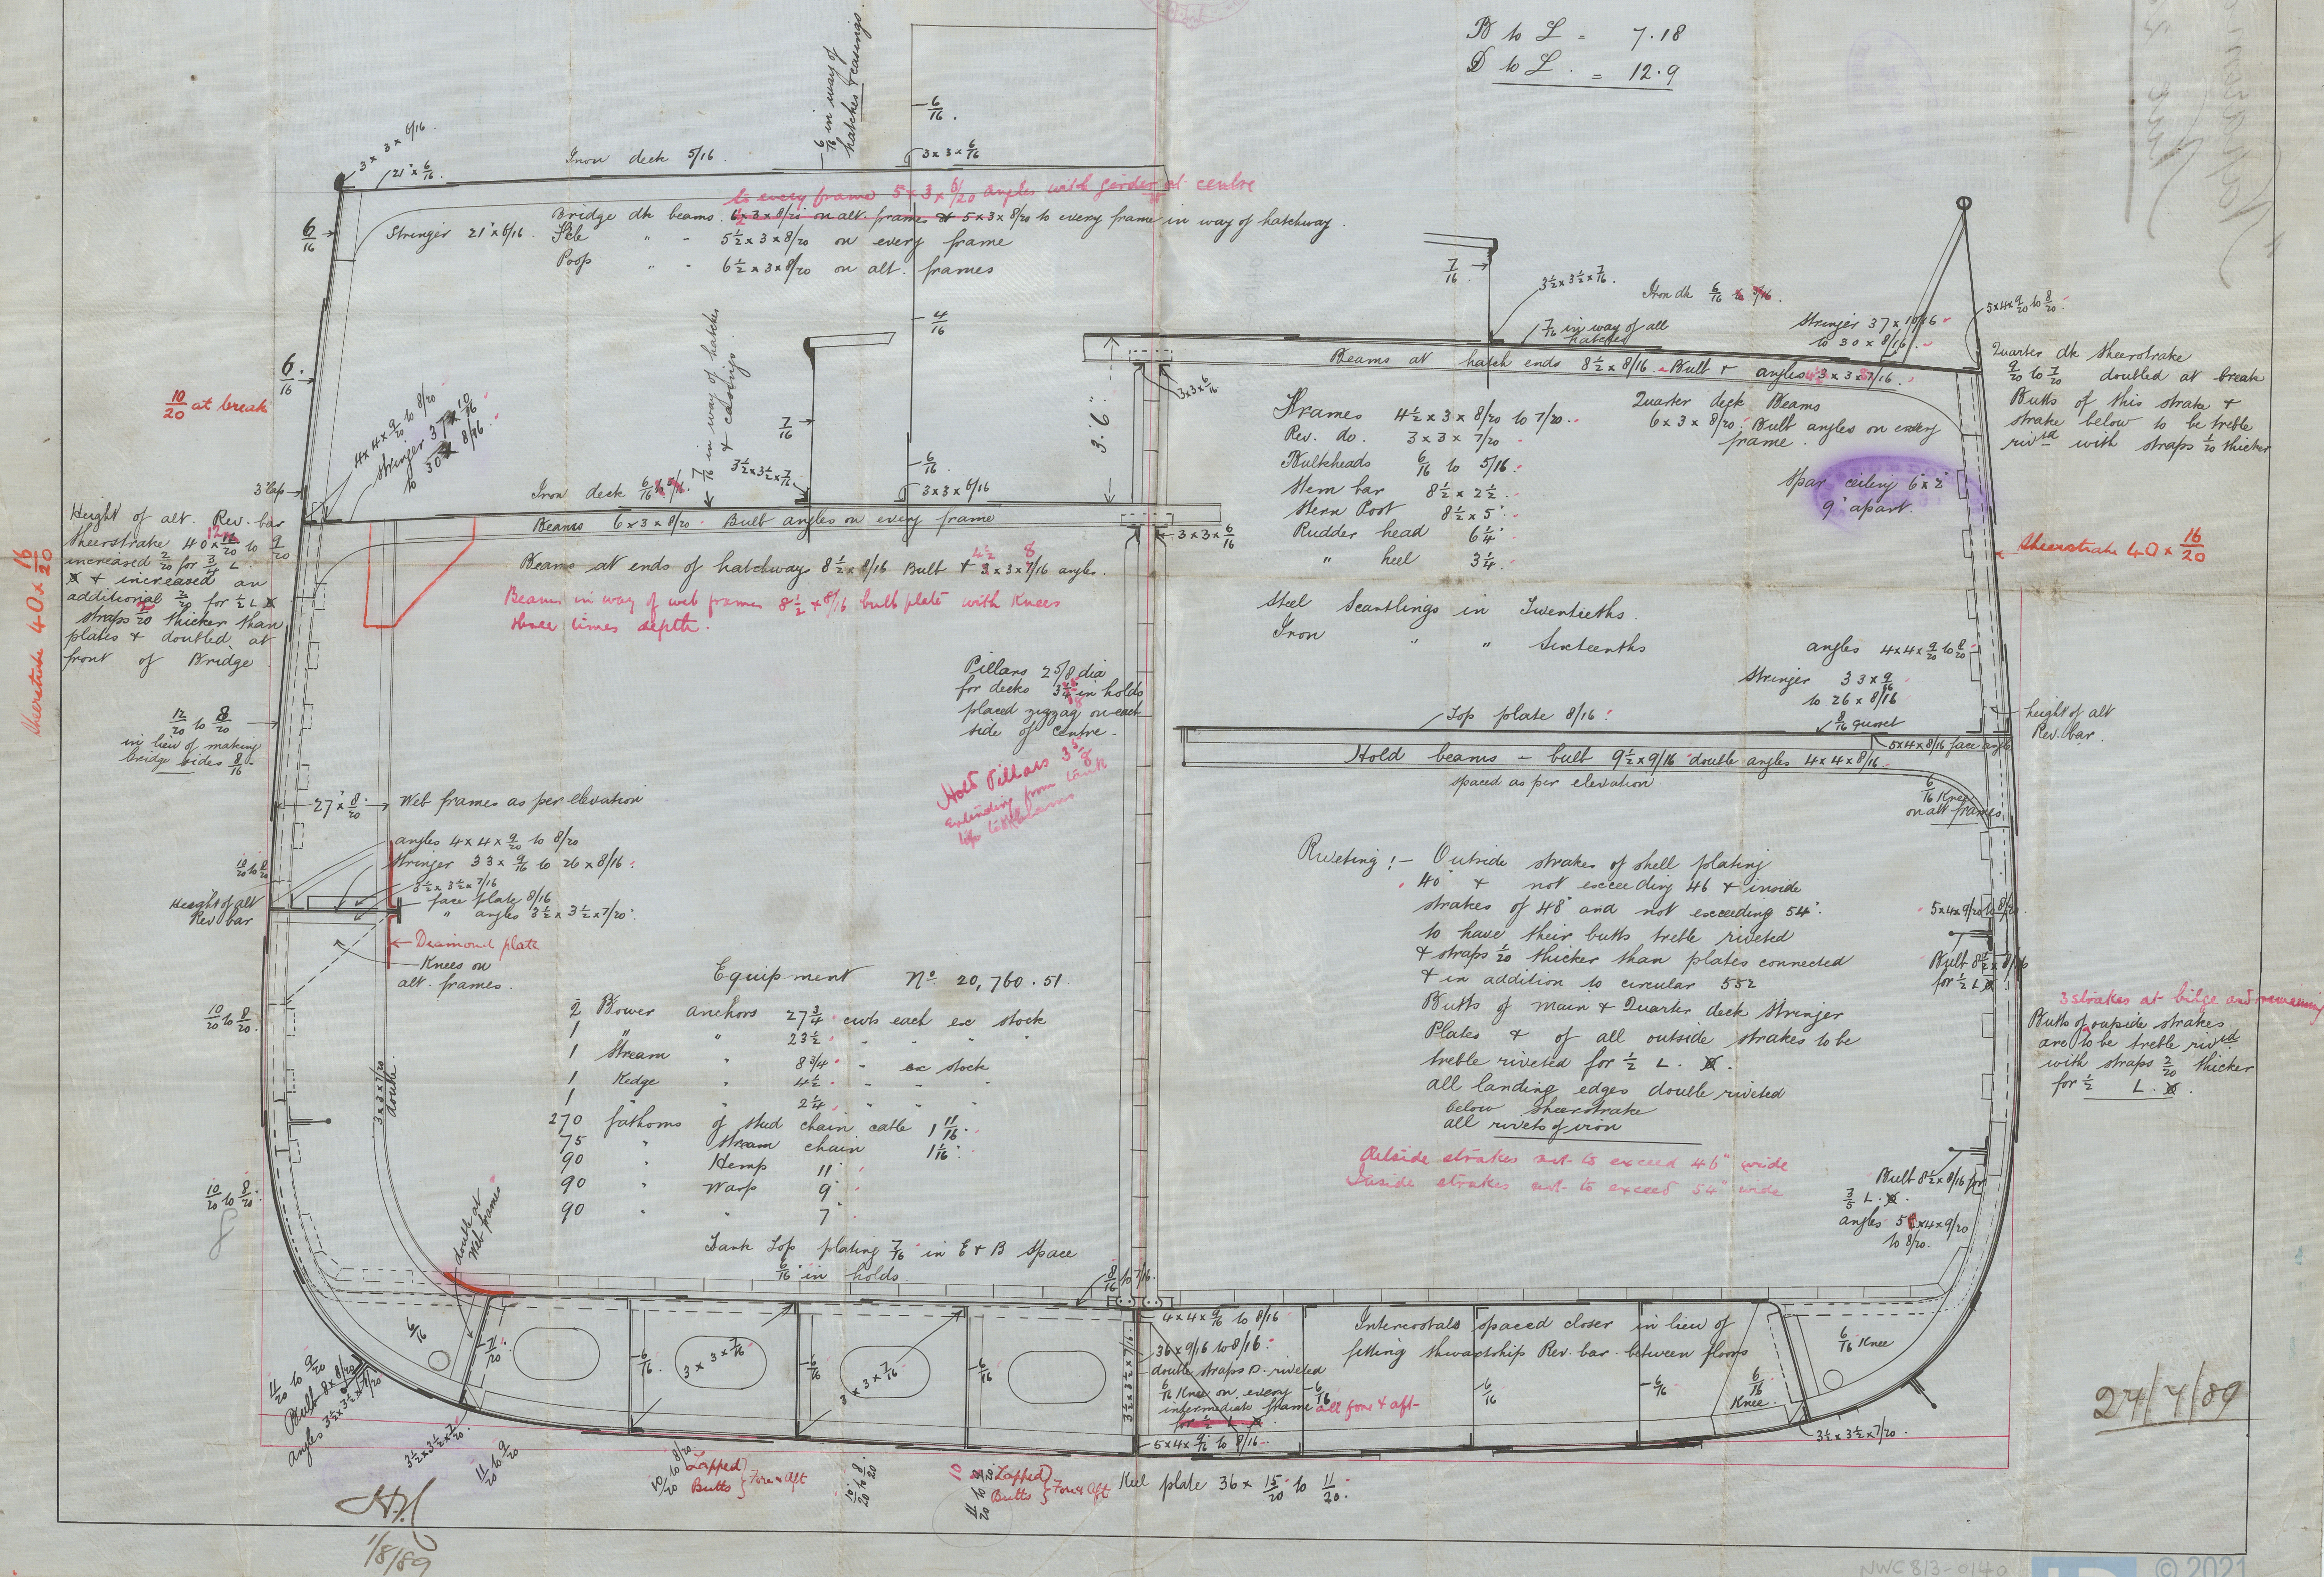

24/4/88



Lloyd's Register
Foundation

NWC813 - 0140