





Butt Straps of Spar Deck sheersake in way of doubling plate  
below deck double rivetted & above deck treble rivetted with straps  
 $\frac{3}{20}$  thicker; at ends double rivetted with straps  $\frac{2}{20}$  thicker.  
Shell joints on remaining strakes overlapped & treble rivetted  
all fore & aft.

NWL 832-0106 1/2







J. Readhead & Sons No. 290  
"Cayo Romano"

but forward a copy

No 21972

NWC ~~21972~~ 29 156

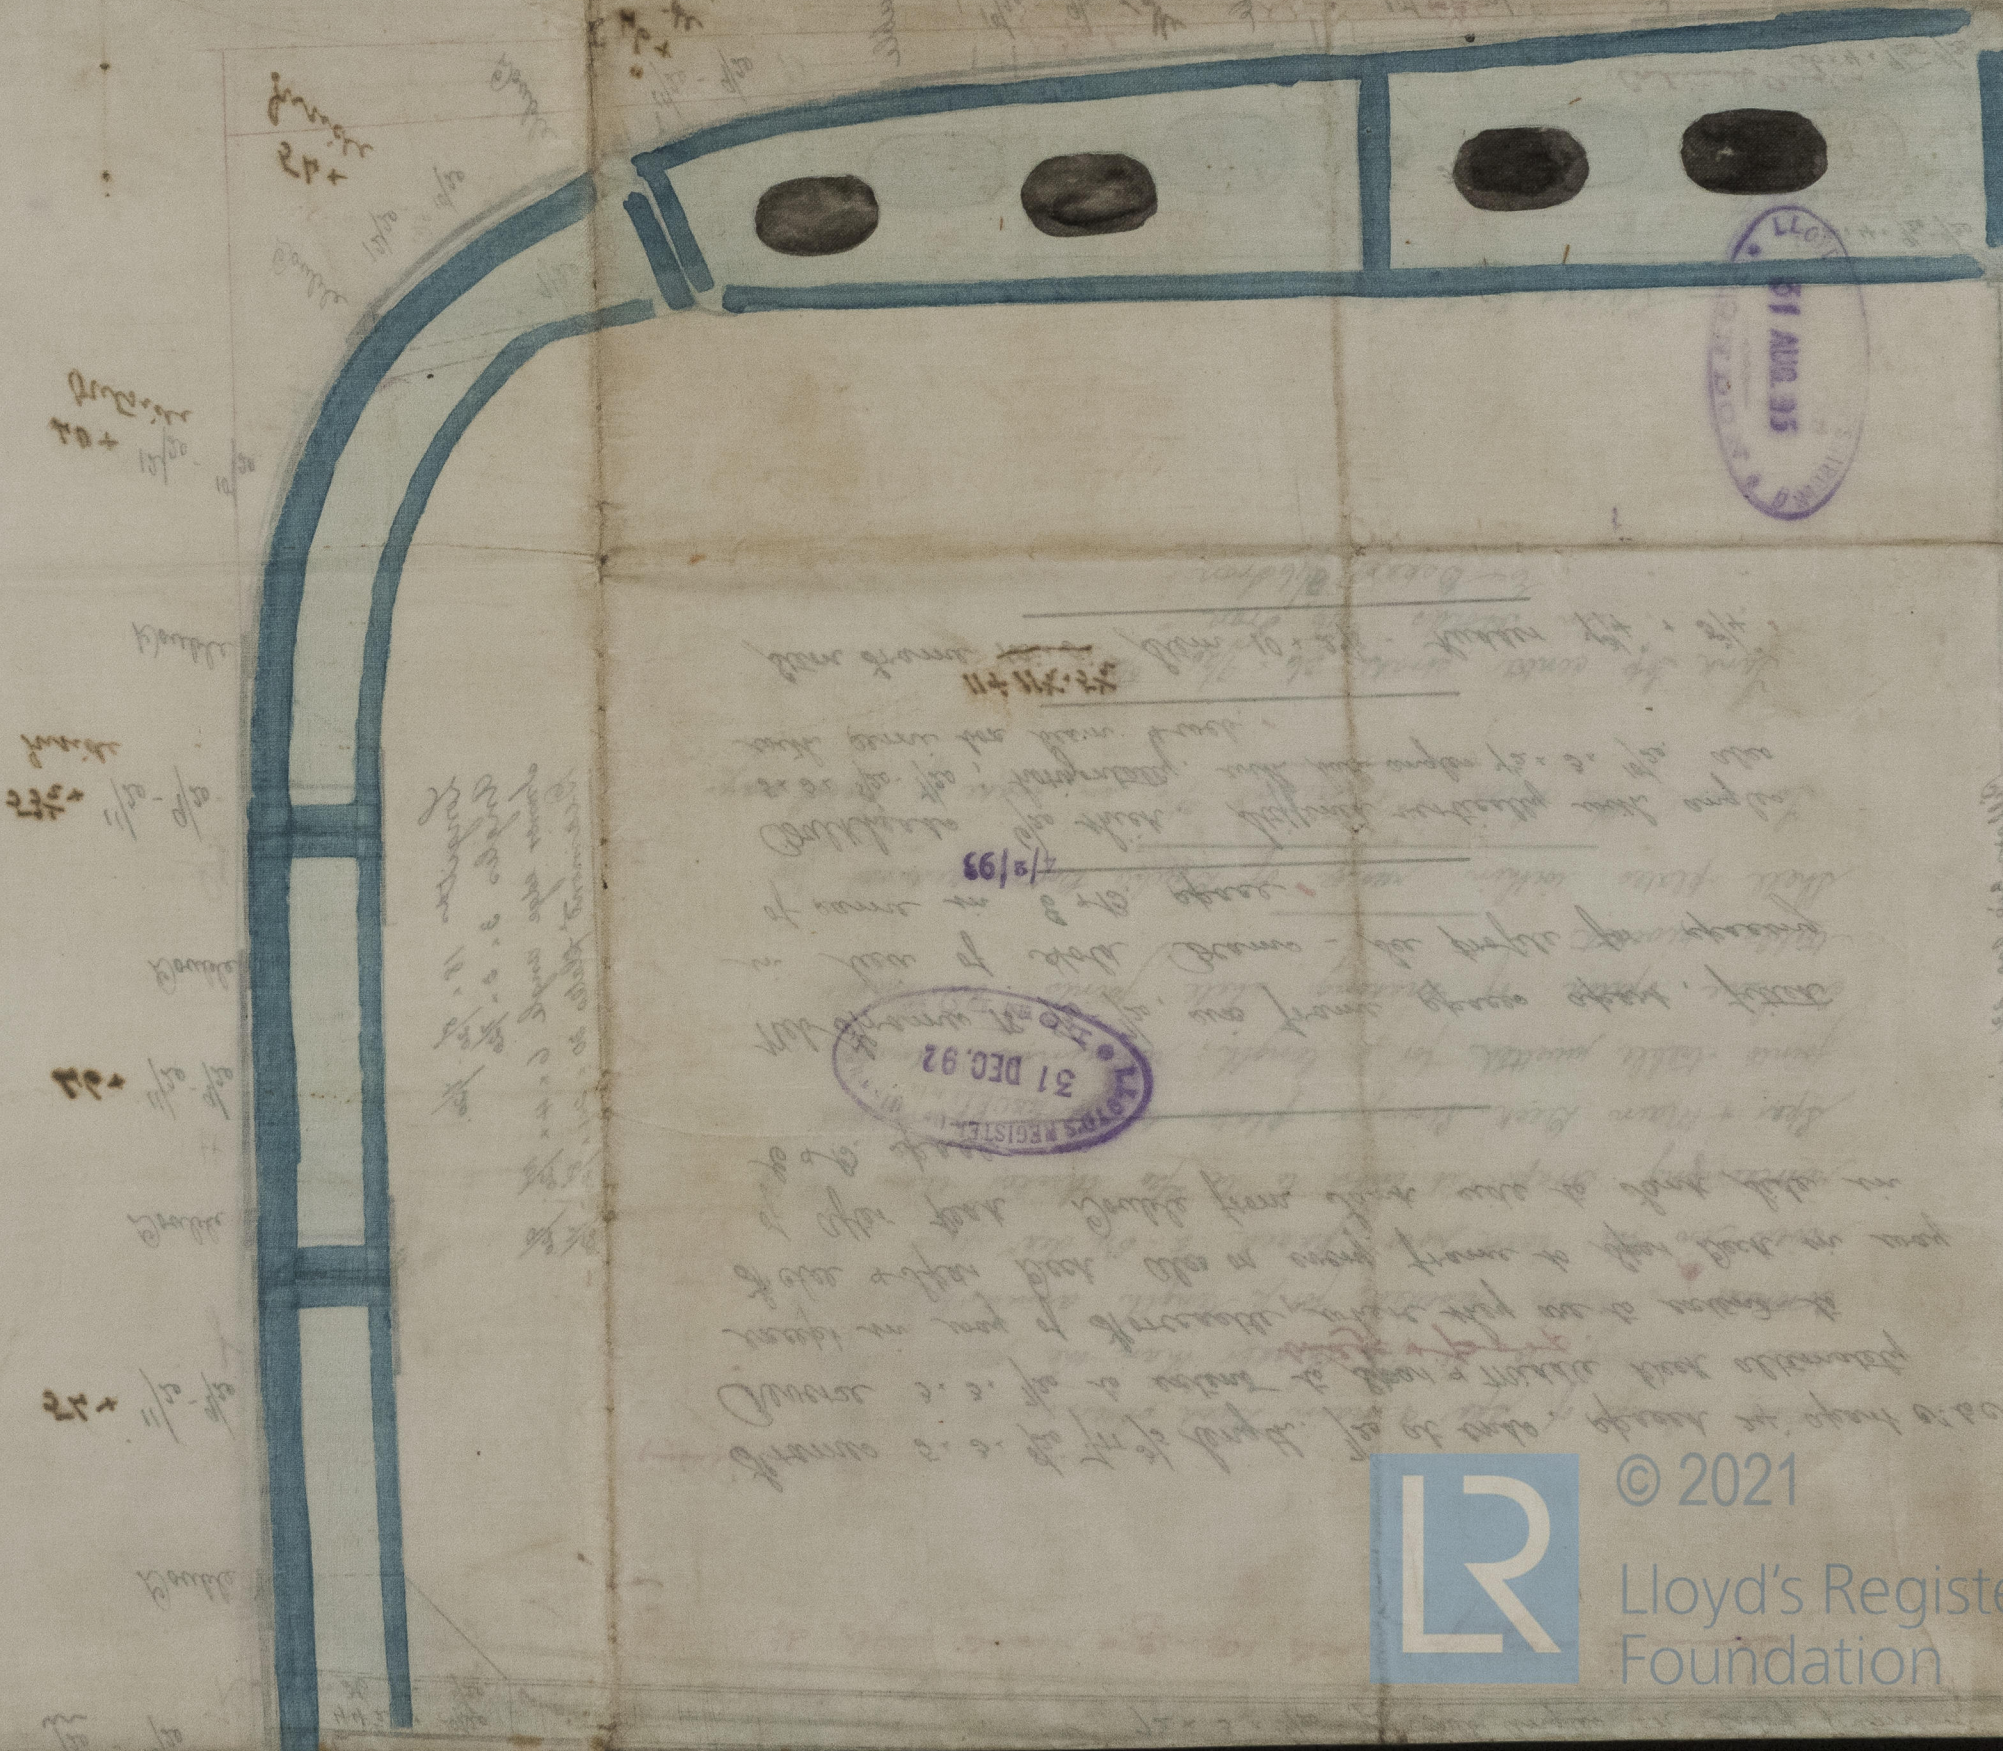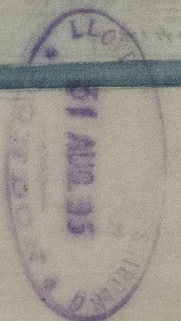 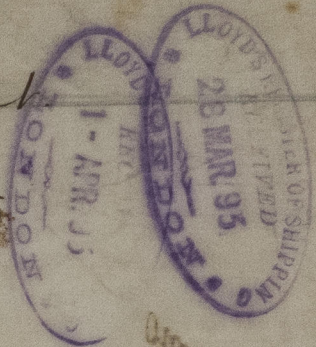


