
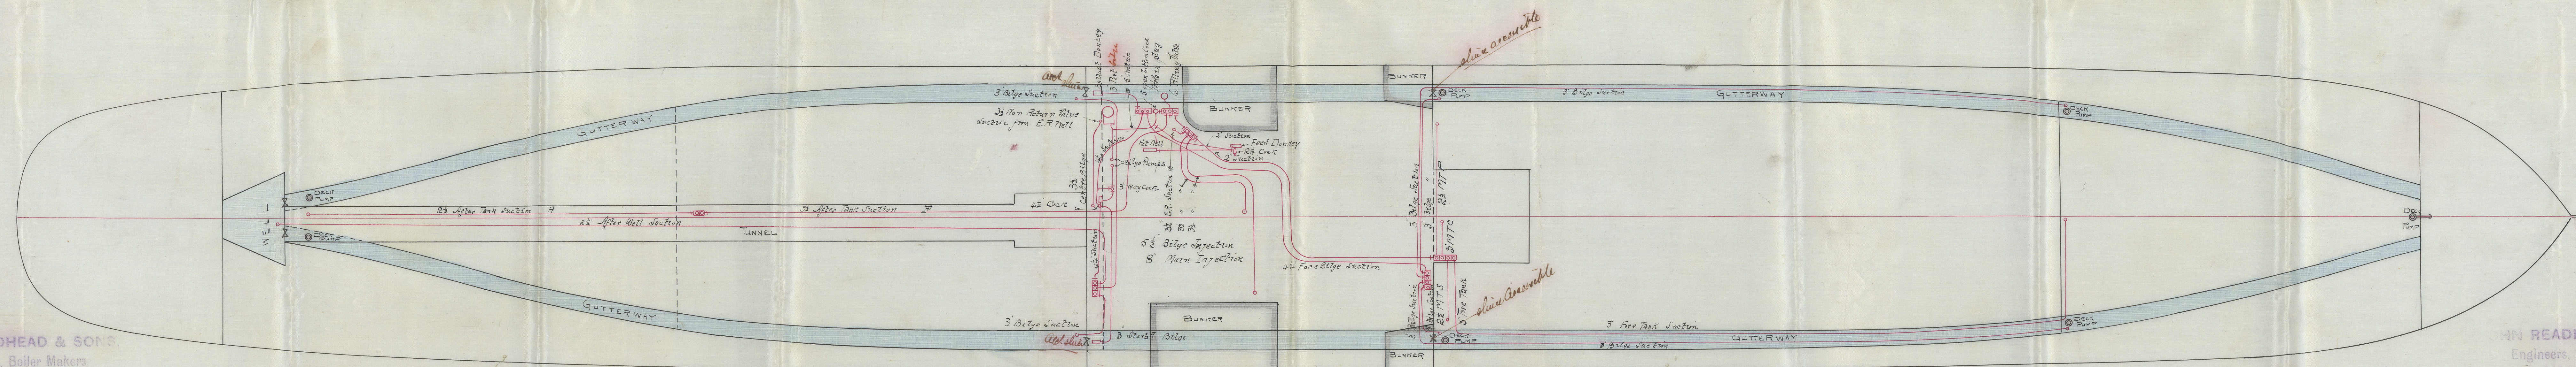


- Pumping Arrangement % N^o 290.

Tonnage U.D. 2539.67.

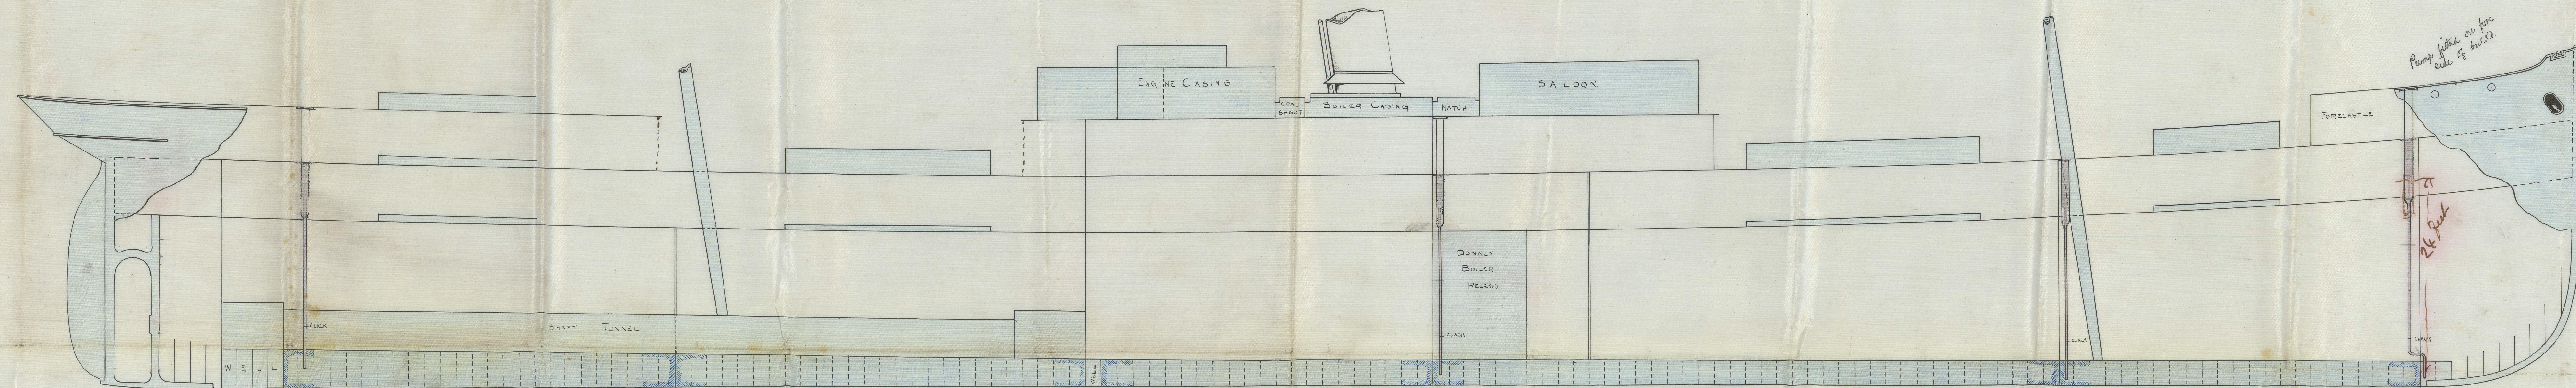

H. N. READHEAD & SONS,
Engineers, Boiler Makers,
Iron & Steel Shipbuilders,
SOUTH SHIELDS.

30/3/93

W.A.
44.93

no 290

"Largo Romano"


29156



*Pump fitted on fore
side of hull*

*60
D/H/B
5/6/2*

FORECASTLE

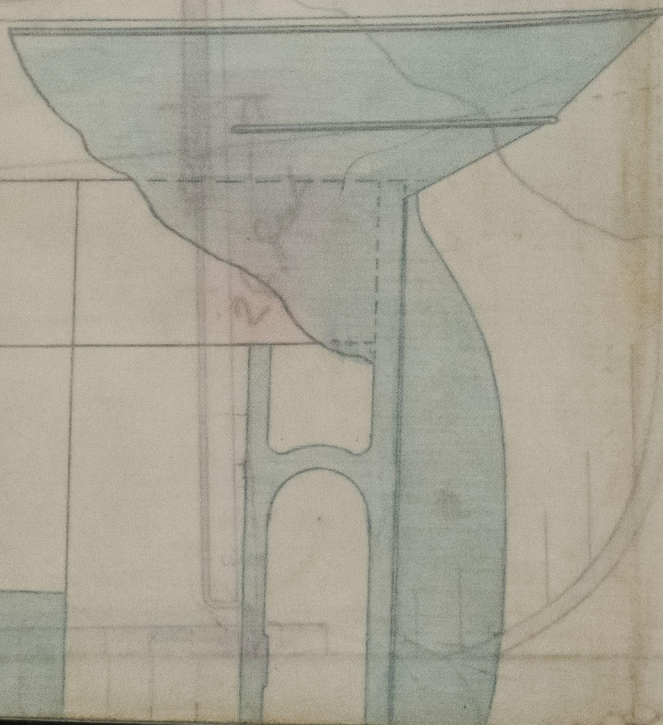

L010-2382MN



© 2021

Lloyd's Register
Foundation