


16.5.93




SECTION OF FRAME & LUG  
FOR BILGE KEELSON

— N<sup>o</sup> 189.  $\frac{1}{2}$  —

— FULL SIZE —

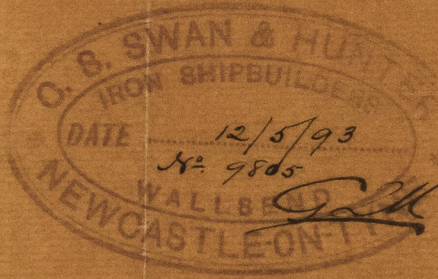

Recd from Lloyd's  
12.5.93  
800P

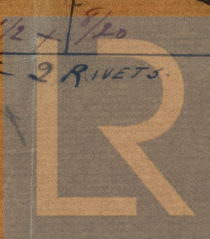

© 2021

Lloyd's Register  
Foundation



NW2832-0221



"Layo Mono"

have at the report

11/2/d3  
12/2/d3

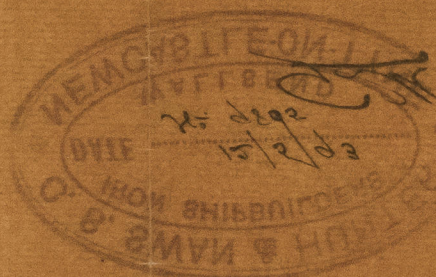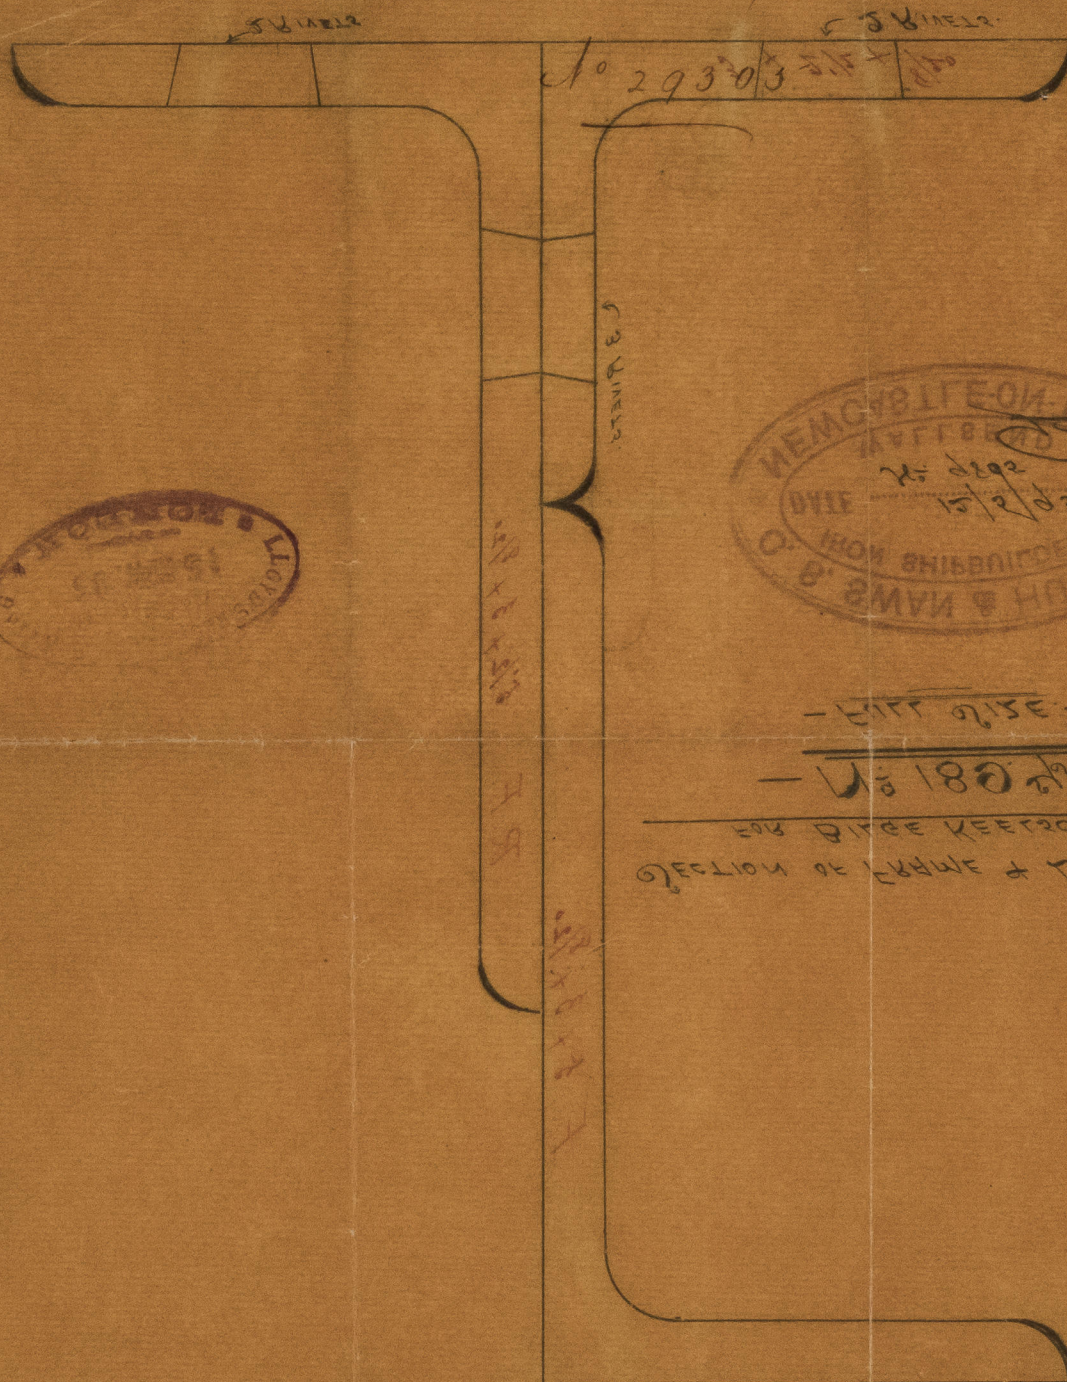




1720-288MM

1P-2-d3



© 2021

Lloyd's Register  
Foundation