
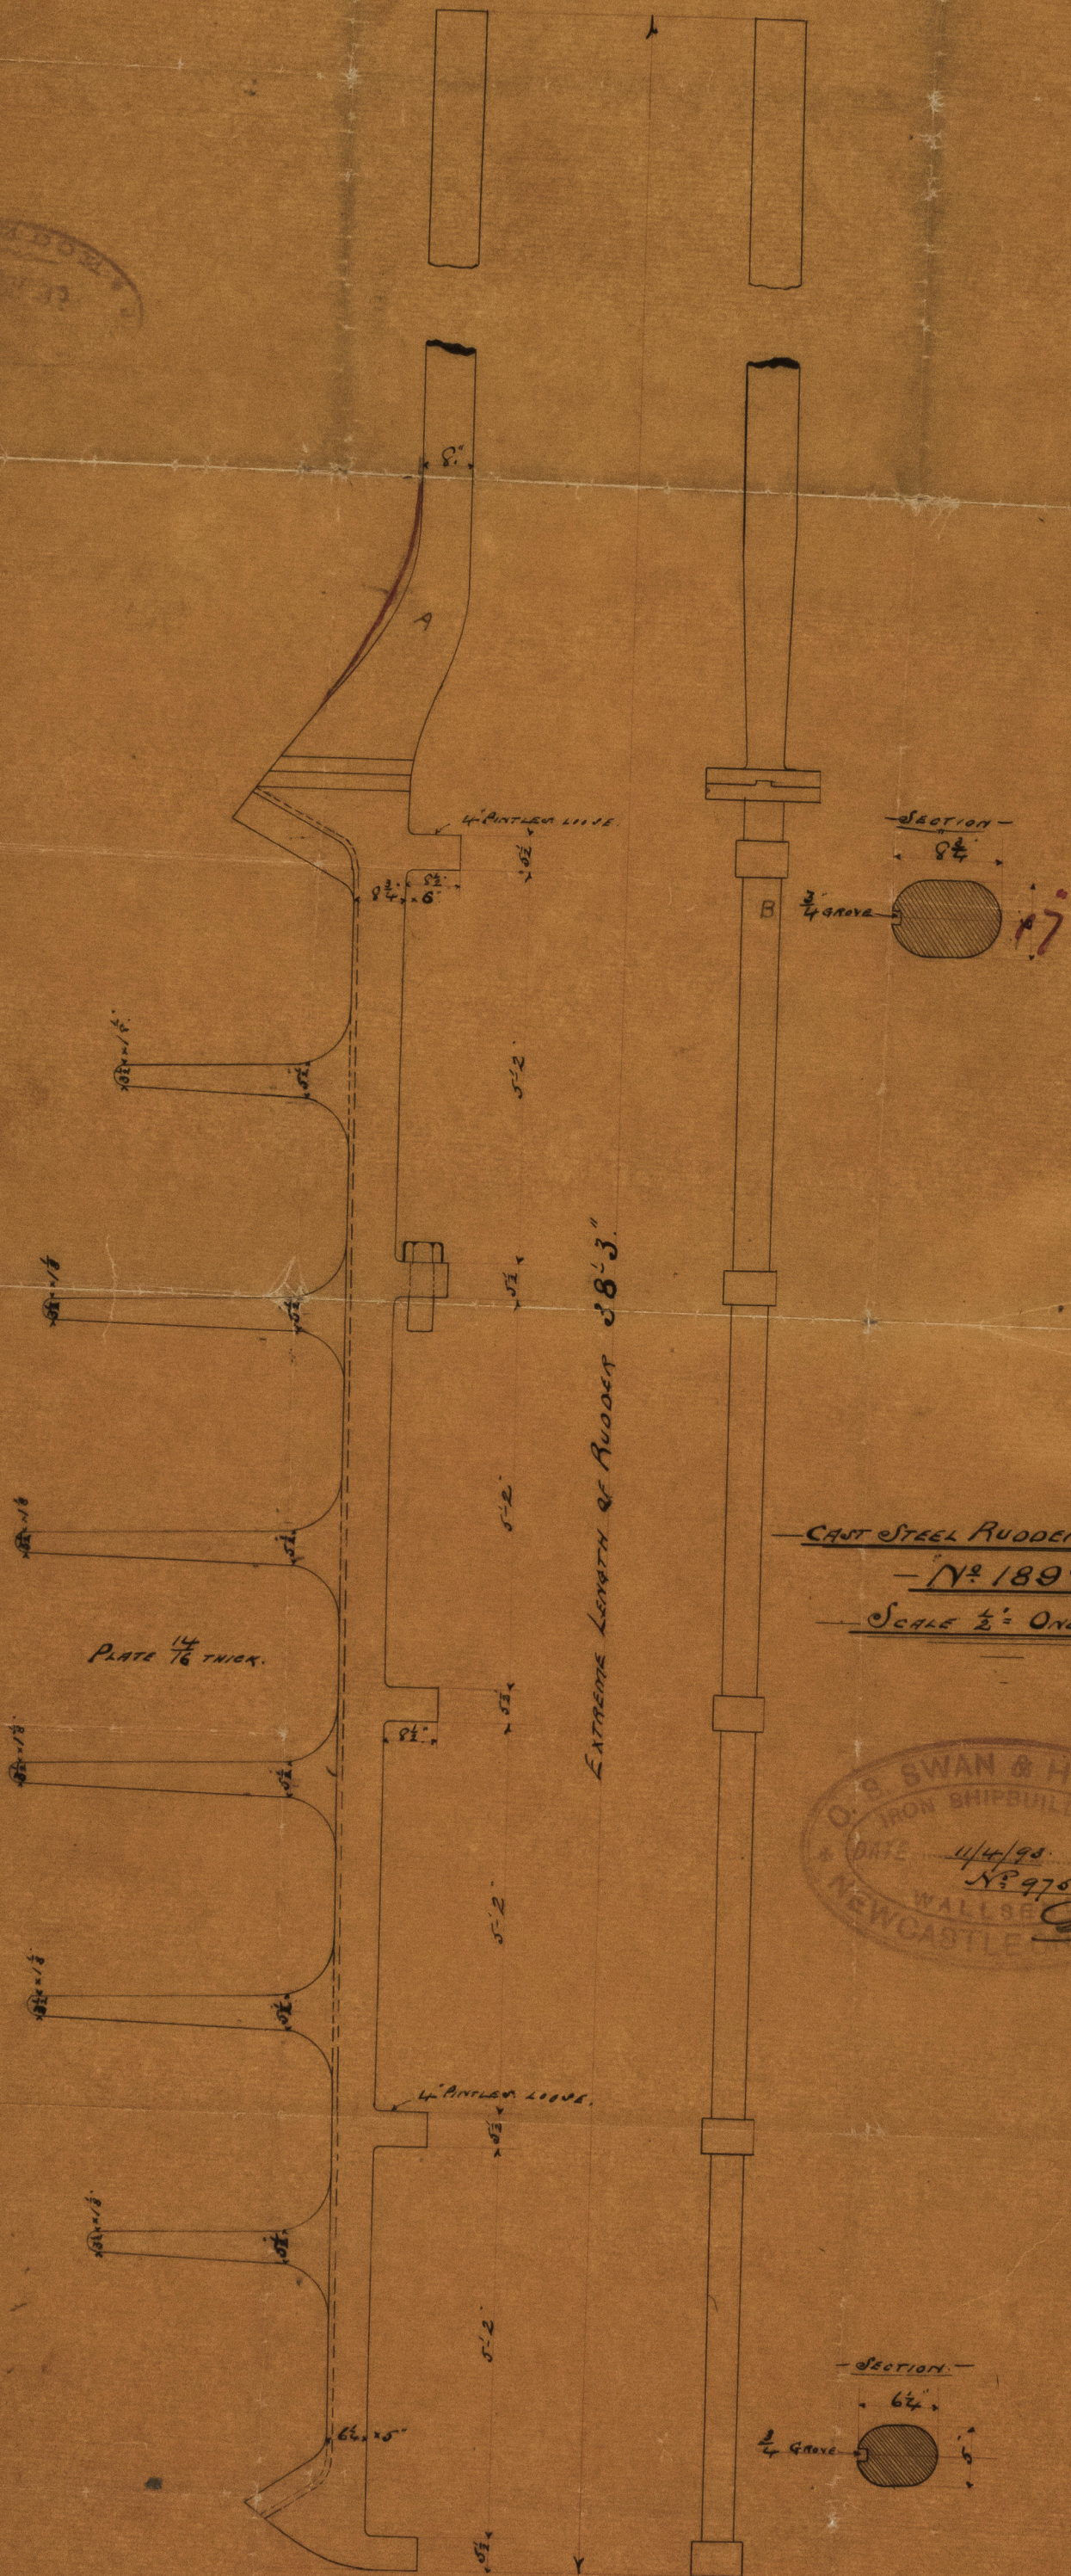



14.4.93

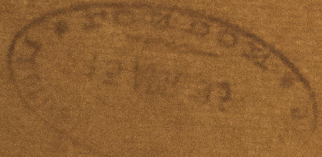

CAST STEEL RUDDER FRAME.

Nº 1894.

SCALE 1/2" = ONE FOOT.

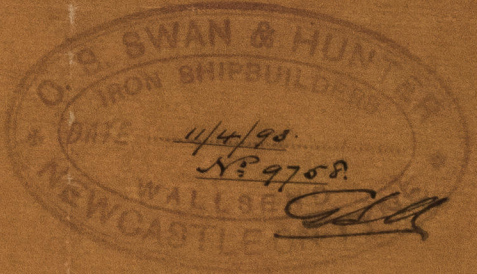

1009305





© 2021


Lloyd's Register
Foundation

5020-7687M

1000000

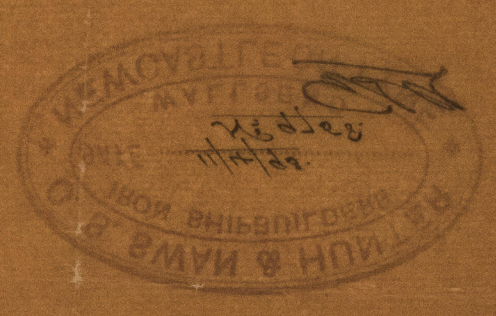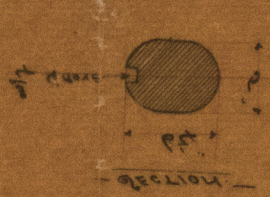


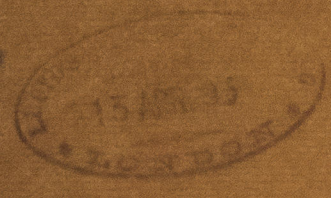




© 2021
 Lloyd's Register
 Foundation

NW1932-0225