

Lloyd's Register of British and Foreign Shipping.

(Report on Vessel No. 29666 Port NEWCASTLE-ON-TYNE)

No. 1769

SHIP FORGINGS OR CASTINGS.

The words FORGINGS or CASTINGS, IRON or STEEL, should be struck out as may be required.

I have to report that the undermentioned Iron ~~or Steel~~ Forgings ~~or Castings~~,
 manufactured by Messrs Emmerson Walker & Thompson
 of Dunston for the Vessel No. 155, being built
 by Messrs J P Rennoldson & sons of South Shields
 have been inspected by me as set forth below, and found to be, so far as can be seen,
Sound

Mark on Forgings.


Lloyd's
 No. 2783B
 96

John C Craig

Newcastle
 4/12/93

	STERN FRAME.	RUDDER FRAME.	STEM.
Material*	<i>Scrap Iron</i>	<i>Scrap Iron</i>	/
How made	<i>Forged</i>	<i>Forged</i>	
Dimensions	<i>6 1/4 - 3 1/4</i>	<i>3 3/4 - 2 1/4</i>	
Progress on Inspection	<i>Forged & Smithed</i>	<i>Forged & Smithed</i>	
Date when Inspected	<i>Aug 8-16 Sept 5-6/93</i>	<i>October 20 November 14/93.</i>	

SKETCHES OF FRAMES SHOWING POSITION AND DESCRIPTION OF WELDS OF FORGINGS, OR PARTICULARS OF TESTS APPLIED TO CASTINGS.

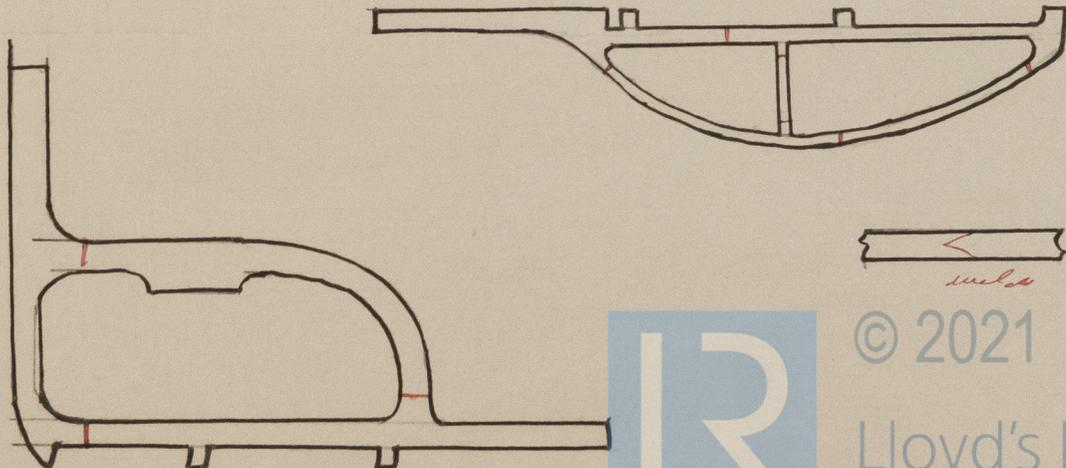

© 2021

Lloyd's Register
Foundation

Remondson

133-



© 2021

Lloyd's Register
Foundation