
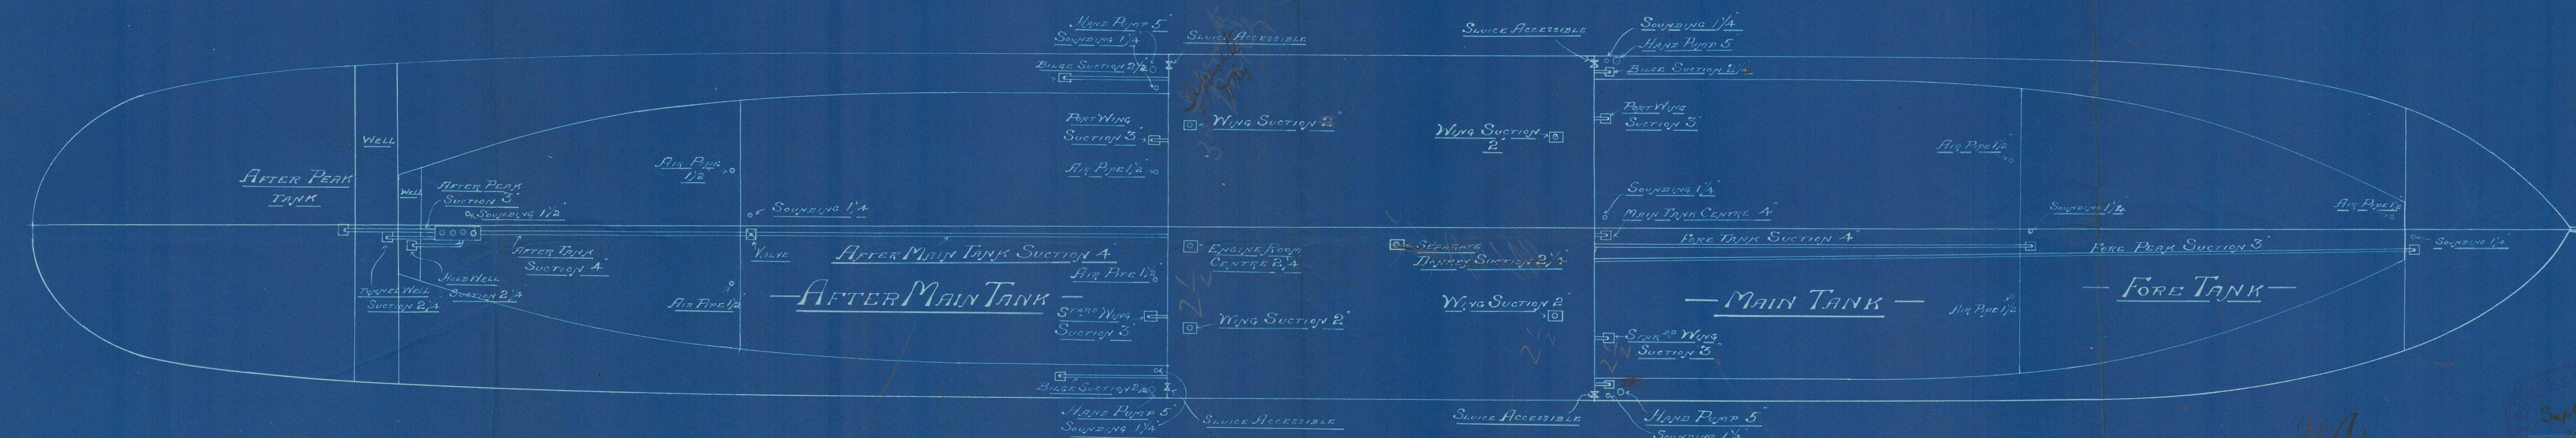



Ref 2: 10: 93

— PUMPING ARRANGEMENT —
 — S.S. N° 679 —
 — SCALE 1/8" = 1 FOOT —


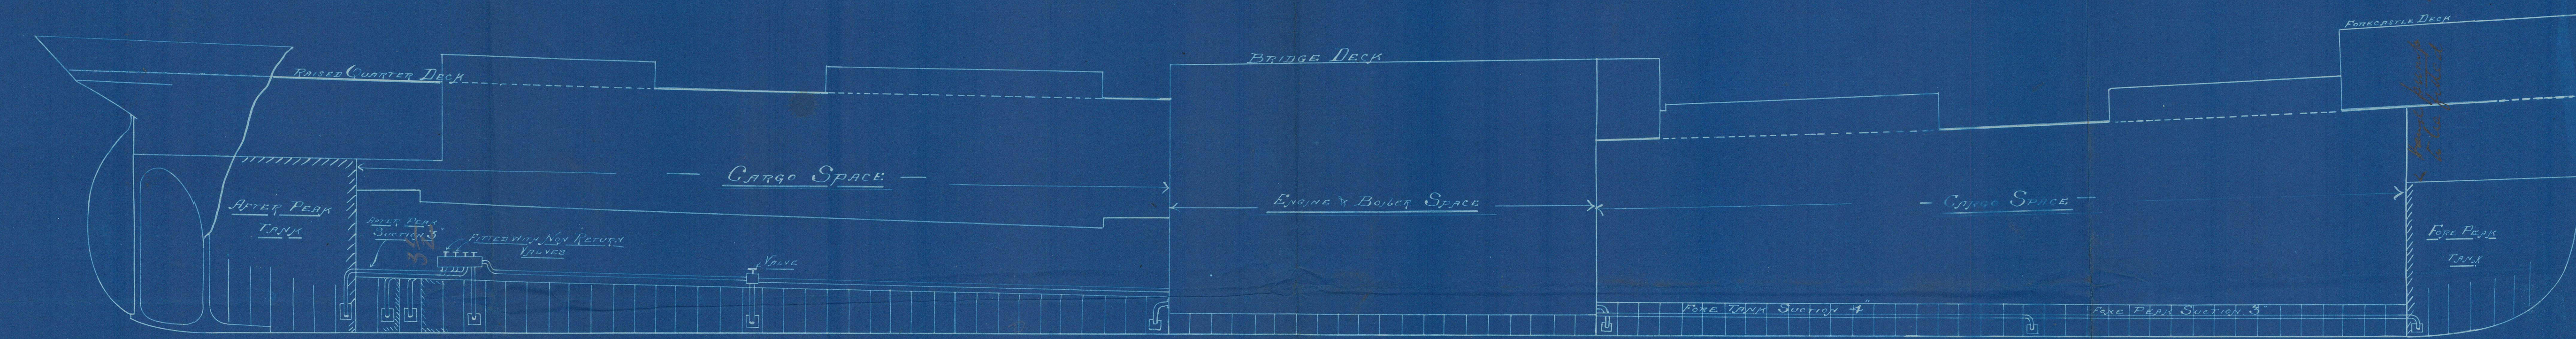


M.A.
2.10.93

Sept 25/93
 Lloyd's Register
 Founded 1825

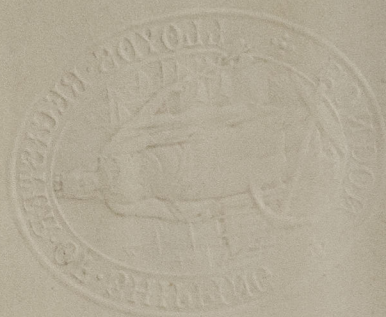

Pumping
No 679
S.S.
"Newark"

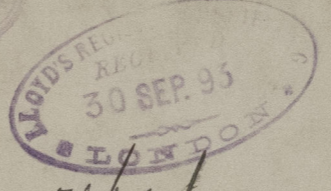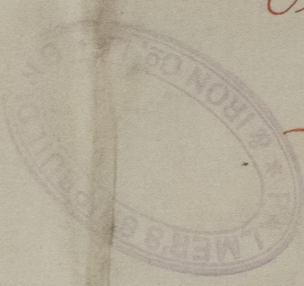

have report
No 29458.



© 2021

Lloyd's Register
Foundation

MLC835-0005