

Lloyd's Register of British and Foreign Shipping.

(Report on Vessel No. 29758 Port NEWCASTLE-ON-TYNE)

No. 1873 SHIP FORGINGS OR CASTINGS.

I have to report that the undermentioned Iron ~~or Steel~~ Forgings or Castings,
 manufactured by *The Palmers & Co*
 of *Jarrow* for the Vessel No. 672, being built
 by *The Palmers & Co* of *Jarrow*
 have been inspected by me as set forth below, and found to be, so far as can be seen,
sound

Mark on Forgings.

Lloyd's
No. 3063B


JB

John C Craig
Newcastle

9/1/84

	STERN FRAME.	RUDDER FRAME.	STEM.
Material*	Scrap Iron	Scrap Iron	
How made	Forged	Forged	
Dimensions	7 1/4 - 4 1/4	5 1/4 - 3	
Progress on Inspection	Smoothed & Finished	Forged & Smoothed	Not seen
Date when Inspected	October 11-17/83	Oct 11-17-27 Nov 8-28/83	

SKETCHES OF FRAMES SHOWING POSITION AND DESCRIPTION OF WELDS OF FORGINGS, OR PARTICULARS OF
 TESTS APPLIED TO CASTINGS.

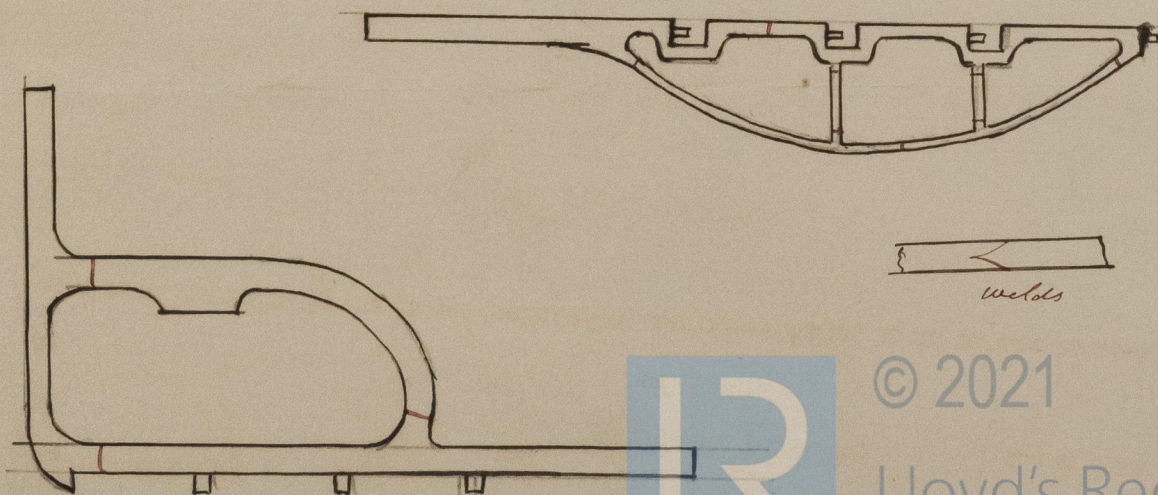

Palmer

679



© 2021

Lloyd's Register
Foundation