

"*Keenifred*"

Received at

Office,

# Lloyd's Register of British and Foreign Shipping.

(Report on Vessel No. *29933* Port *NEWCASTLE-ON-TYNE*)

No. *1766*

## SHIP FORGINGS OR CASTINGS.

The words FORGINGS or CASTINGS, IRON or STEEL, should be struck out as may be required.

I have to report that the undermentioned Iron ~~or Steel~~ Forgings ~~or Castings~~,  
manufactured by *Messrs Emmerson Walker & Thompson*  
of *Dunston* for the Vessel No. *156*, being built  
by *Messrs J P Remoldson & sons* of *South Shields*  
have been inspected by me as set forth below, and found to be, so far as can be seen,

Mark on Forgings.

Lloyd's

No. *2851B*

*JB*


*John B Craig*

*Newcastle*

*4/12/93*

	STERN FRAME.	RUDDER FRAME.	STEM.
Material*	<i>Scrap Iron</i>	<i>Scrap Iron</i>	/
How made	<i>Forged</i>	<i>Forged</i>	
Dimensions	<i>6 1/4 - 3 1/4</i>	<i>3 1/4 - 2 1/4</i>	
Progress on Inspection	<i>Forged &amp; Smothered</i>	<i>Forged &amp; Smothered</i>	
Date when Inspected	<i>Sept 5-11</i> <i>October 5-7</i>	<i>October 12-20</i> <i>November 14/93</i>	

SKETCHES OF FRAMES SHOWING POSITION AND DESCRIPTION OF WELDS OF FORGINGS, OR PARTICULARS OF TESTS APPLIED TO CASTINGS.

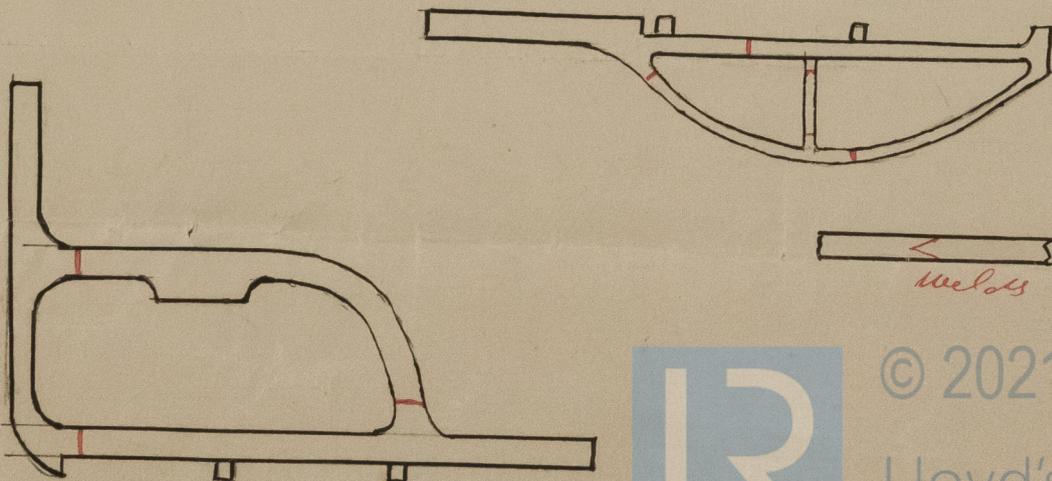

© 2021

Lloyd's Register Foundation

*Pennoldson*

156



© 2021

Lloyd's Register  
Foundation