

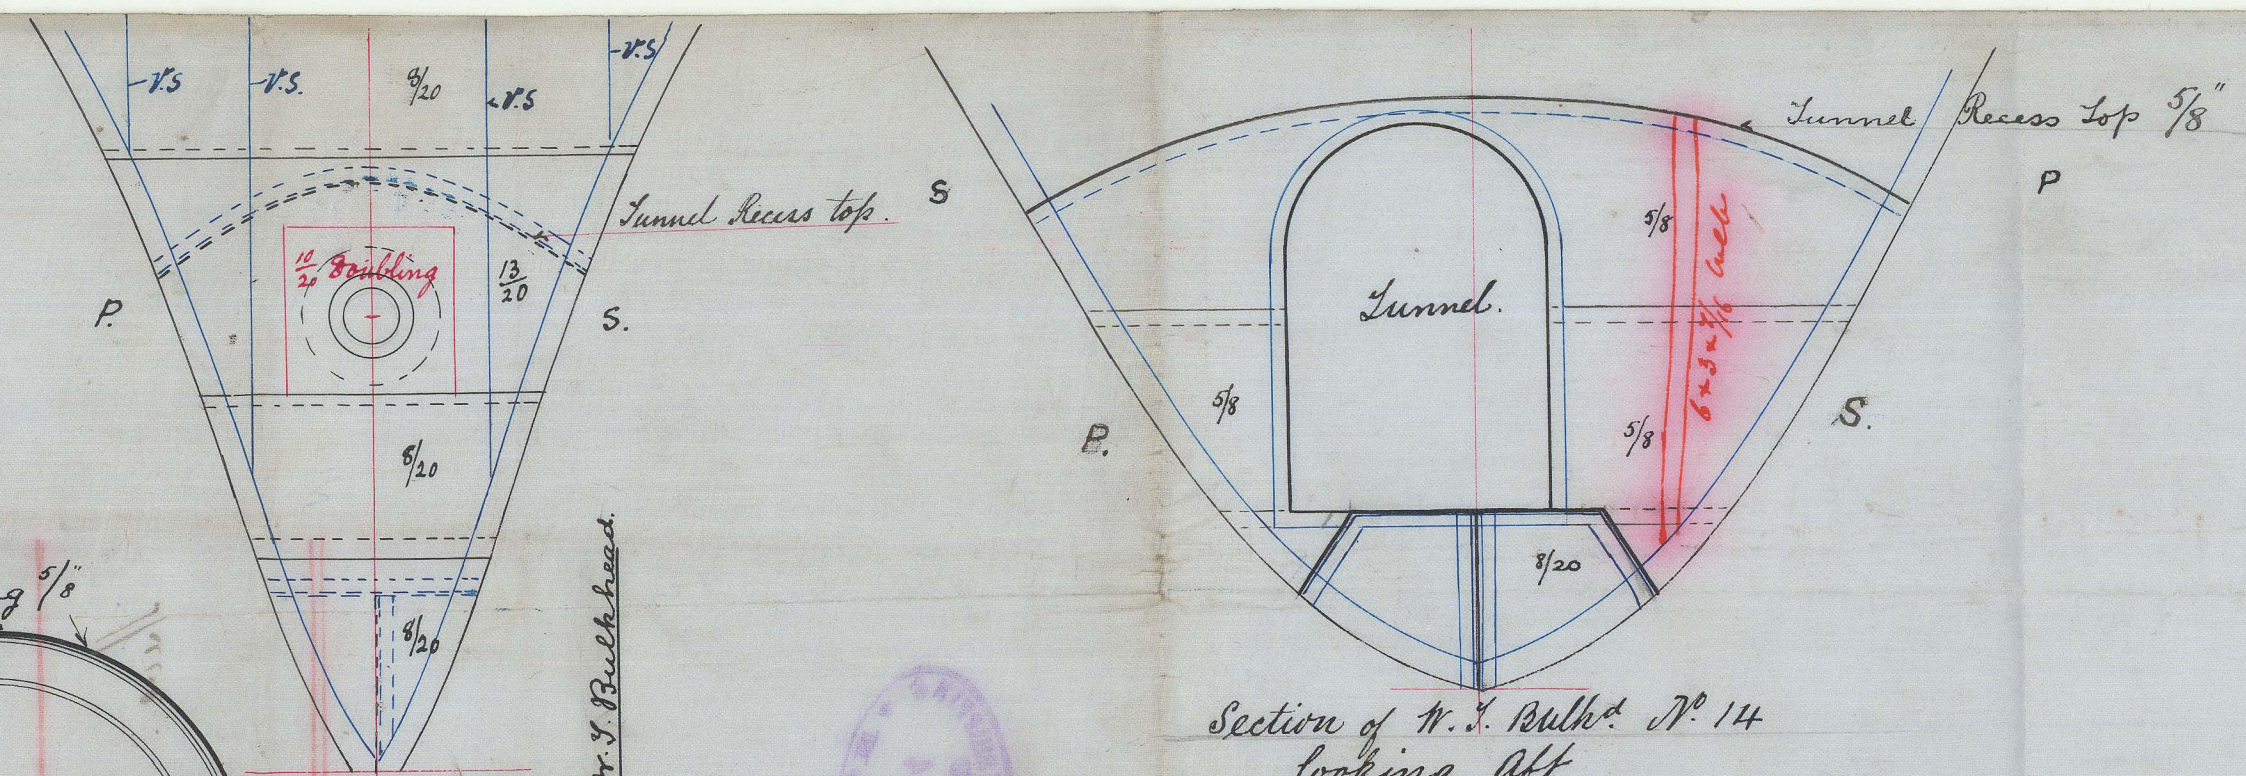
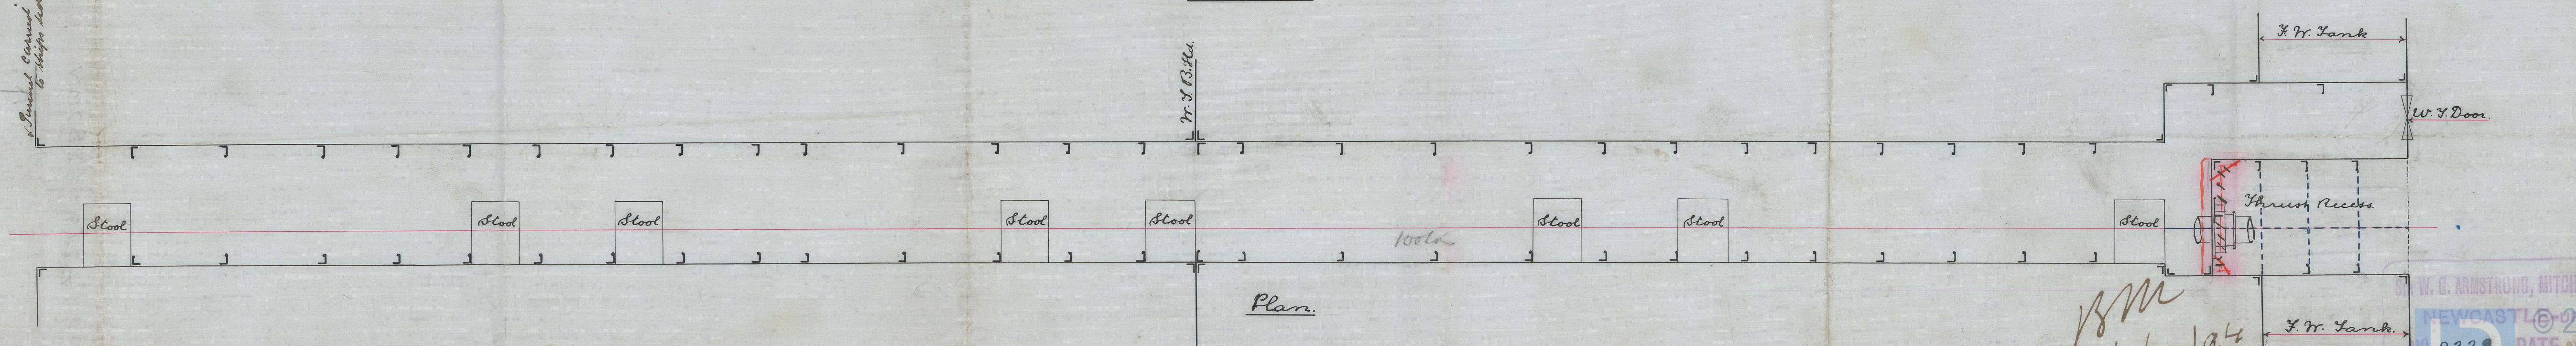


31.12.94
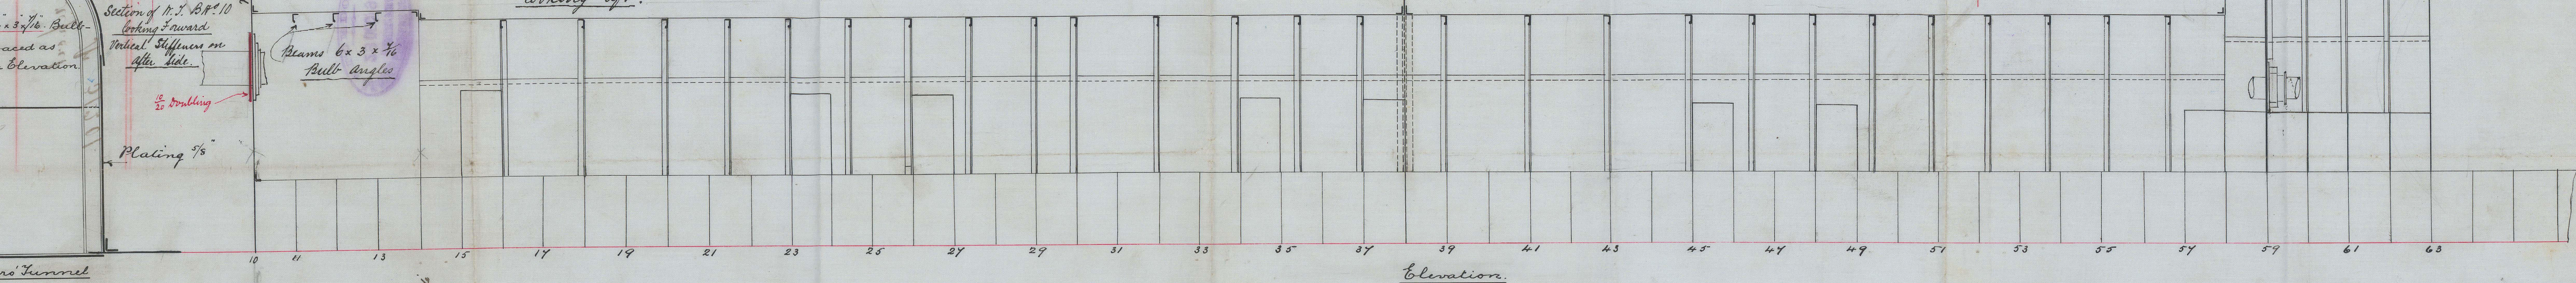

77° 6' 19.620. + 622.
 Shaft Tunnel Plan
 Scale 1/4" = 1 foot.

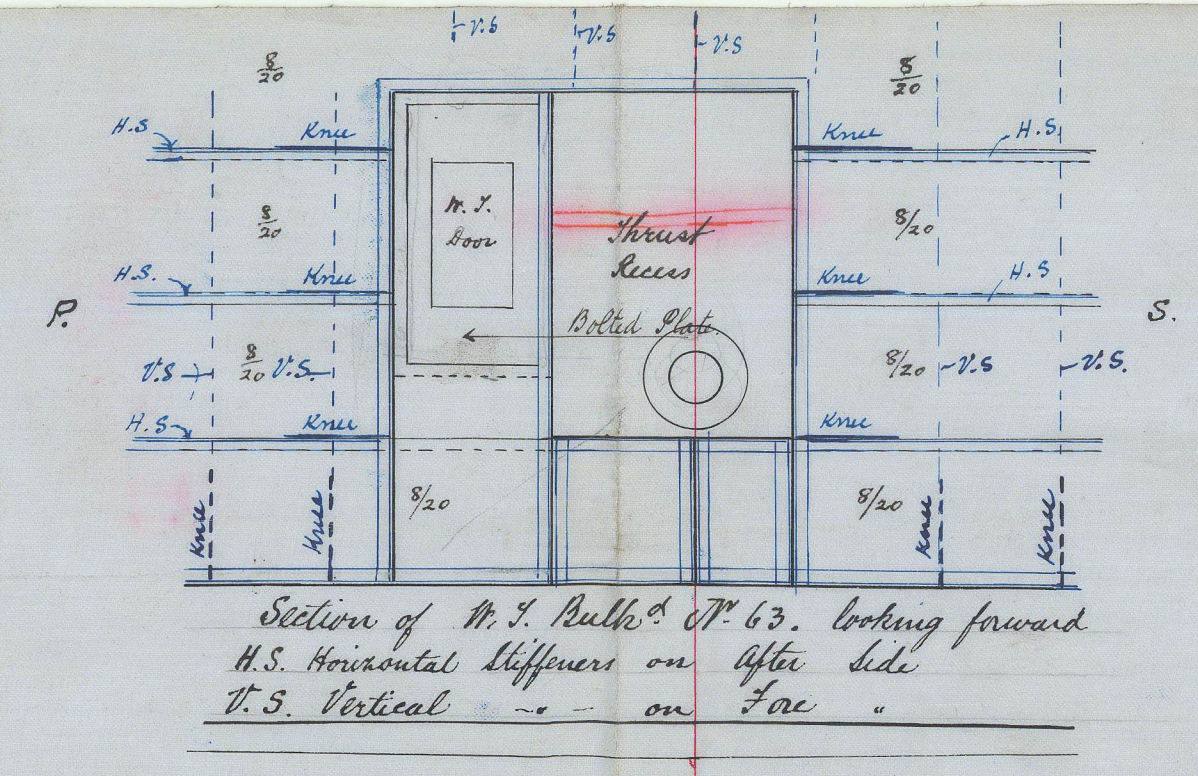



NWC 839-0127

31/12/94

Sir W. G. Armstrong & Co.
19, 20 & 22

"Johannesburg"

Have report
of 5/20/18

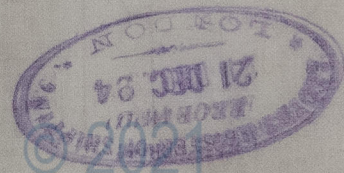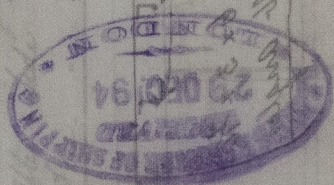

Lloyd's Register
Foundation

NWC 839