

Lloyd's Register of British and Foreign Shipping.

(Report on Vessel No. _____ Port _____)

No. **2568** SHIP FORGINGS OR CASTINGS.

The records FORGINGS or CASTINGS, IRON or STEEL, should be struck out as may be required.

I have to report that the undermentioned Iron or ~~Steel~~ Forgings or Castings, manufactured by *Messrs Hawthorn Leslie & Co* of *Hebburn* for the Vessel No. *330*, being built by *Messrs Hawthorn Leslie & Co* of *Hebburn* have been inspected by me as set forth below, and found to be, so far as can be seen, *sound*


Mark on Forgings.

Lloyd's
No. *4105B*
76

John C Gray
Newcastle

	STERN FRAME.	RUDDER FRAME.	STEM.
Material*	<i>Scrap Iron</i>	<i>Scrap Iron</i>	
How made	<i>Forged</i>	<i>Forged</i>	
Dimensions	<i>12 - 7 3/4</i>	<i>10 1/2 - 5 1/4</i>	
Progress on Inspection	<i>Forged & Smitten</i>	<i>Forged & Smitten</i>	<i>Not seen</i>
Date when Inspected	<i>November 1-14-22</i> <i>December 4/94</i>	<i>February 5 to</i> <i>April 19/95</i>	

SKETCHES OF FRAMES SHOWING POSITION AND DESCRIPTION OF WELDS OF FORGINGS, OR PARTICULARS OF TESTS APPLIED TO CASTINGS.

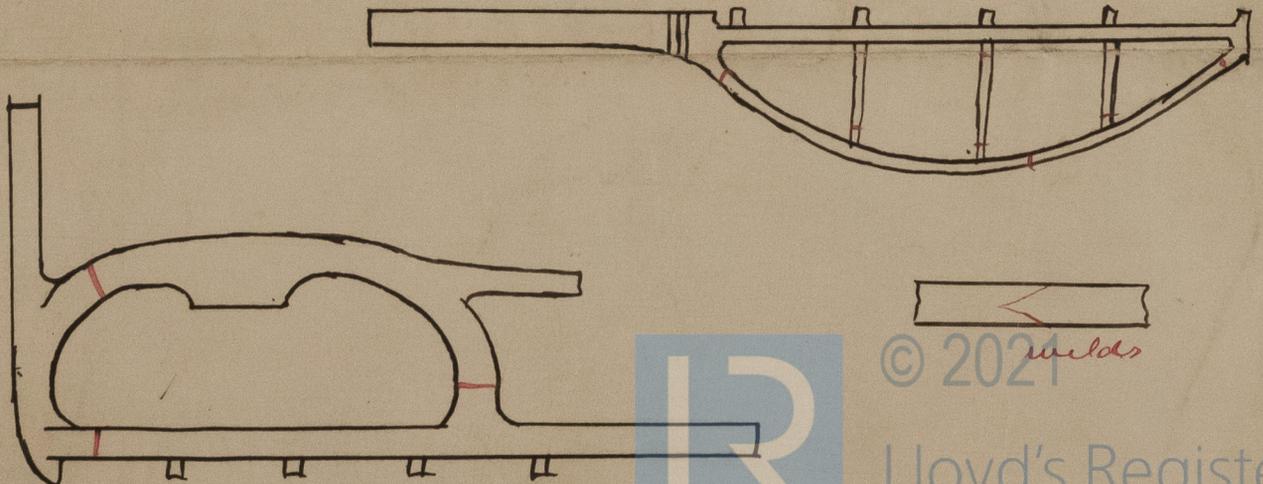

© 2021
Lloyd's Register
Foundation

* If of Iron, state whether scrap or puddled Iron.

NWC842-0086