

LOYD'S REGISTER
LONDON

— S.S. N° 330 —

SKETCHES OF TWEEN DECK SIDE STRINGER


— SCALE 3 INCHES TO A FOOT. —

27.11.94

DOUBLE ANGLES & INTERCOSTAL PLATE

as required and being fitted
See Section


A

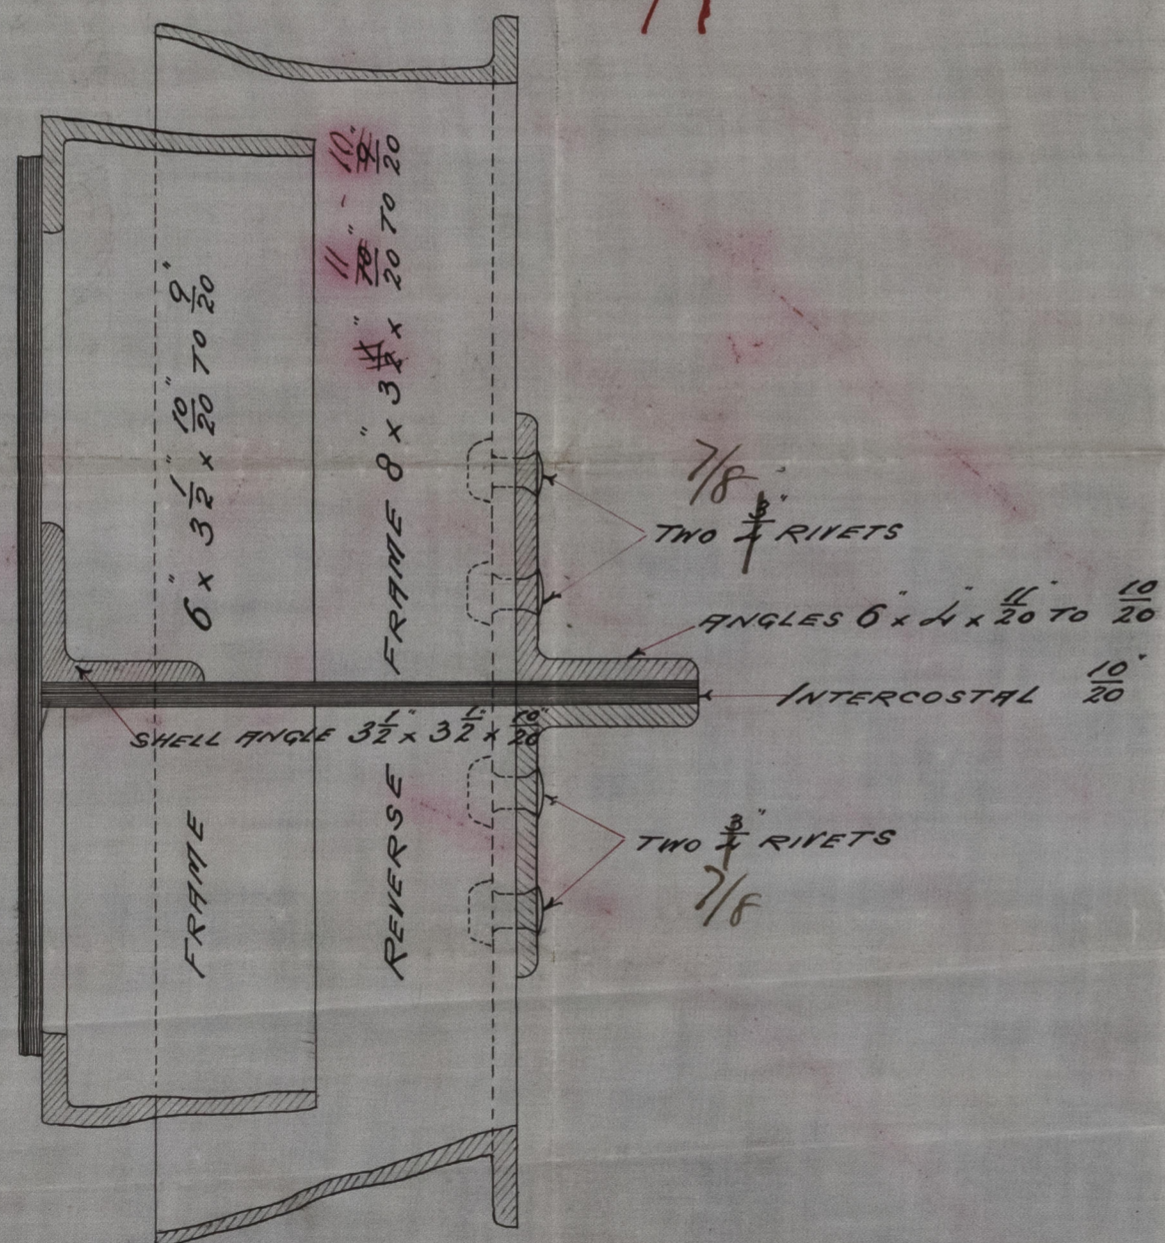

CHANNEL BAR

Not approved
See Section

B

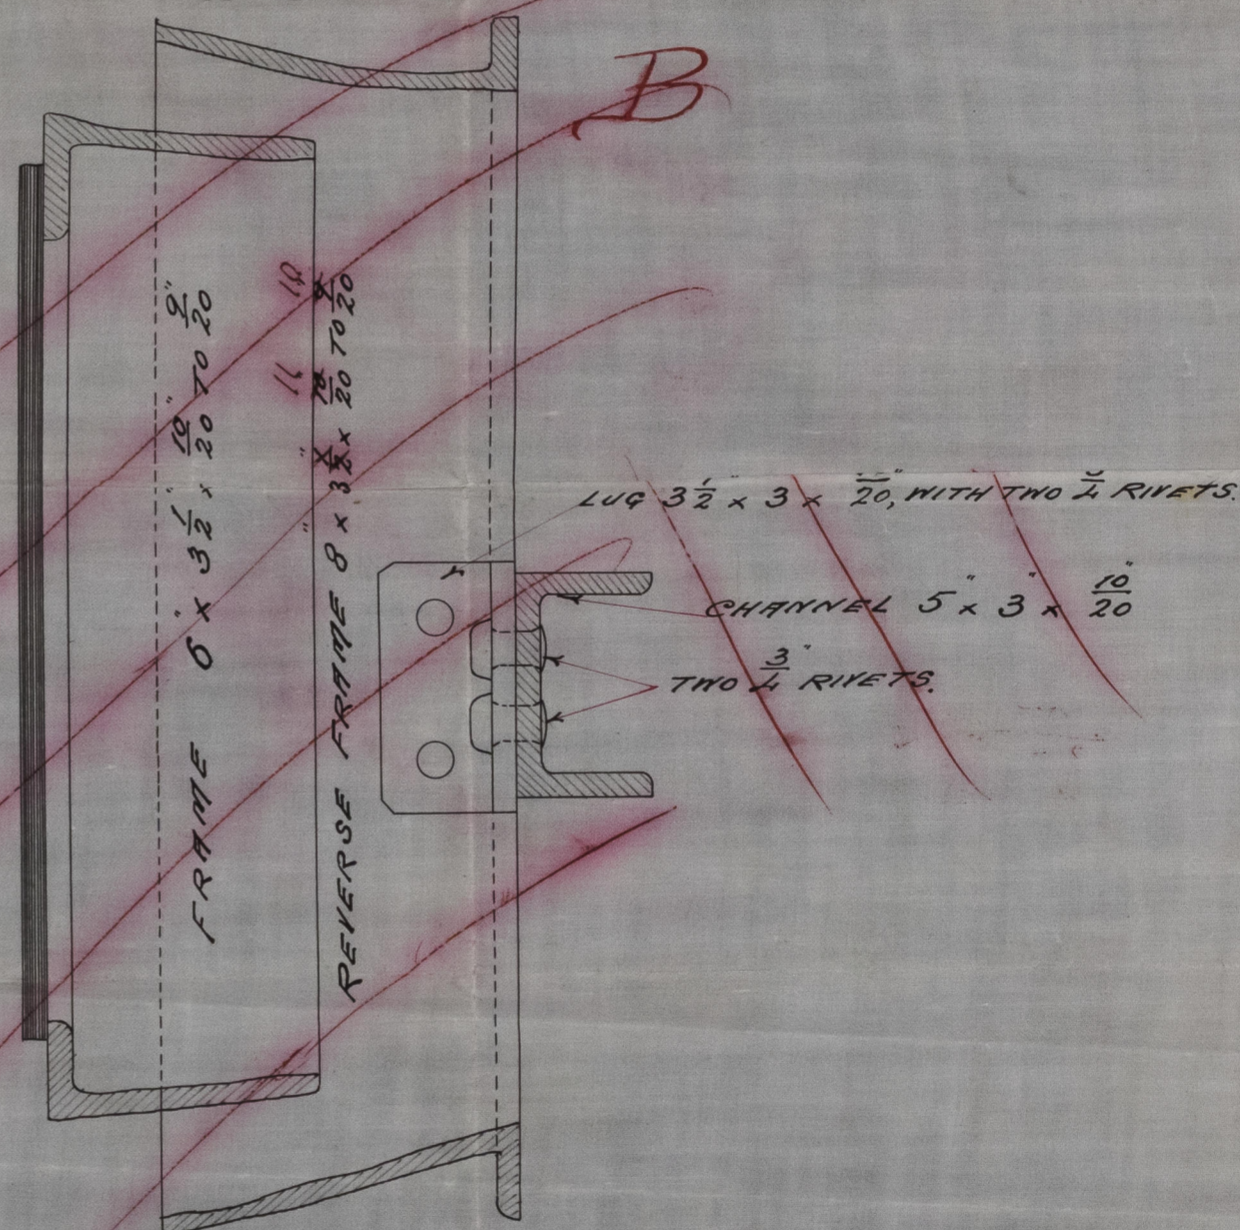

18m
J.H.L.
26/11/94

R.W. HAWTHORN & CO. LTD.
SHIPBUILDERS & ENGINEERS
2571
HEDDER STREET BUILDING YARD
23rd Nov. 1894
NEWCASTLE-ON-TYNE



© 2021
Lloyd's Register
Foundation

NWC842-0098

L. S. Rakarin
No. 31969

