

Lloyd's Register of British and Foreign Shipping.

(Report on Vessel No. _____ Port _____)

Here

No. 3057.a SHIP FORGINGS OR CASTINGS.

I have to report that the undermentioned Iron ~~or Steel~~ Forgings ~~or Castings~~,
 manufactured by *The Sunderland Forge Co.*
 of *Pallion* for the Vessel No. *168*, being built
 by *Messrs J P Rendelson Jun* of *Newcastle*
 have been inspected by me as set forth below, and found to be, so far as can be seen,
sound

Mark on Forgings.

Lloyd's
 No. 3057.a
 10.6.


Wm Cameron

Sunderland

5. 9. 95

	STERN FRAME.	RUDDER FRAME.	STEM.
Material*	<i>Scrap iron</i>	<i>Scrap iron</i>	/
How made	<i>Forged</i>	<i>Forged</i>	
Dimensions	<i>6 1/4 x 3 1/4</i>	<i>4 5/8 - 2 1/2</i>	
Progress on Inspection	<i>Forged finished</i>	<i>Forged finished</i>	
Date when Inspected	<i>Jun 28th to July 18/95</i>	<i>Aug 7th to 20/95</i>	


SKETCHES OF FRAMES SHOWING POSITION AND DESCRIPTION OF WELDS OF FORGINGS, OR PARTICULARS OF TESTS APPLIED TO CASTINGS.

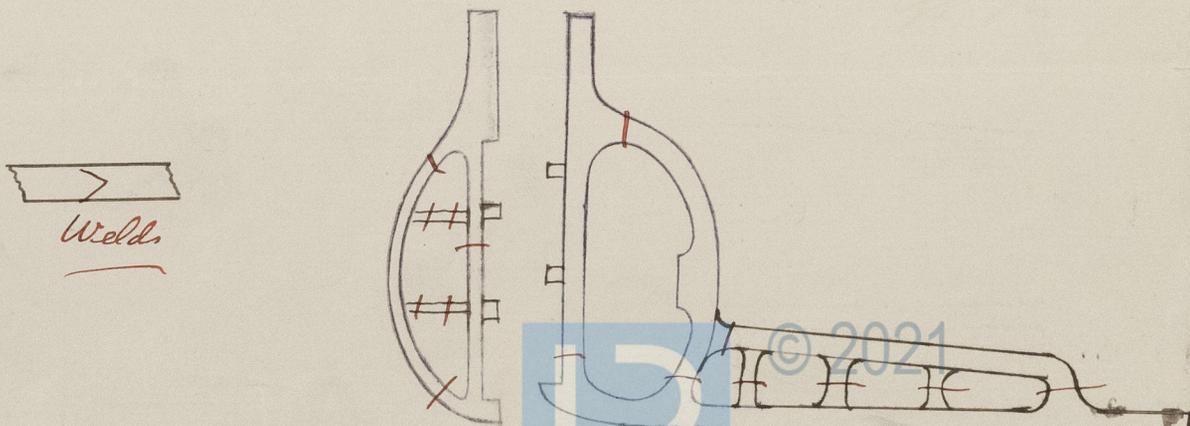

Fee (if any chargeable) £ : :

To be paid at _____

* If of Iron, state whether scrap or puddled Iron.

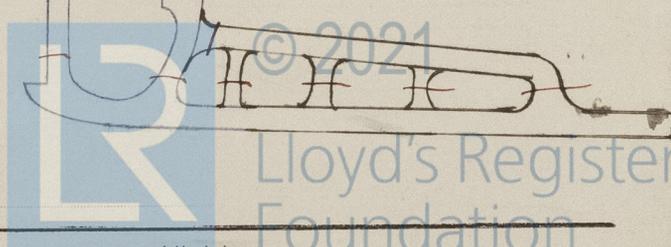

J.R. Remoldson 168

S/S Champion

Nov Rpt No 32402.



© 2021

Lloyd's Register
Foundation