



PUMPING ARRANGEMENT N^{os} 339 & 340 SHIPS.

SCALE $\frac{1}{8}'' = \text{ONE FOOT.}$

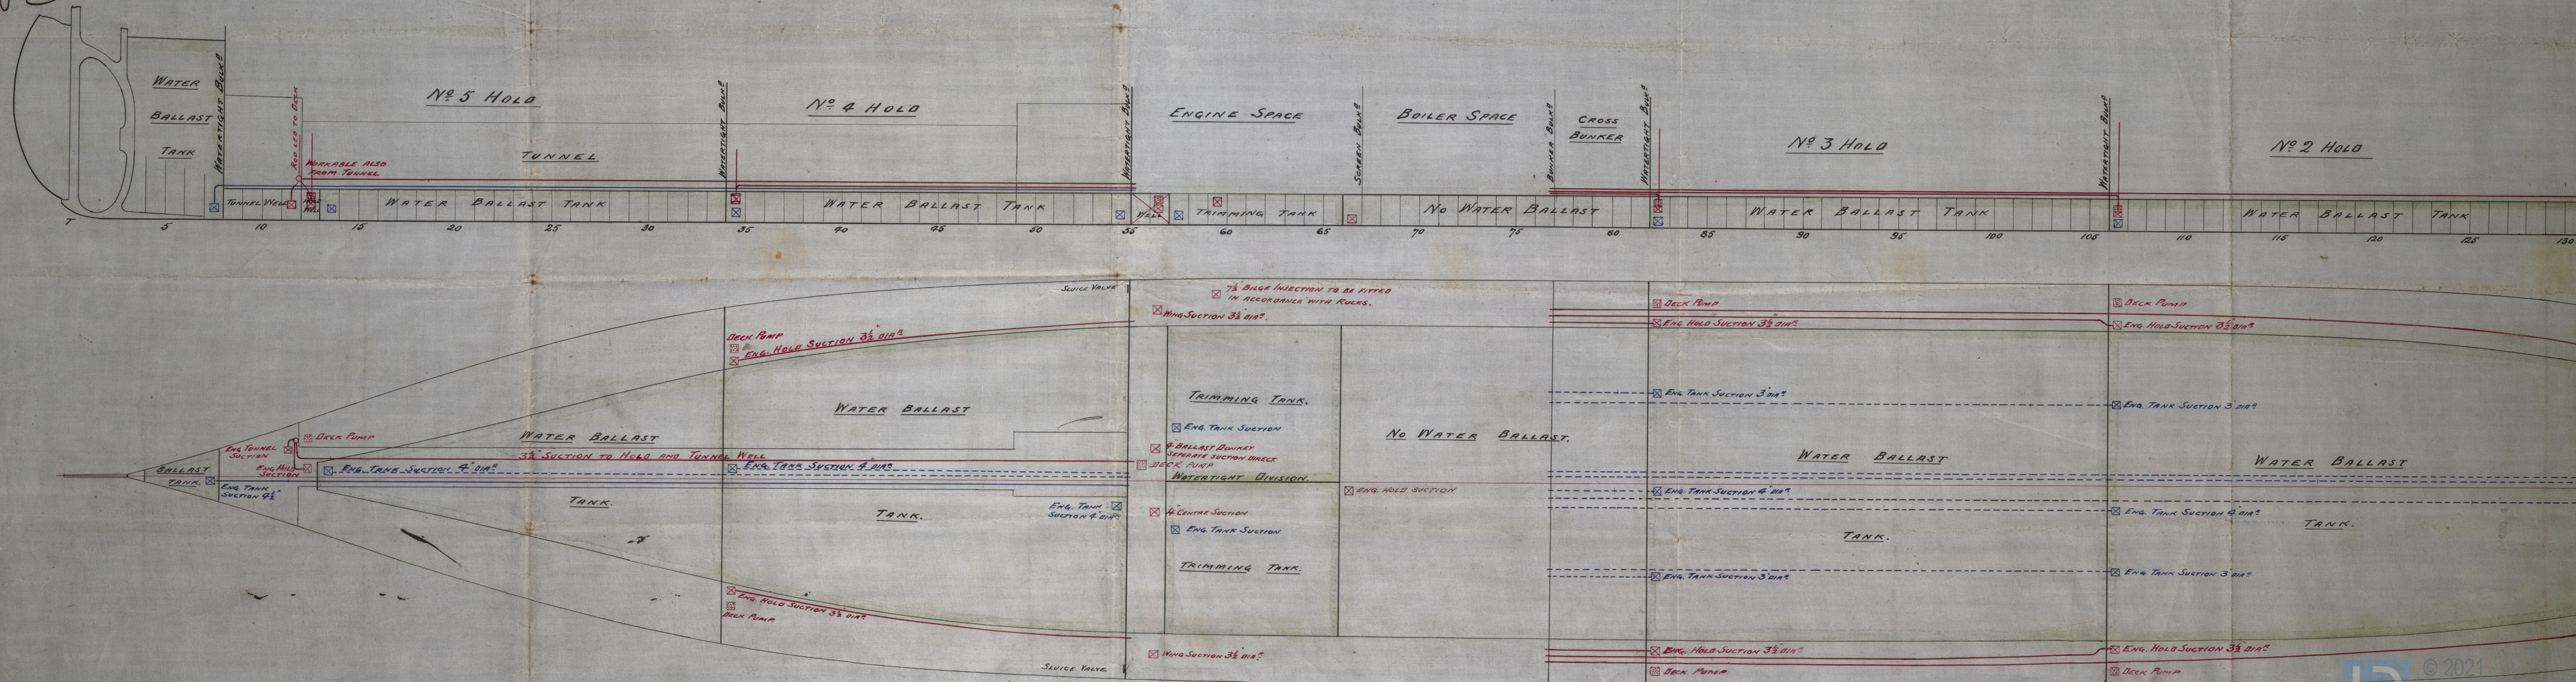

SCALE $\frac{1}{8}'' = \text{ONE FOOT.}$

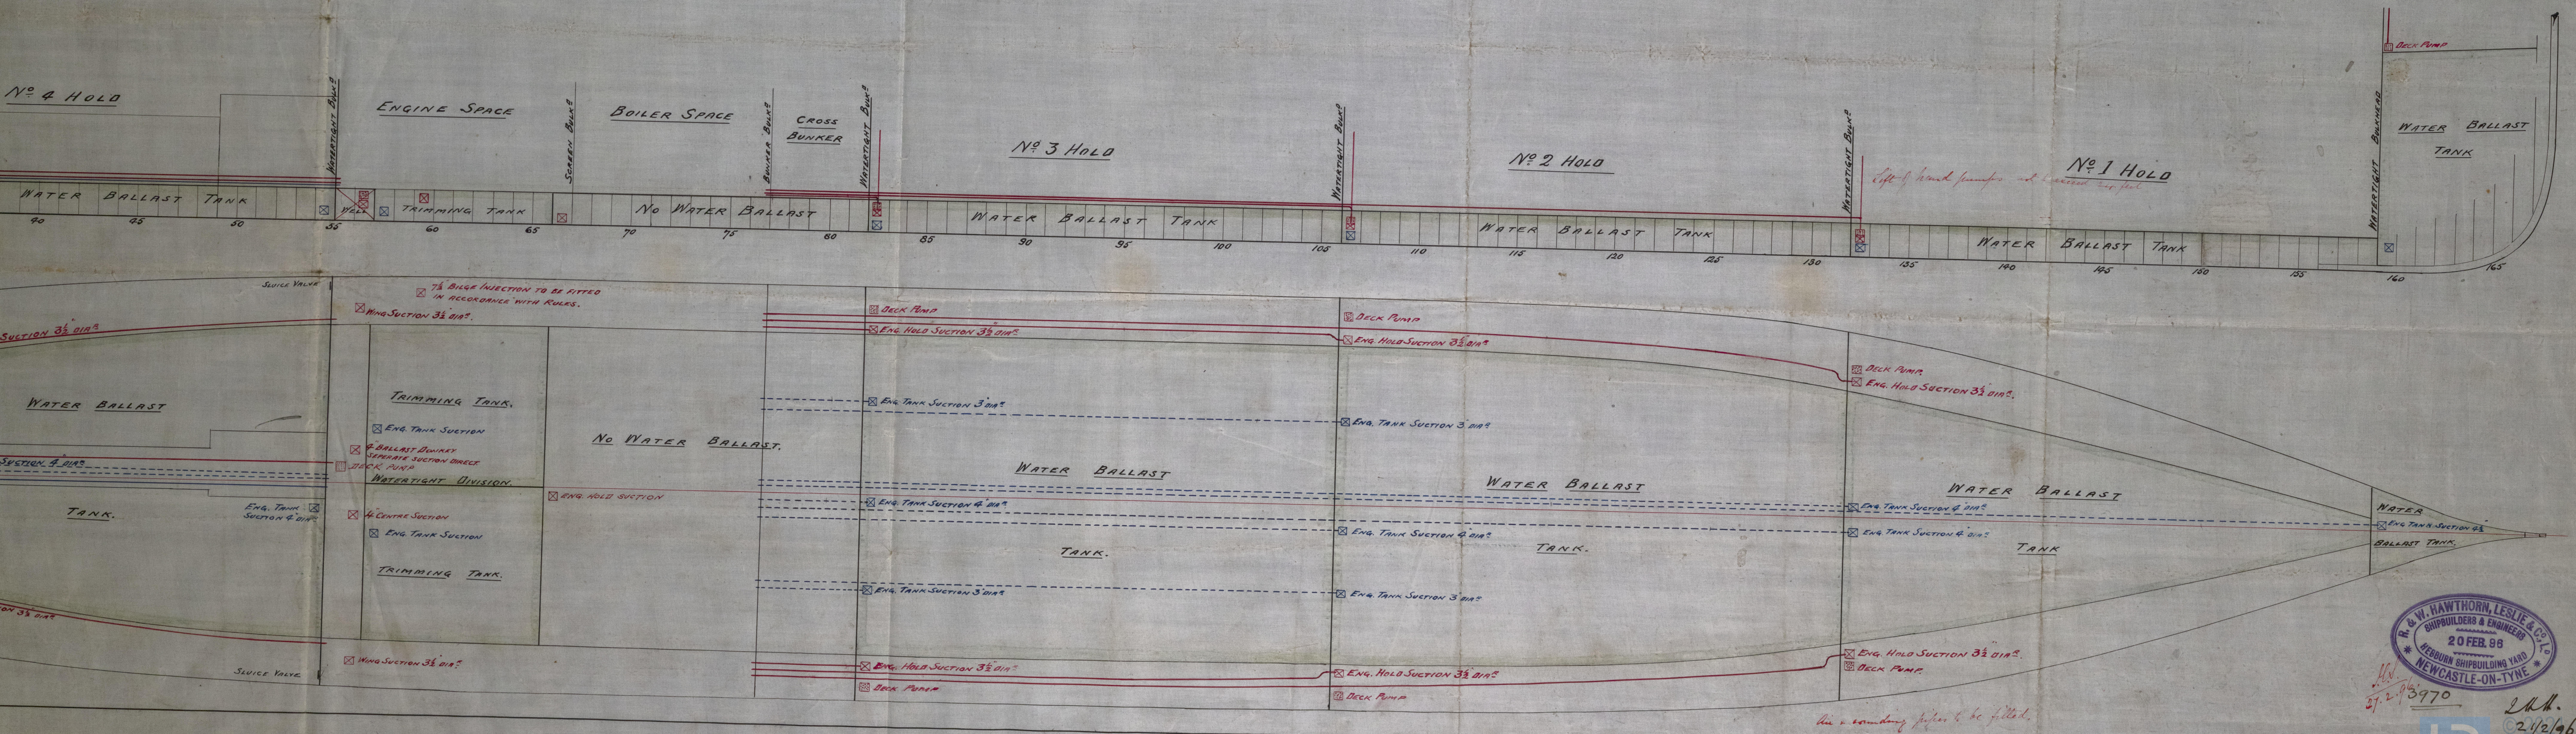

27.2.94 3970


24/2/96.



Lloyd's Register
Foundation

NWC849-0231

St Cornwall
Nwc Apt No 34106.

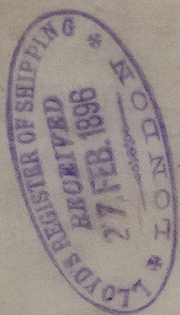

No 4 Hold



© 2021

Lloyd's Register
Foundation