




MAIN DECK AT ENDS


- No 339 -

	WEB	FLANGES
SIZE AS APPROVED	10" x $\frac{12}{20}$	3 $\frac{1}{2}$ " x $\frac{12}{20}$
MILL SIZE	10 x $\frac{13}{20}$	3 $\frac{3}{4}$ " x $\frac{10}{20}$

28 1.96

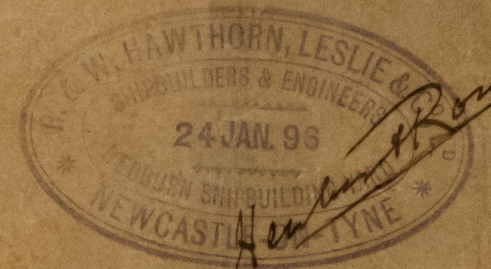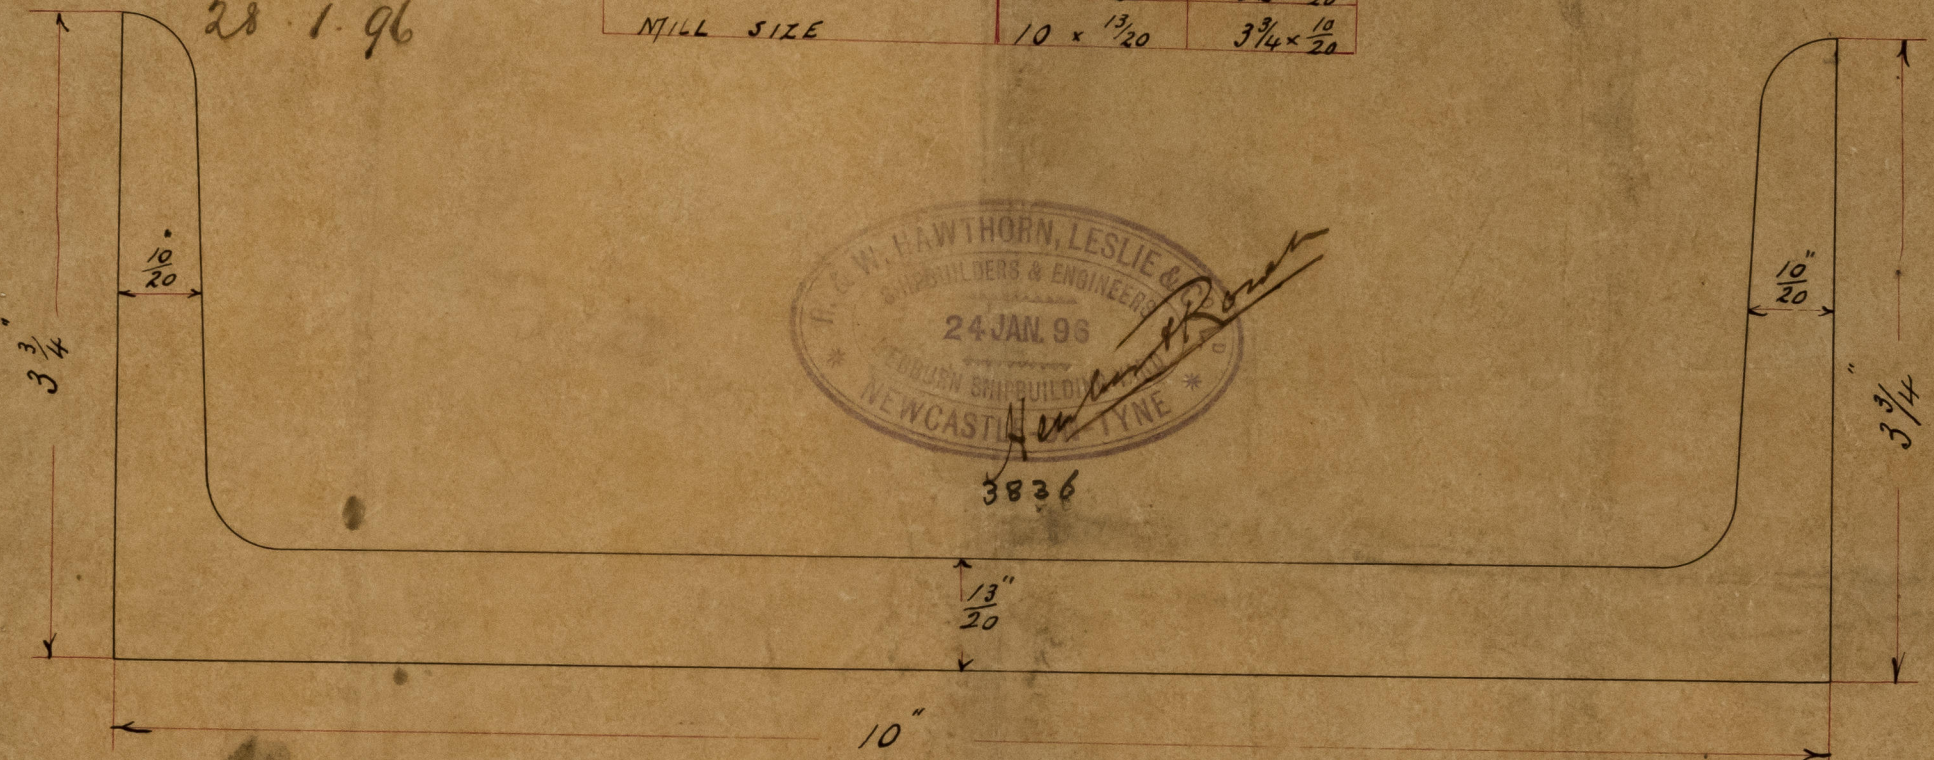

3836

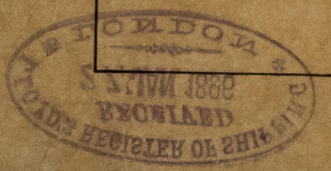

J.D.C.
28/1/96

NWC849-0235


NWC849-0532

of Cornwall
 Rmc Rpt No 34106

MAIN DECK AT END 2



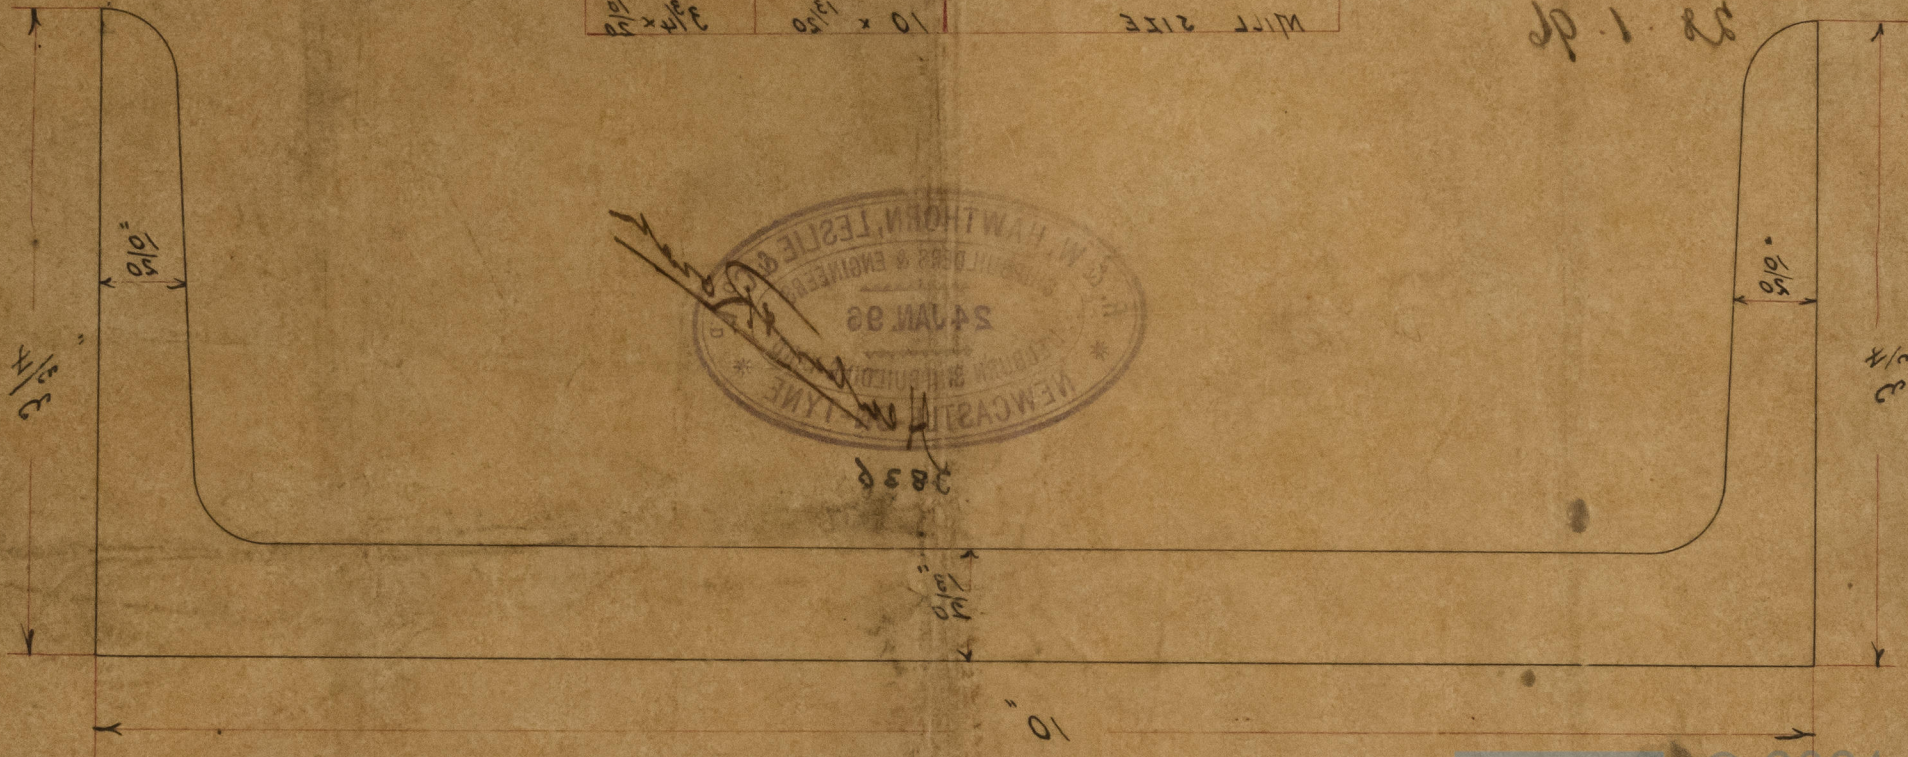

- No 336 -

NWC849-0235

NWC849-0532



© 2021

