

Lloyd's Register of British and Foreign Shipping.

(Report on Vessel No. _____ Port *Newcastle on Tyne.*)

No. *3340*

SHIP FORGINGS OR CASTINGS.

I have to report that the undermentioned Iron ~~or Steel~~ Forgings ~~or Castings~~,
 manufactured by *Messrs Hawthorn Leslie & Co*
 of *Hebburn* for the Vessel No. *339*, being built
 by *Messrs Hawthorn Leslie & Co* of *Hebburn*
 have been inspected by me as set forth below, and found to be, so far as can be seen,
sound

The words FORGINGS or CASTINGS, IRON or STEEL, should be struck out as may be required.


Mark on Forgings.

Lloyd's
 No. *5345B*
JG

John Craig
Newcastle
28. 10. 96

	STERN FRAME.	RUDDER FRAME.	STEM.
Material* ...	<i>Scrap Iron</i>	<i>Scrap Iron</i>	<i>Scrap Iron</i>
How made ...	<i>Forged</i>	<i>Forged</i>	<i>Forged</i>
Dimensions ...	<i>12 - 7 1/4</i>	<i>10 1/2 - 5 1/4</i>	<i>12 - 3 1/8</i>
Progress on Inspection	<i>Forged & Smithed</i>	<i>Forged & Smithed</i>	<i>Smithed</i>
Date when Inspected	<i>March 27 to May 12/96</i>	<i>August 4 to October 27/96</i>	<i>May 14/96</i>

SKETCHES OF FRAMES SHOWING POSITION AND DESCRIPTION OF WELDS OF FORGINGS, OR PARTICULARS OF TESTS APPLIED TO CASTINGS.

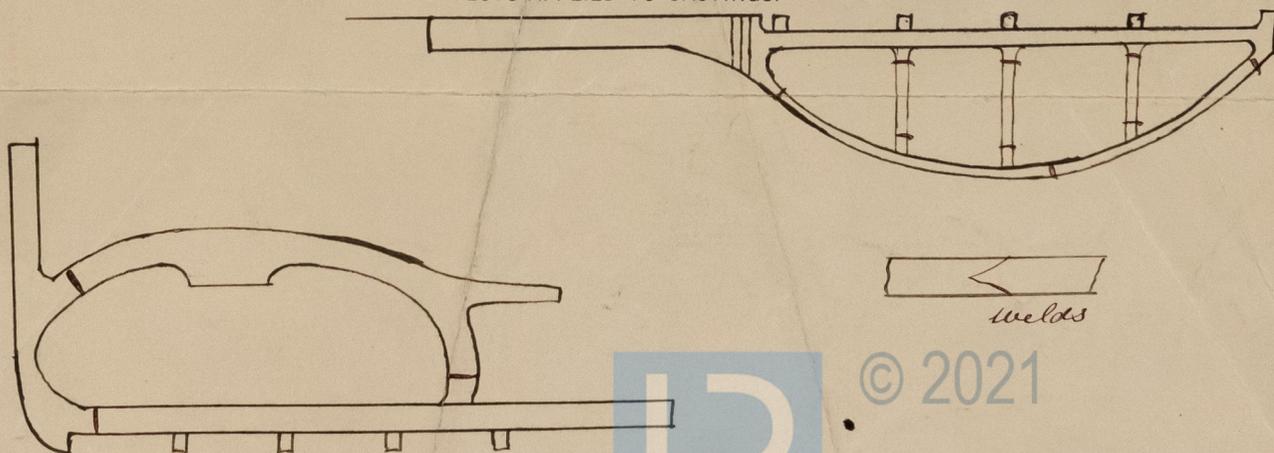

© 2021

Lloyd's Register Foundation

R. + W. Lawthorn Leslie & Co. Ltd.

339 S/S

St Cornwall

Inc Rpt N^o 34106



© 2021

Lloyd's Register
Foundation