



28.3.14

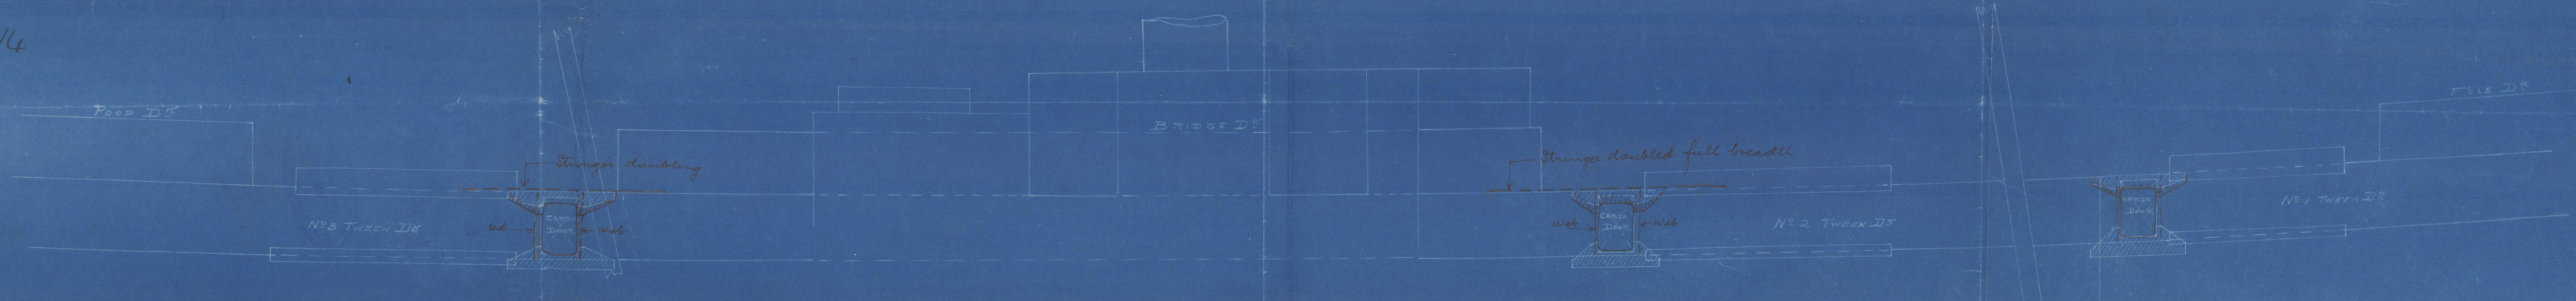

S.S. "INGELI"
PLAN SHEWING POSITION OF NEW
CARGO DOORS IN TWEEN DECKS.

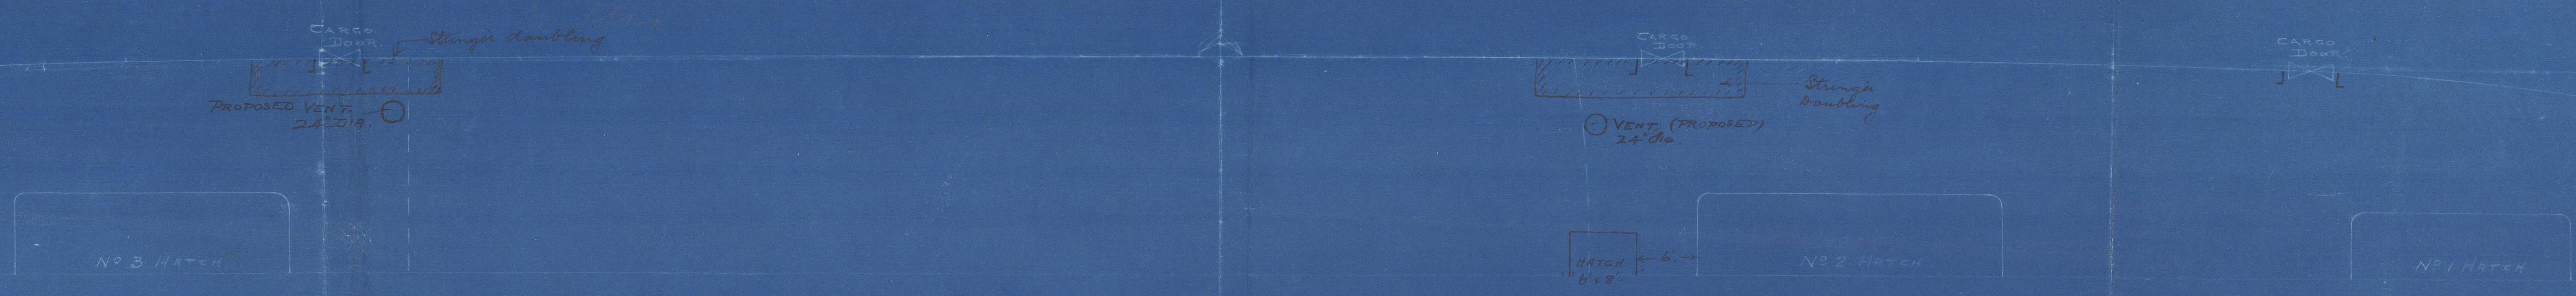



C.F.
28.3.14

Proposed Position

of Cargo door.

SS Ingeli

Nwe rpt. no. 66262.

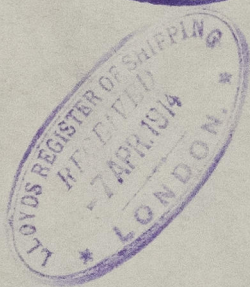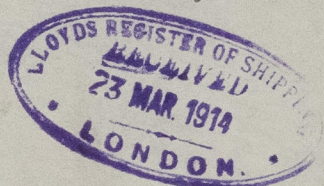

Shear

NWC876 - 0086



© 2021

Lloyd's Register
Foundation