



17.3.14

ELEVATION

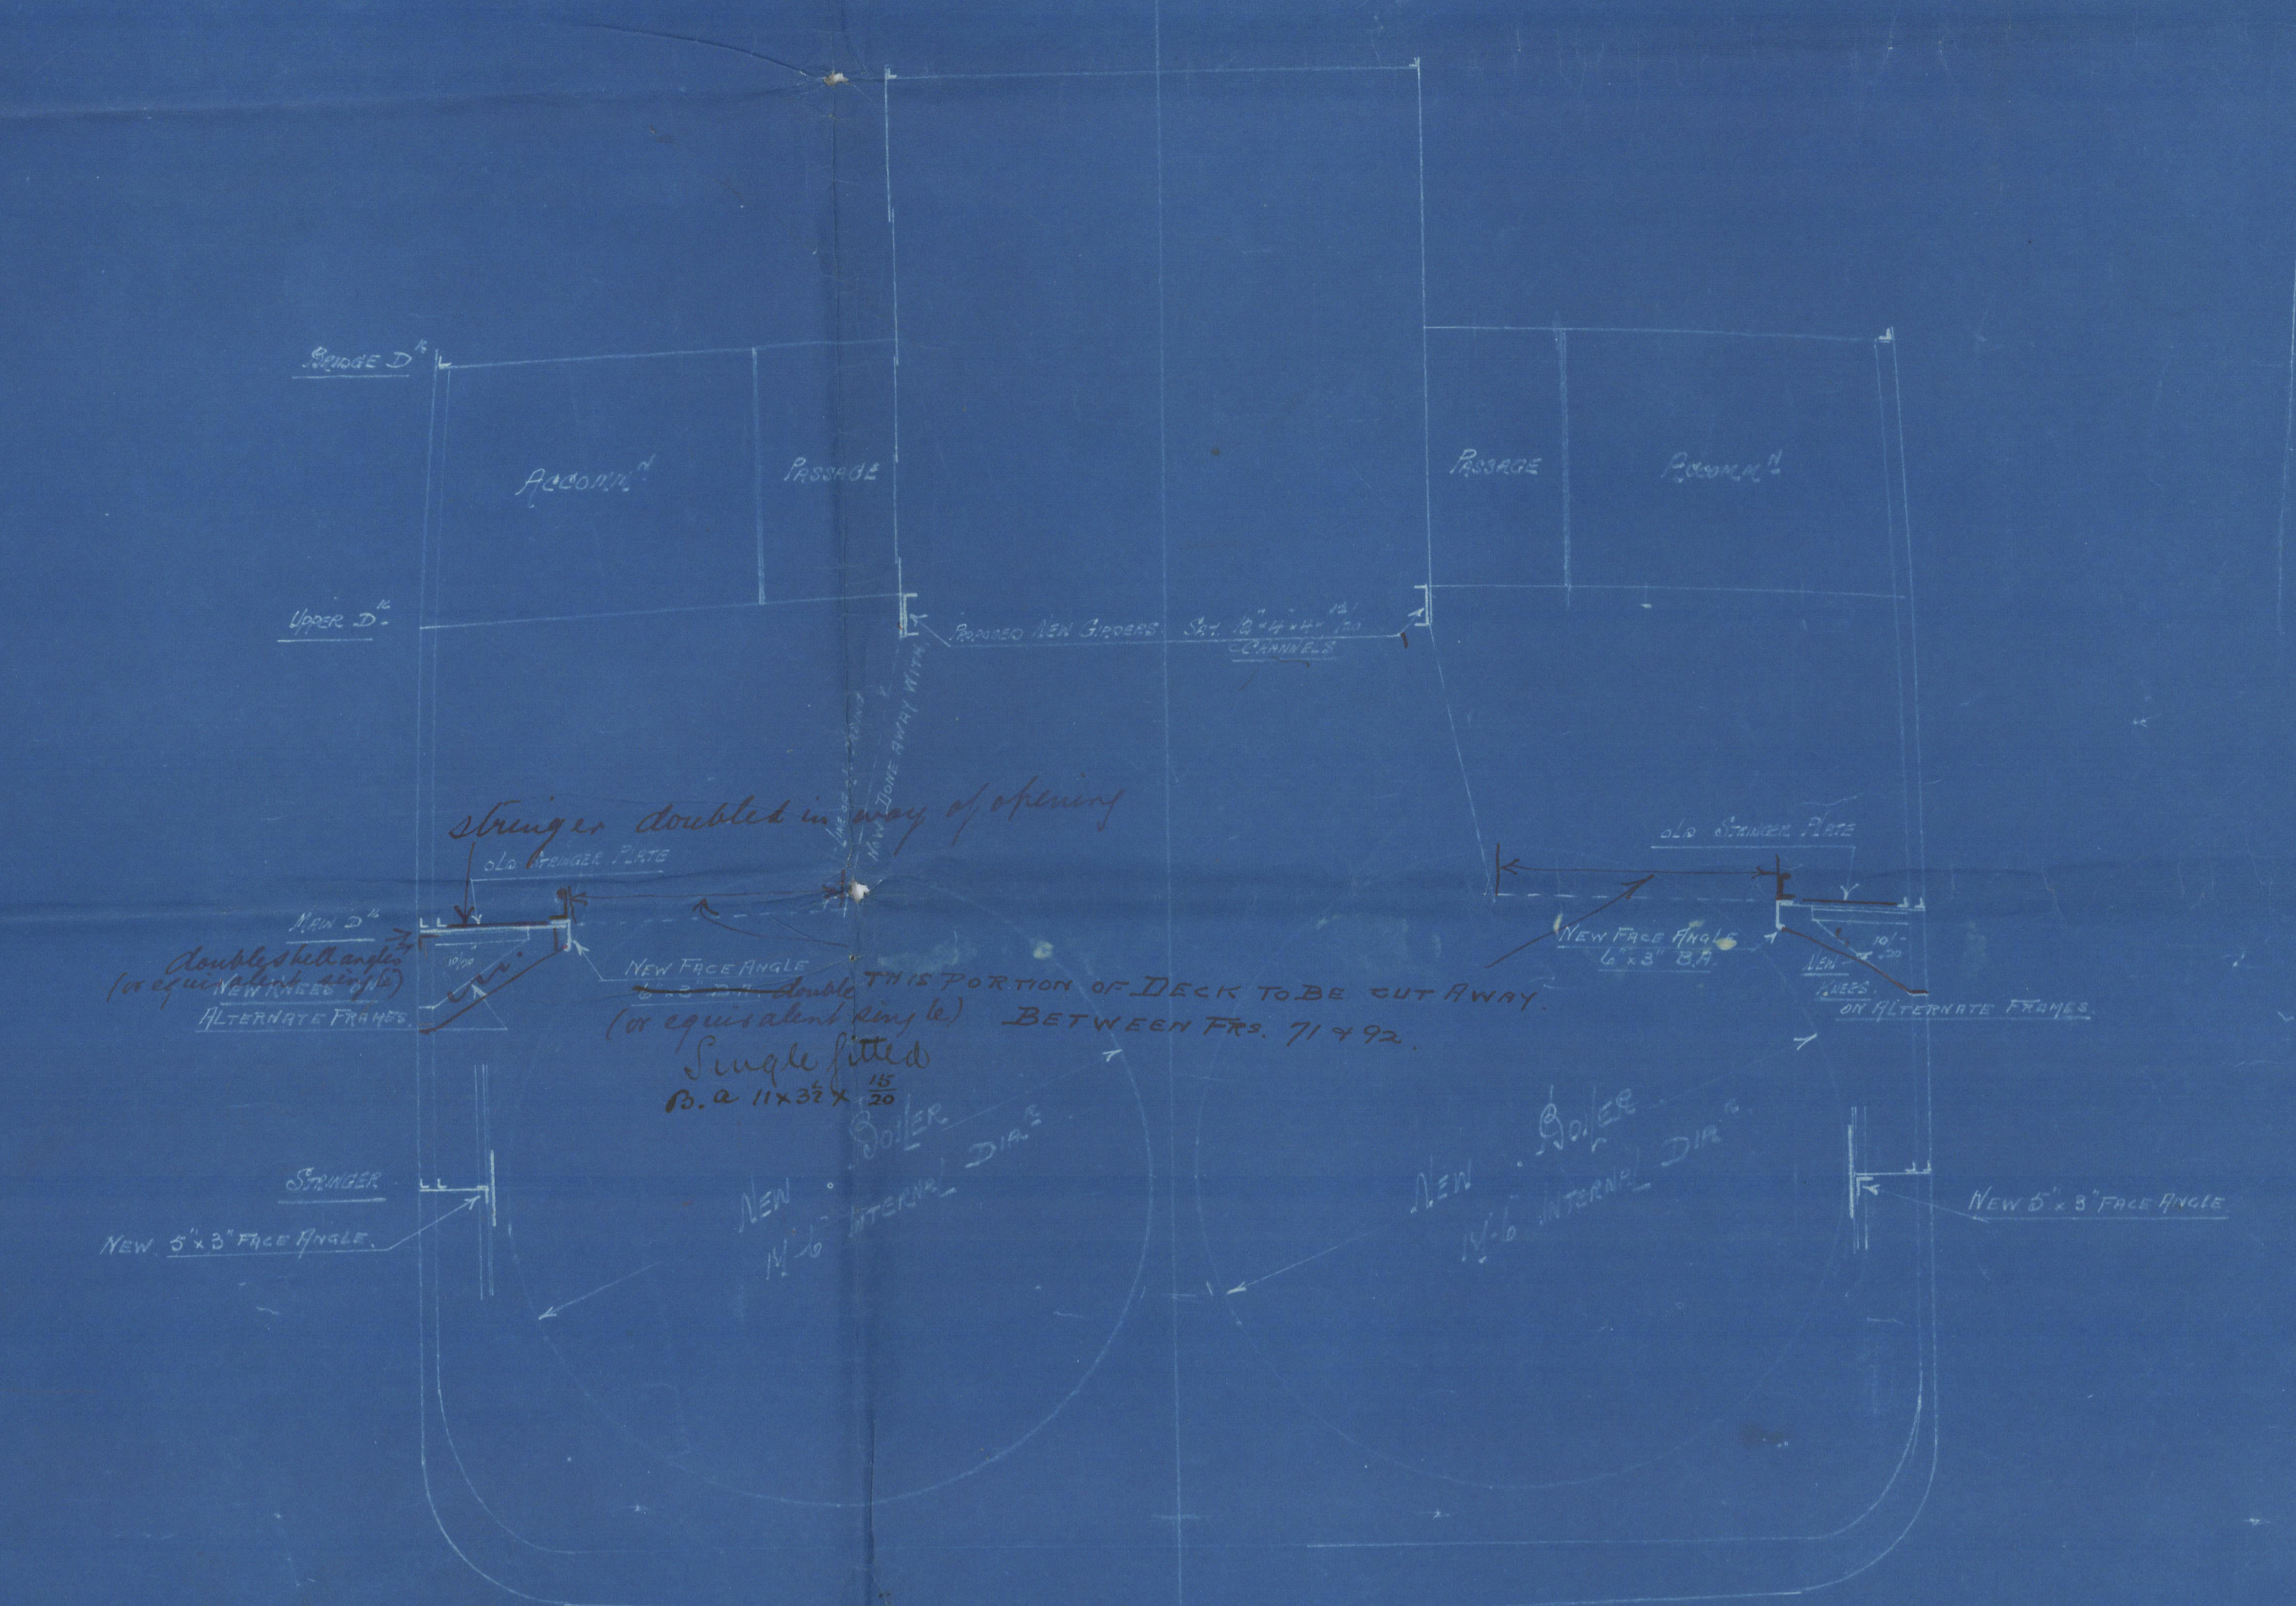

PLAN VIEW ON MAIN DECK

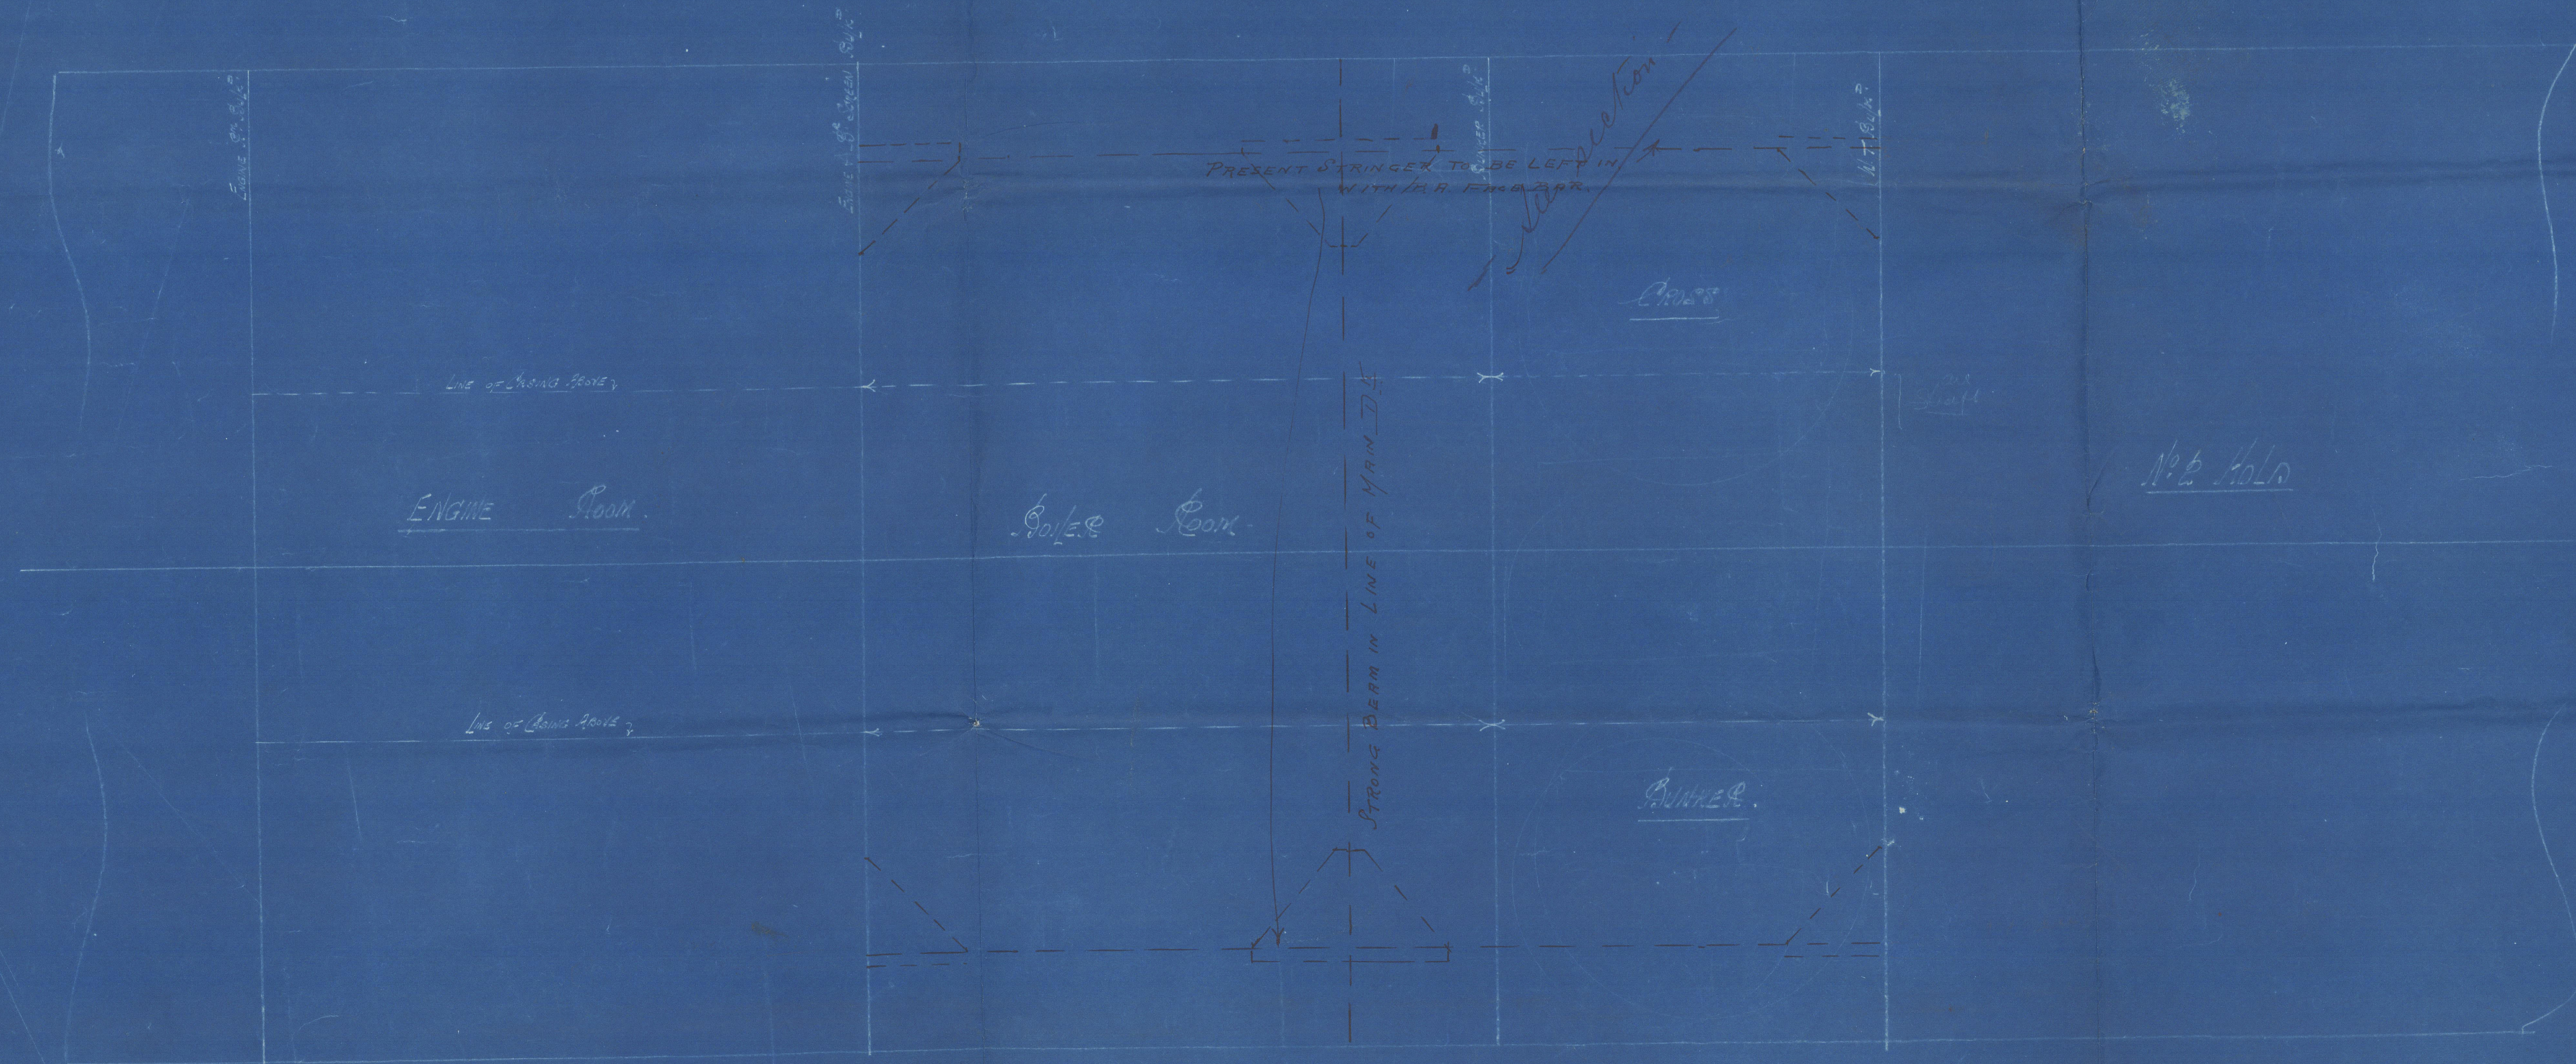

S. S. NGELI
PROPOSED APPENDMENT TO SHIP NEW POILERS
Scale 1/2" = 1 foot.


BBP
17.3.14

NO 1010

11/11/14

Proposed Alteration
to Boiler Space
SS Ingeli

Recd. No. 68263.

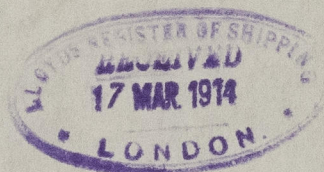

© 2021

Lloyd's Register
Foundation

NWC 876-2089

9 4 1/2
2
9

15
26
9.0

NWC 876 - 0089



© 2021

Lloyd's Register
Foundation