
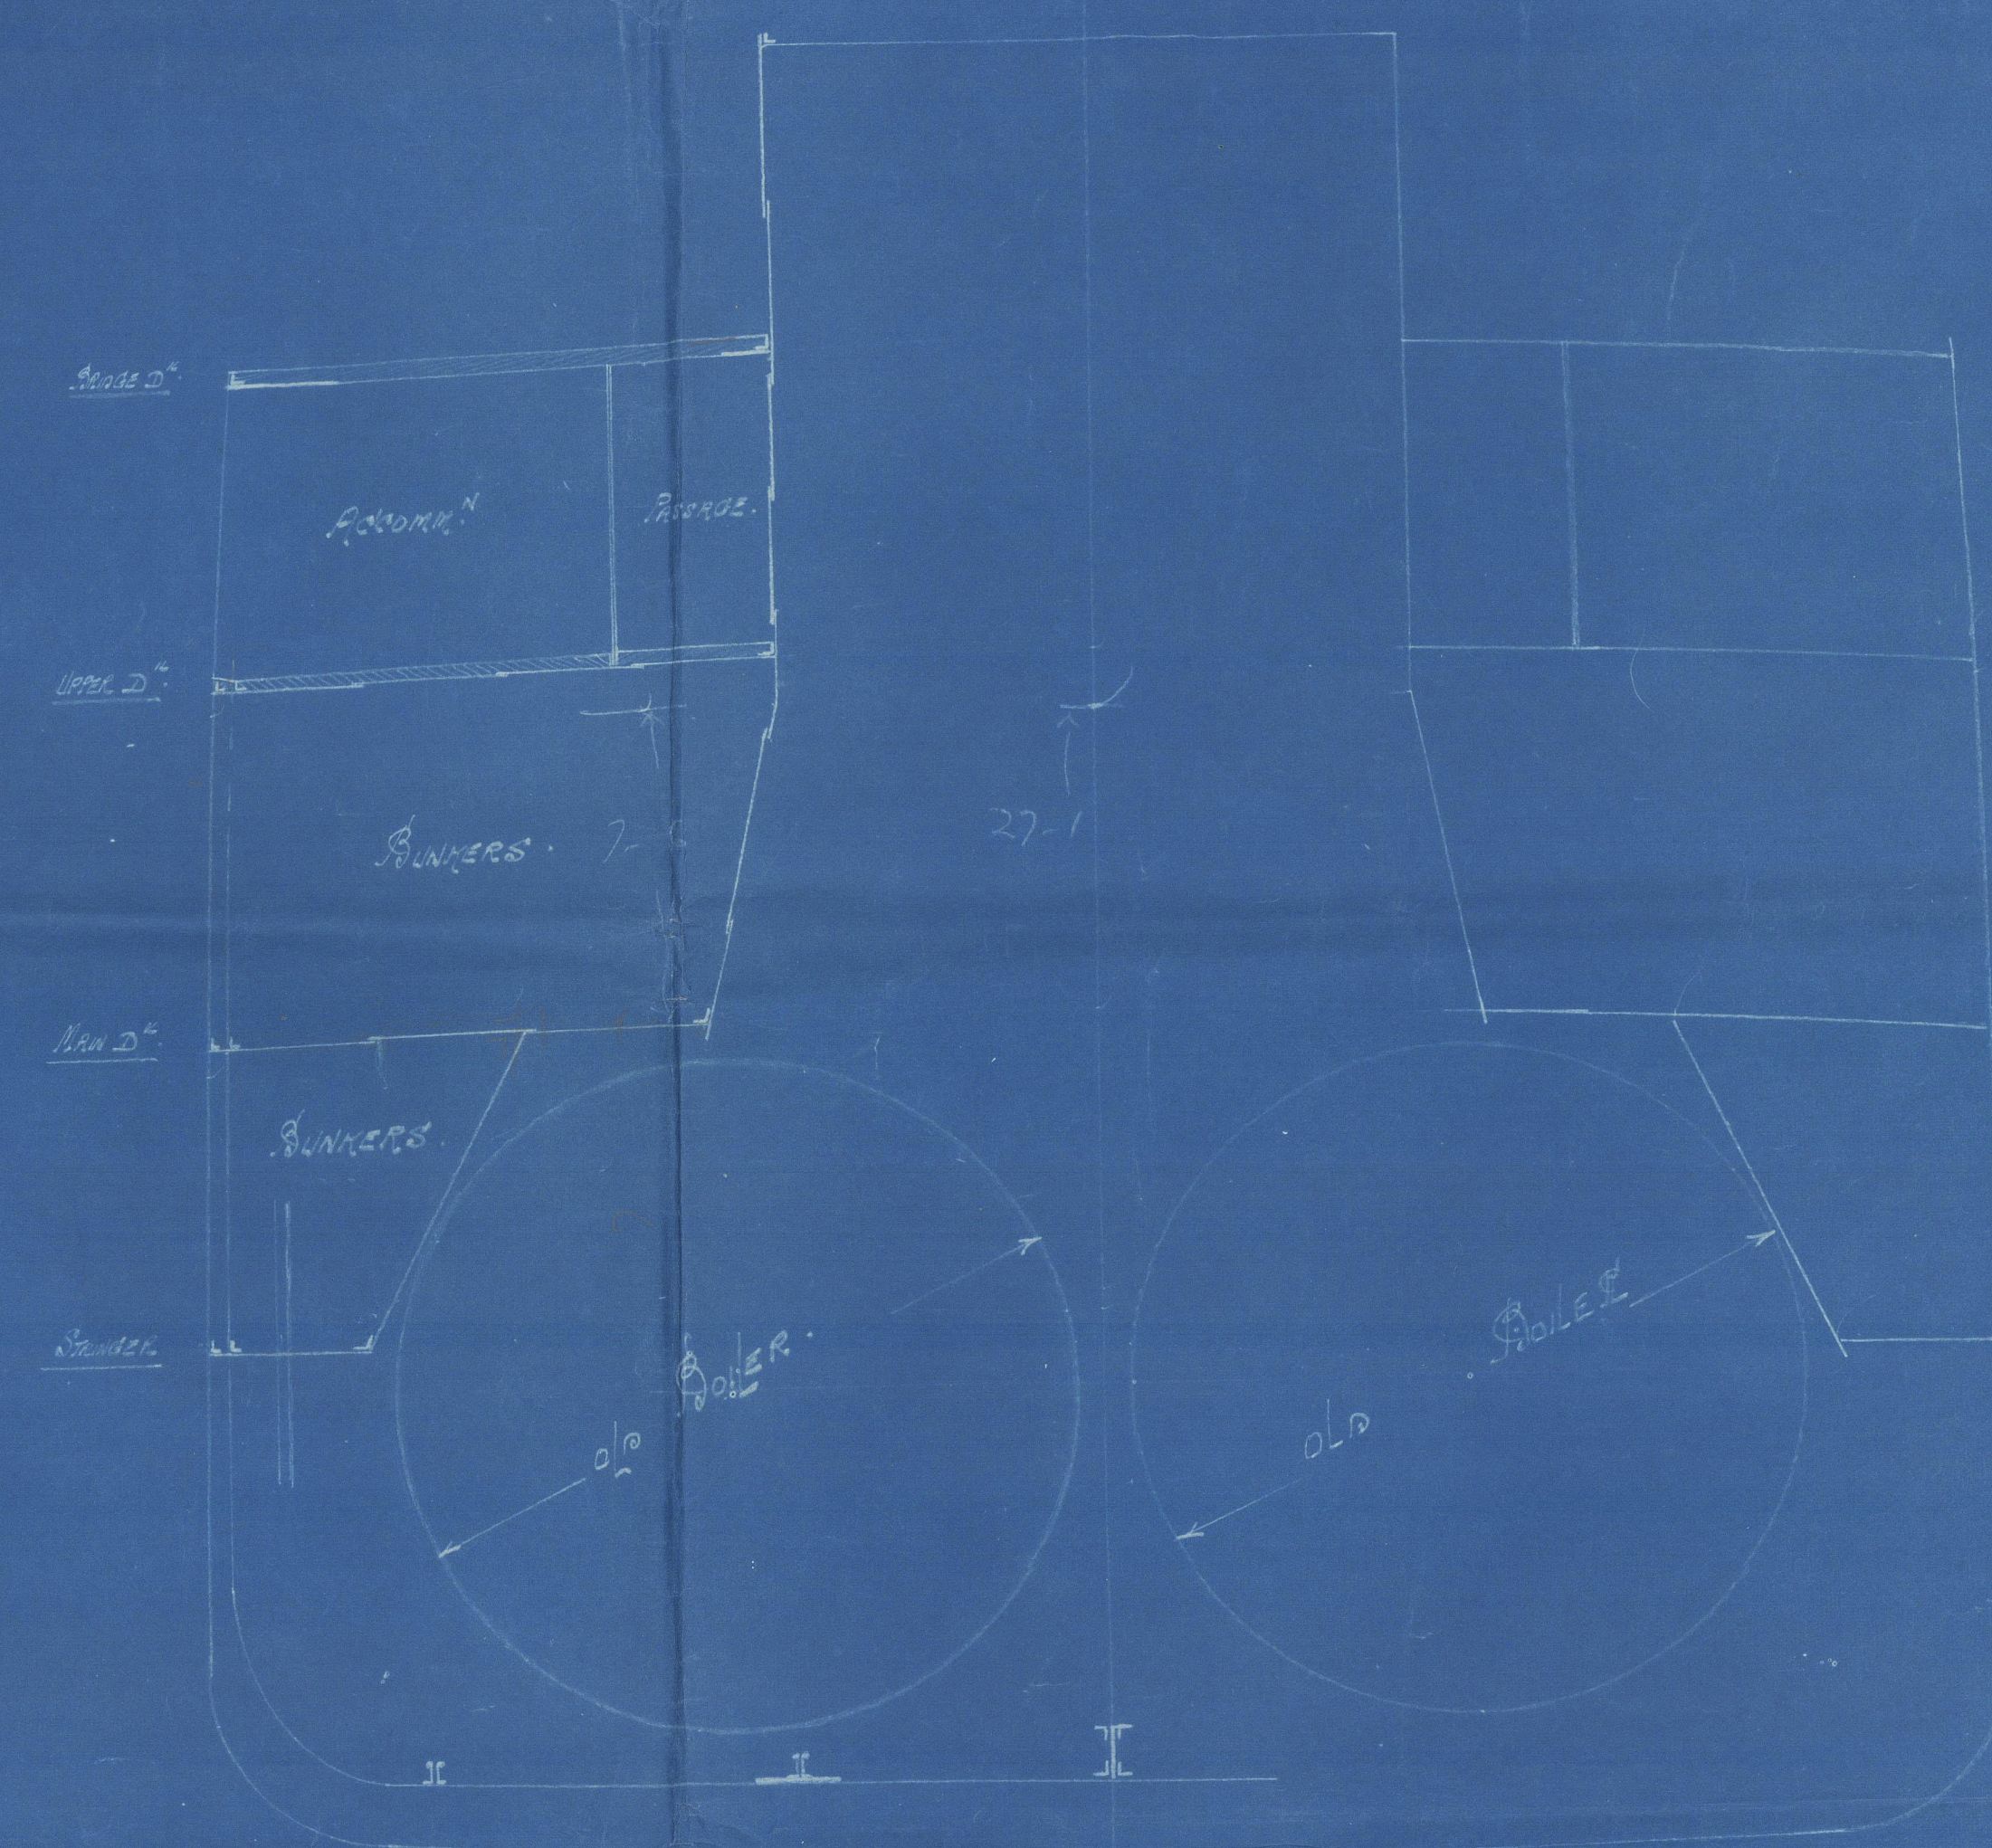


17.3.14

S. S. NGELI

Sketch showing present arrangement  
of Rooms in Longside E. S. Division

Scale  $\frac{1}{4} = 1 \text{ foot}$

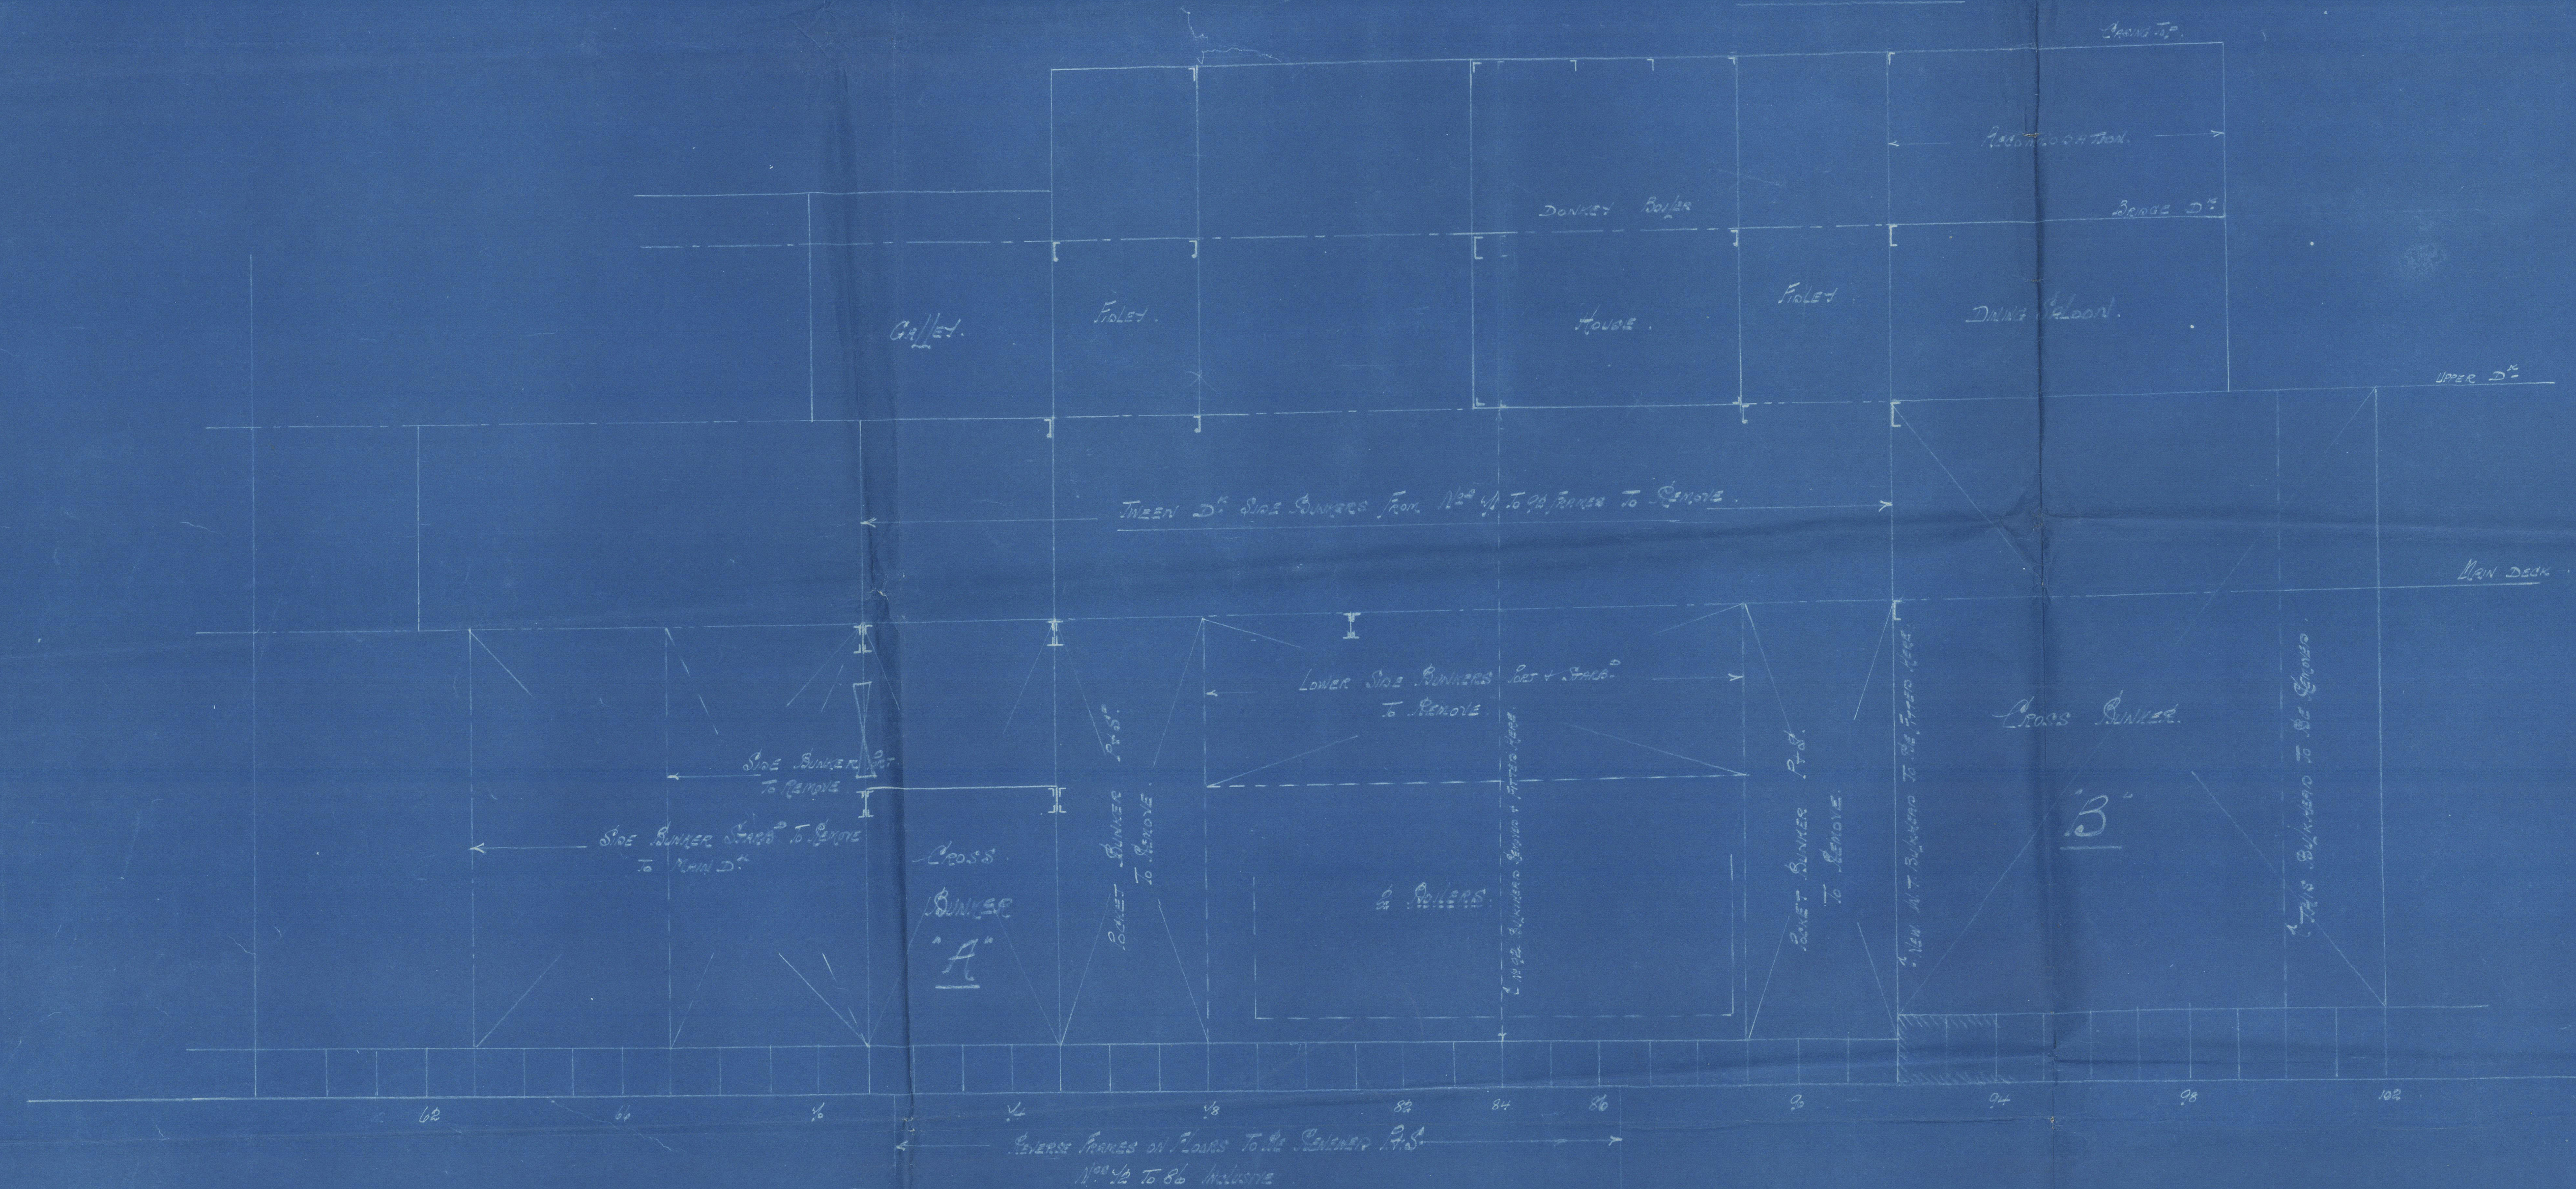

SECTION IN W. OF Boiler Room  
Looking Port



SECTION IN W. OF Engine Room  
Looking Port

12 MAR 1914  
RECEIVED IN THE  
NAVY OFFICE

17.3.14

NGELI-1-17



Present Arrangement  
Bole Space

S S Ingeli

Receipt No 66263.



© 2021

NWC 876-0090

Lloyd's Register  
Foundation