


6-7-97

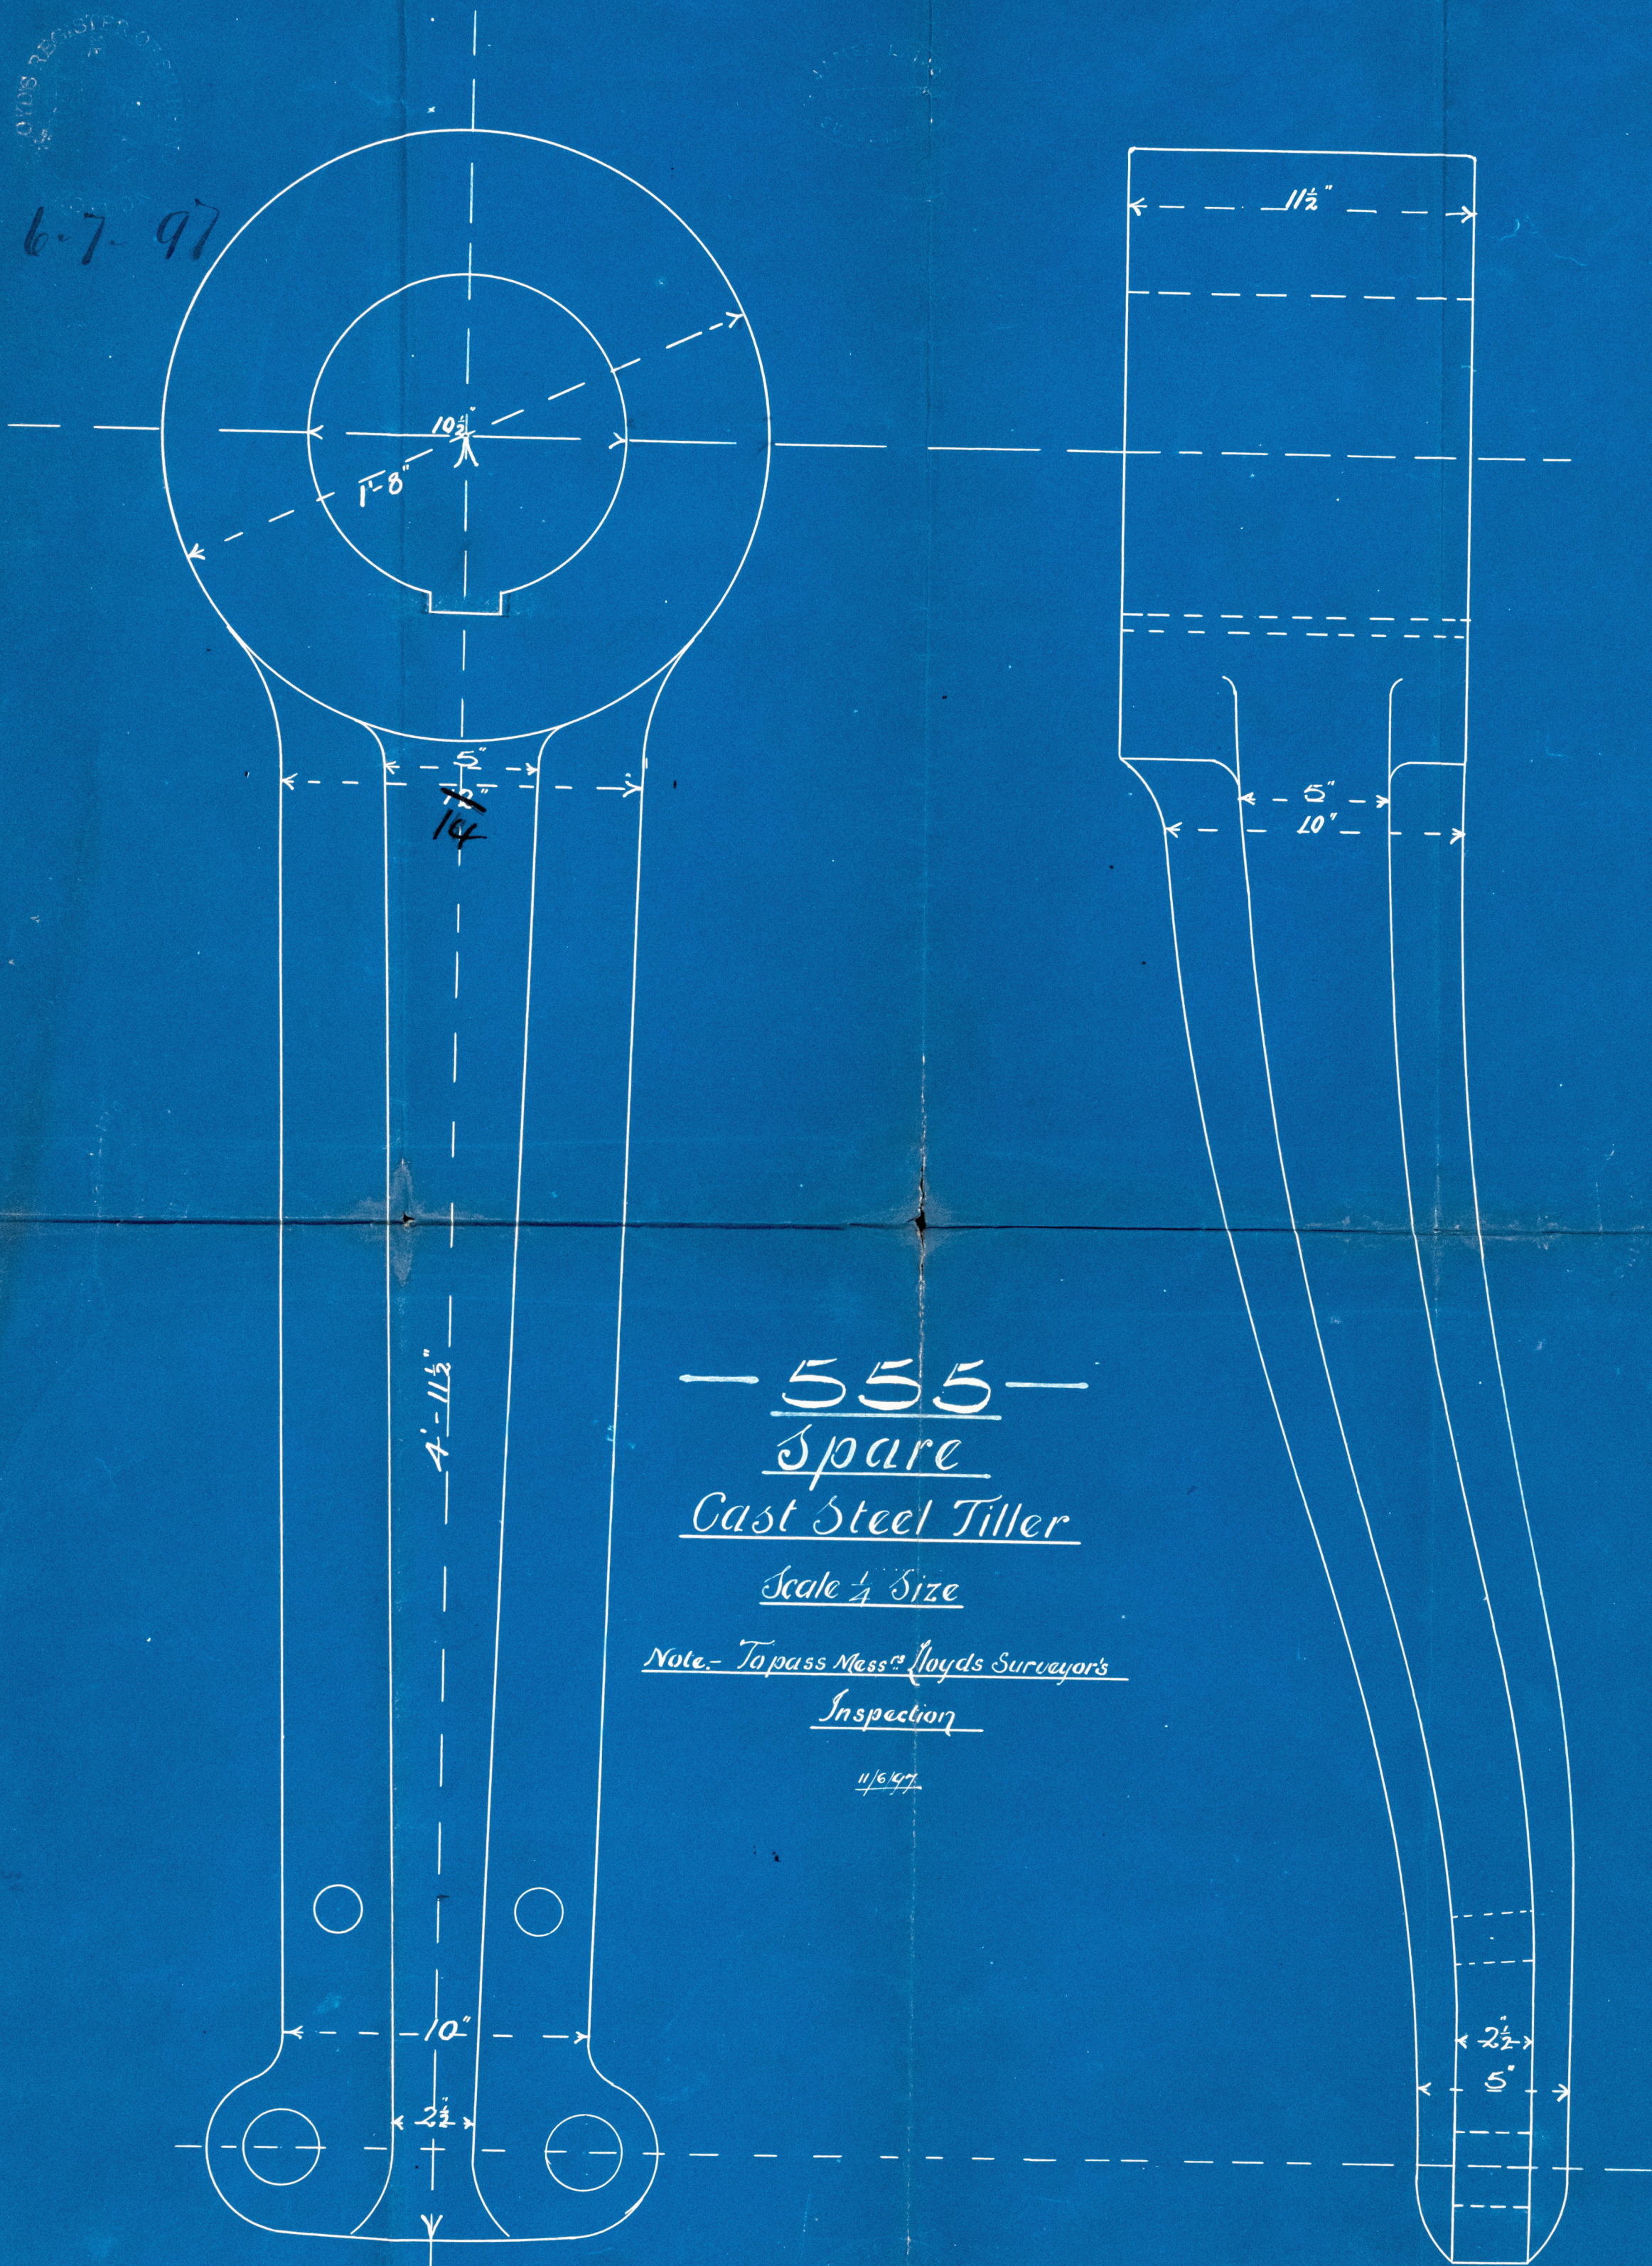


— 555 —  
Spare  
Cast Steel Tiller

Scale 1/4" Size

Note.- To pass Messrs Lloyd's Surveyors  
Inspection

11/6/97

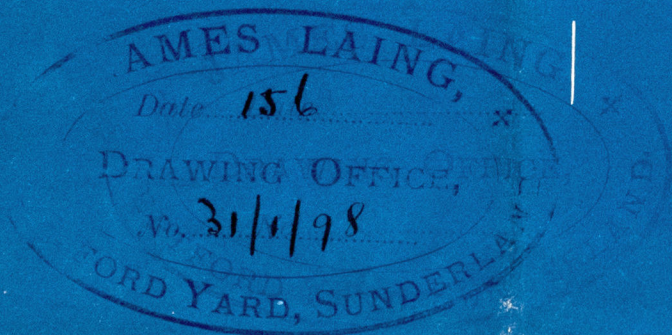

J.P.L.  
6/7/97





© 2021

Tracing 263.

Lloyd's Register

SLD1012 00162



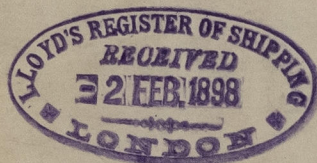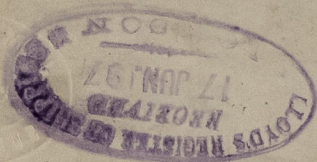

*Sir James Lamb*

*No. 555*

*Spare Tires.*

S.S. "TUSCARORA"  
SUNDERLAND. *Nº 19342*

SLD1012 - 0162



© 2021

Lloyd's Register  
Foundation

SLD1012 - 0162