


23. 9. 96
16. 12. 96

12/6
96

S. S. No 555

Scale $\frac{1}{8}$ " = 1 foot

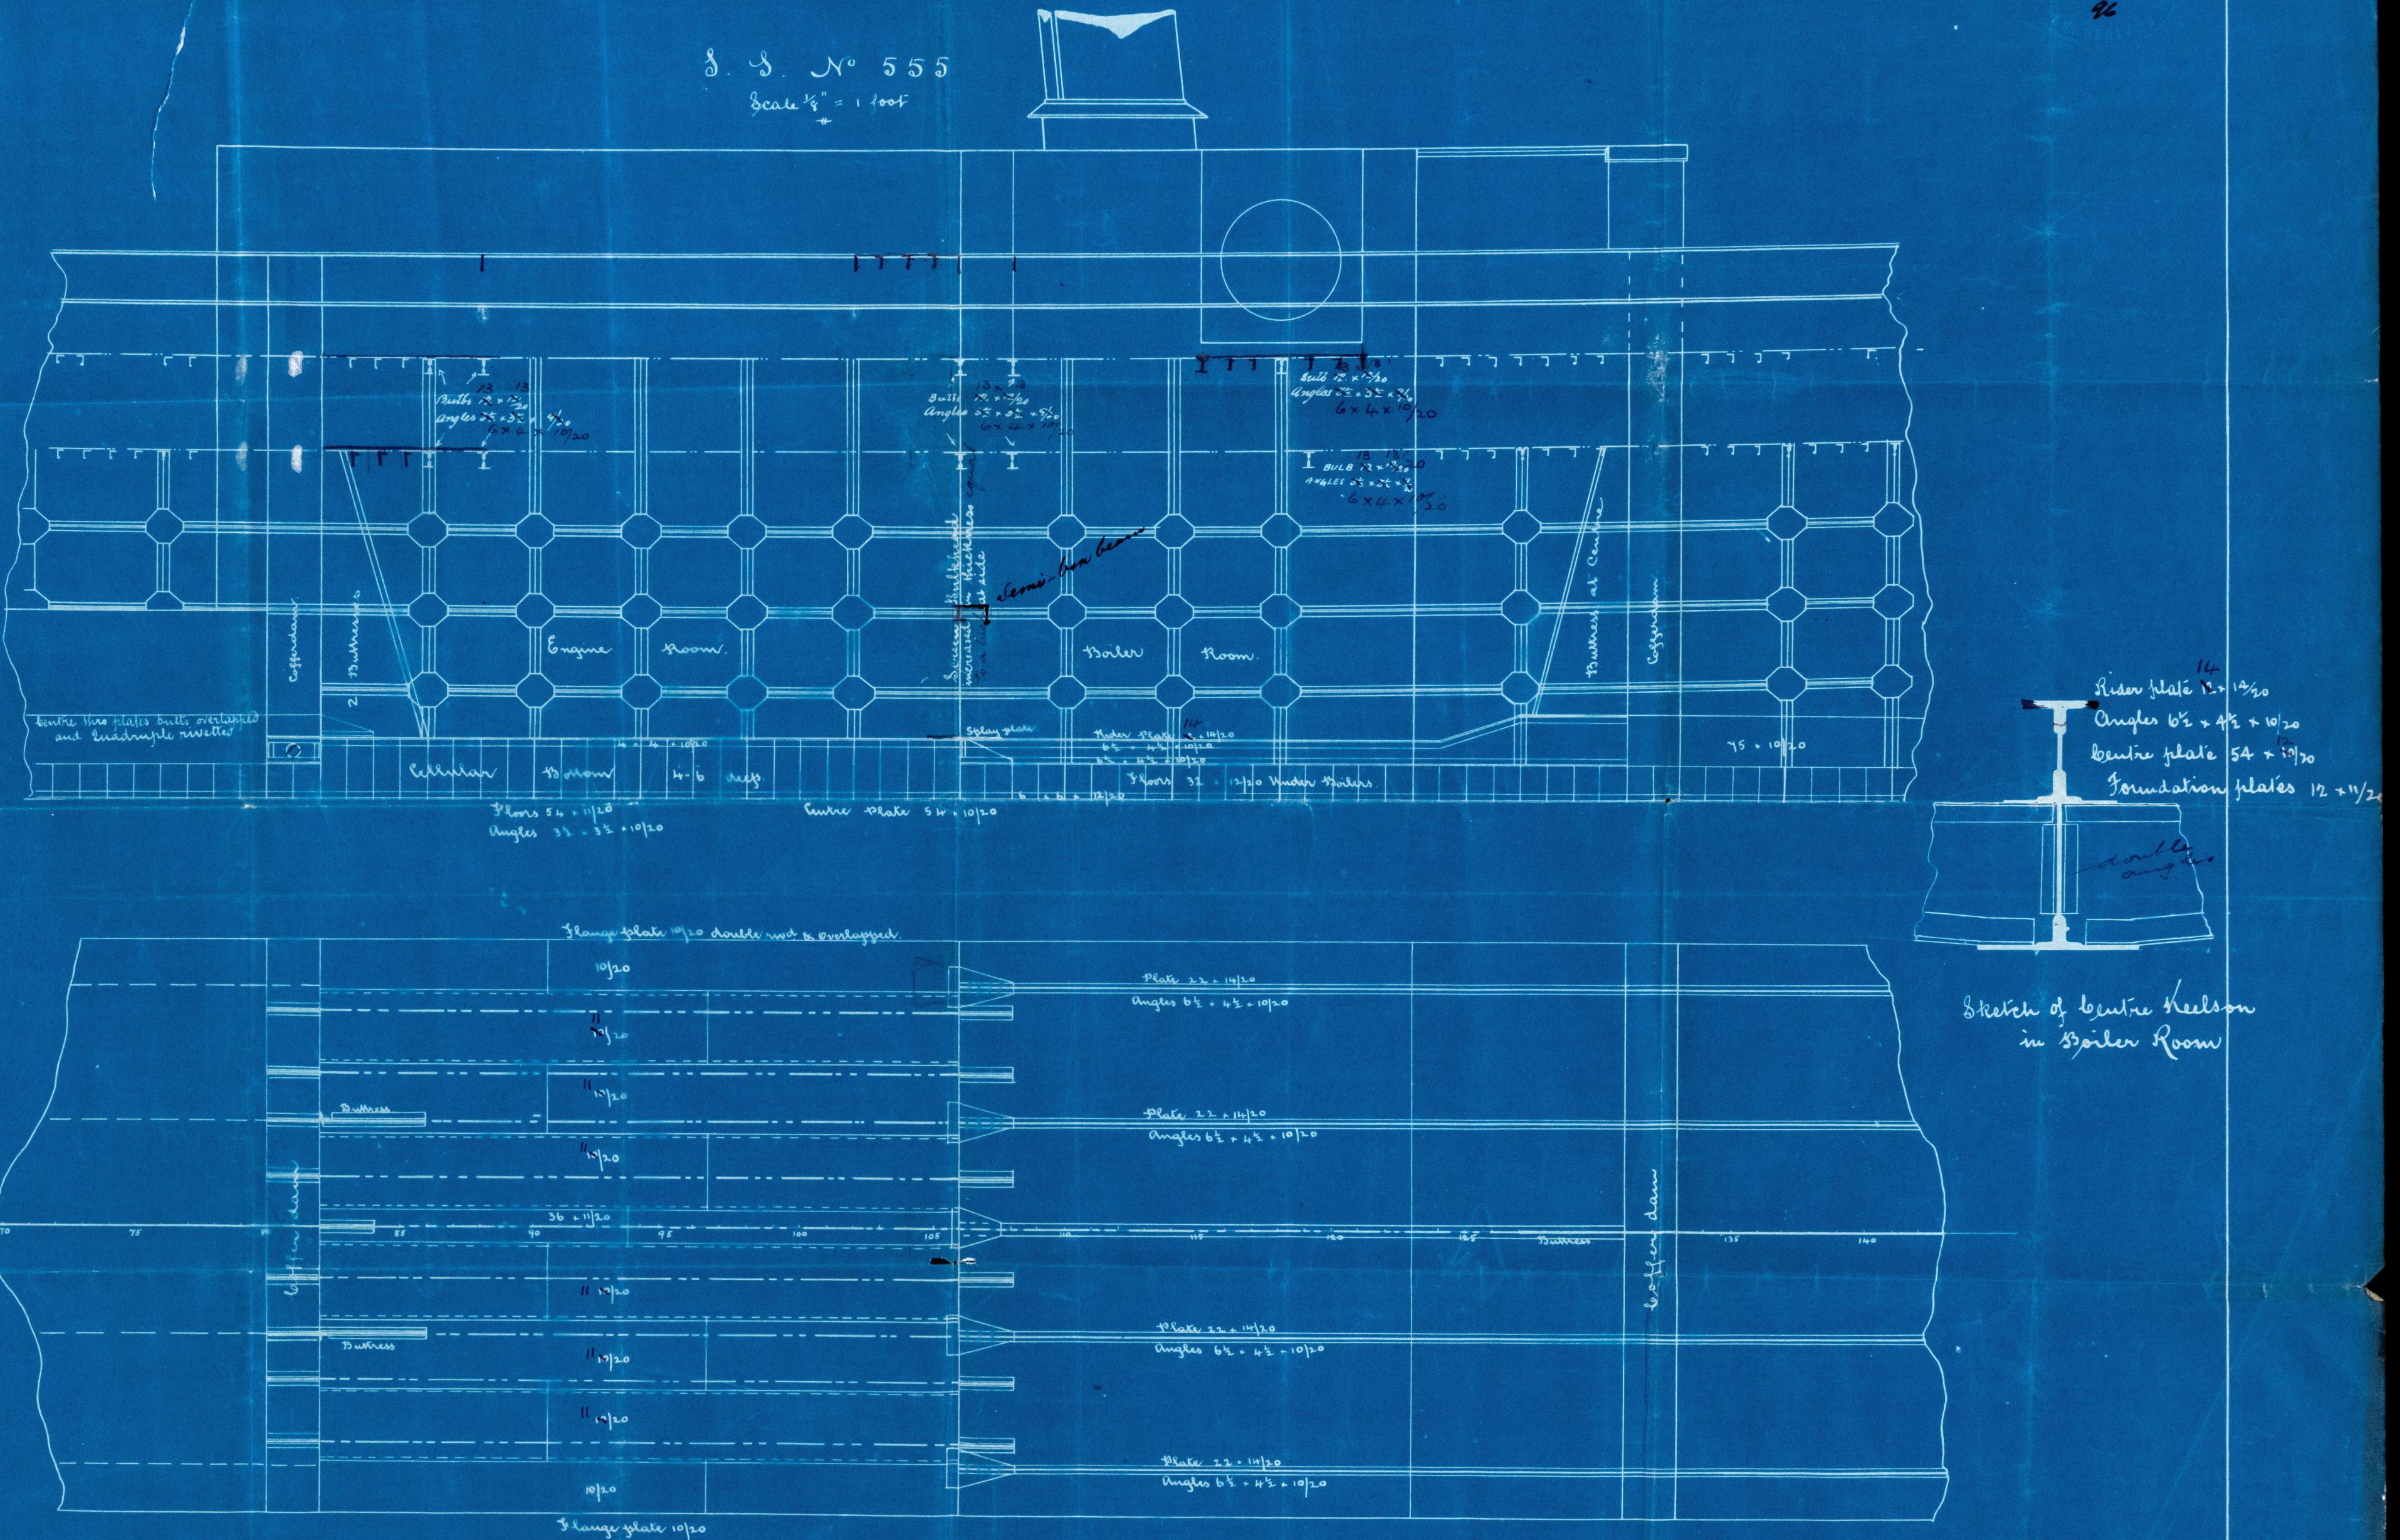

Bottom of bulk top overlapped and double riveted.
Edges double riveted.

JL
23.9.96

James Lang
Doverford Yards
Sunderland.

James Lain
N^o 355
Eygim & Roile Grace
Proprietor
S. S. "TUSCARORA"
SUNDERLAND. N^o 19342

SLD1012 - 0169



SLD1012 - 0169