

S.S. Nº 457.

AIR PIPES TO BE CARRIED UP THE
SIDE, BEHIND CARGO BATTENS

Messrs J. L. Thompson & Son Ltd

Pumping Arrangement.

Inv 457

s/s. "Arnell"

Sed F. L. Rpt No. 23428.


% 'Bunkburn'

Sld F. L. No. 24065.



Lloyd's Register

Foundation

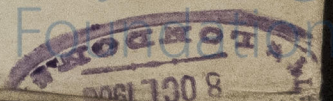

SLD1028-0130