


S. S. 457.

PROPOSED ALTERNATIVE ATTACHMENT OF
DOUBLE BOTTOM FRAMING
TO CENTRE KEELSON.


22. 10. 06
16. 10. 06

RULE ATTACHMENT,
A.

TANK WEBS TO CENTRE KEELSON $3\frac{1}{2} \times 3\frac{1}{2} \times \frac{8}{20}$ DOUBLE FOR $\frac{1}{2}$ LENGTH.
INTERMEDIATE BRACKETS TO C.K. $3\frac{1}{2} \times 3\frac{1}{2} \times \frac{8}{20}$ SINGLE ANGLES.
TRINETS $\frac{3}{4}$ DIA. THROUGH }
{ 7 RIVETS $\frac{3}{4}$ DIA. THROUGH WEB,
BRACKET IN SINGLE SHEER.

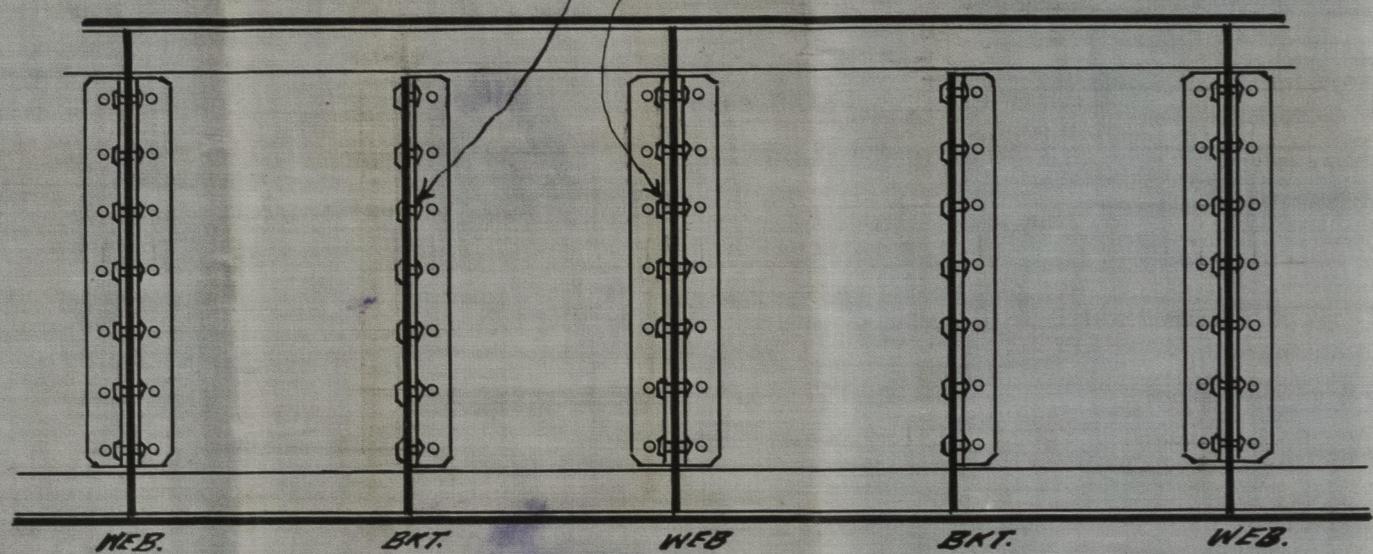


PLAN VIEW SHOWING
CONNECTIONS TO CENTRE KEELSON.

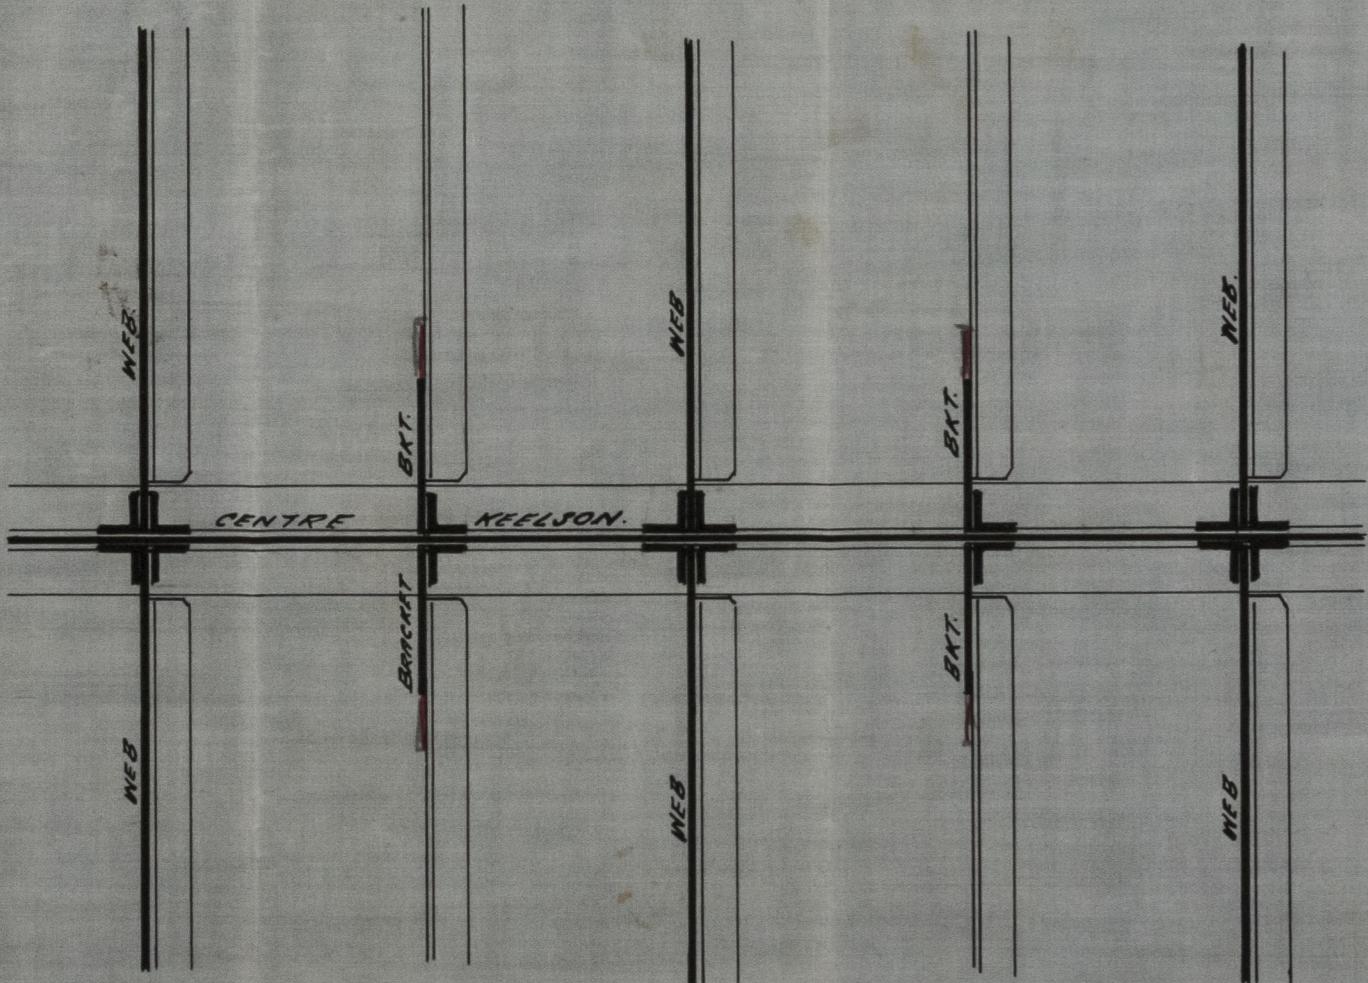


3823
457
16.10.06

PROPOSED ATTACHMENT,
B.

TANK WEBS & INTERMEDIATE BRACKETS TO CENTRE KEELSON
 $5 \times 5 \times \frac{11}{20}$ FOR $\frac{1}{2}$ LENGTH. $\frac{11}{10}$ RIVETS $\frac{7}{8}$ DIA. TO CENTRE KEELSON, HYDRAULIC RIVETTED.
 11×8 RIVETS $\frac{7}{8}$ DIA. THROUGH WEBS & BRACKETS IN SINGLE SHEER.

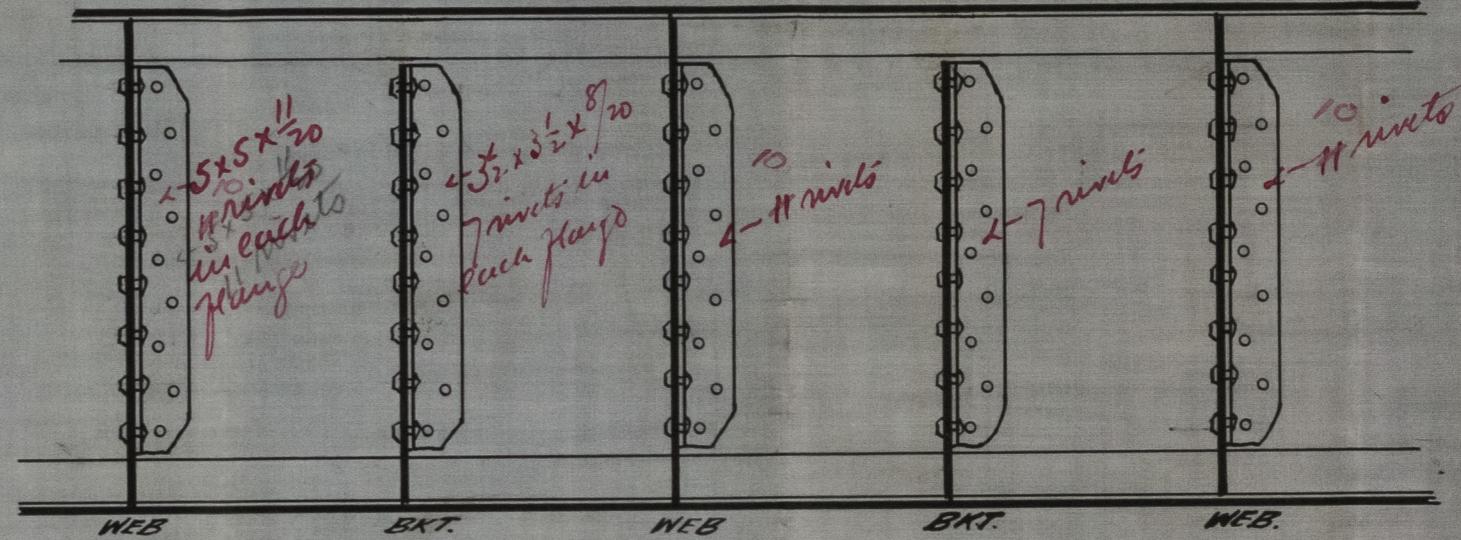

PLAN VIEW SHOWING
CONNECTIONS TO CENTRE KEELSON.

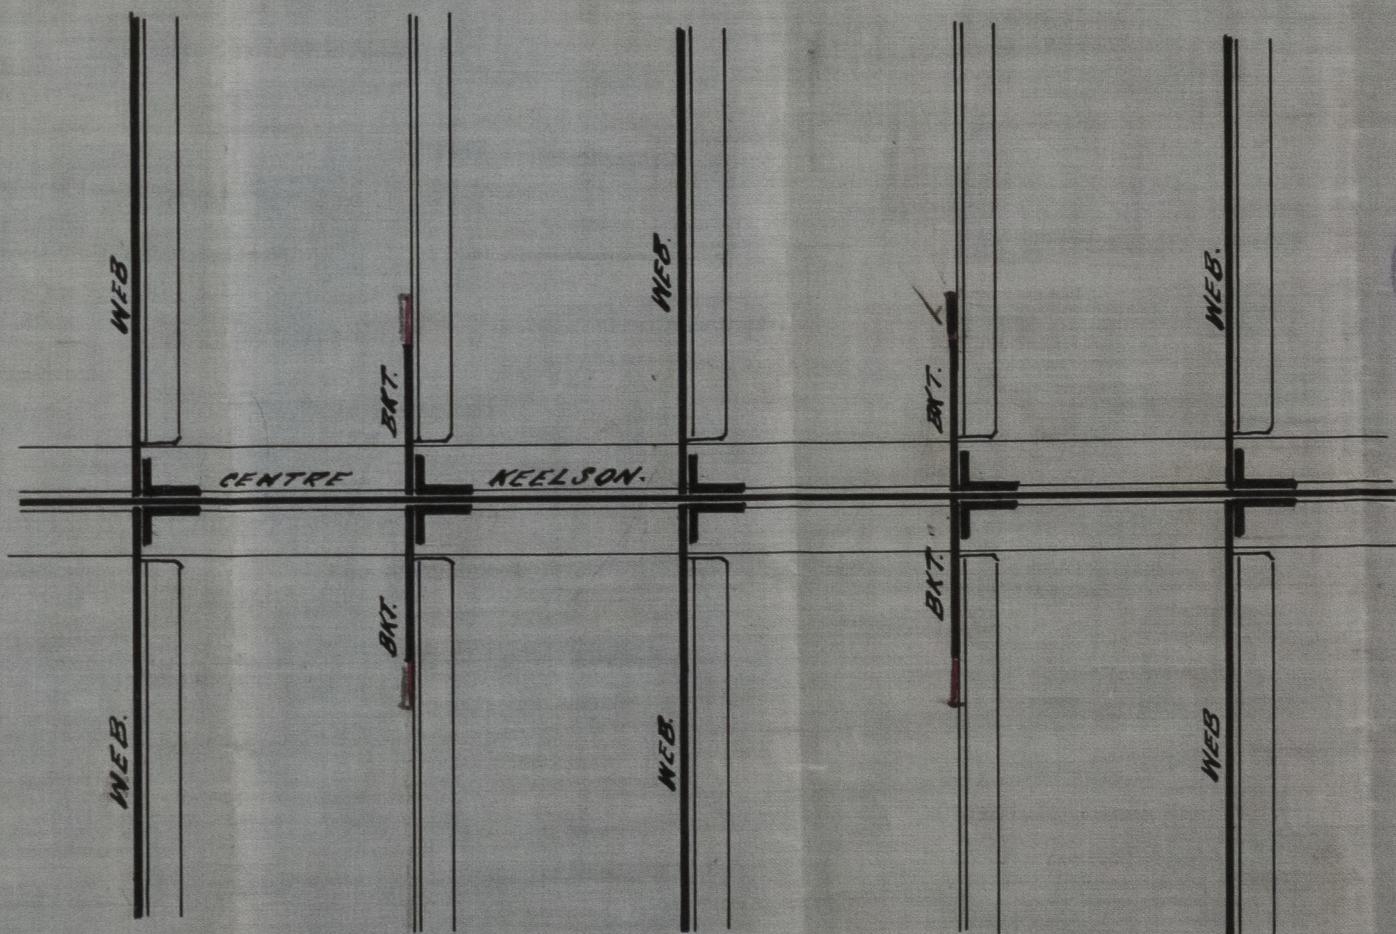

C.R.
22. 10. 06
16. 10. 06

~~Rev. J. L. Thompson~~

Attachment of plans to
Contractor's General


No 457

P.S. "Arnell"

Sla F. C. Rpt No 23428.

½ Brinkburn

Sla F.C. 24065

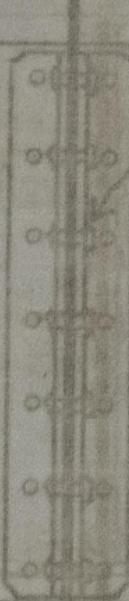

Lloyd's Register
Foundation