


hon^{rs}. Abington Sld. report no. 13.029

Dr. D. Sunderland
8/11/82.


AMENDED MIDSHIP SECTION
N° 143.

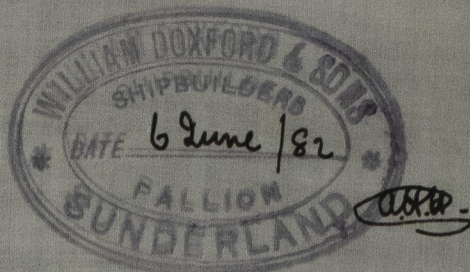

To class 100.A' at Lloyds. Three decked rule.

To be built under 1881 Rules.

Scale $\frac{1}{2}'' = 1 \text{ foot.}$

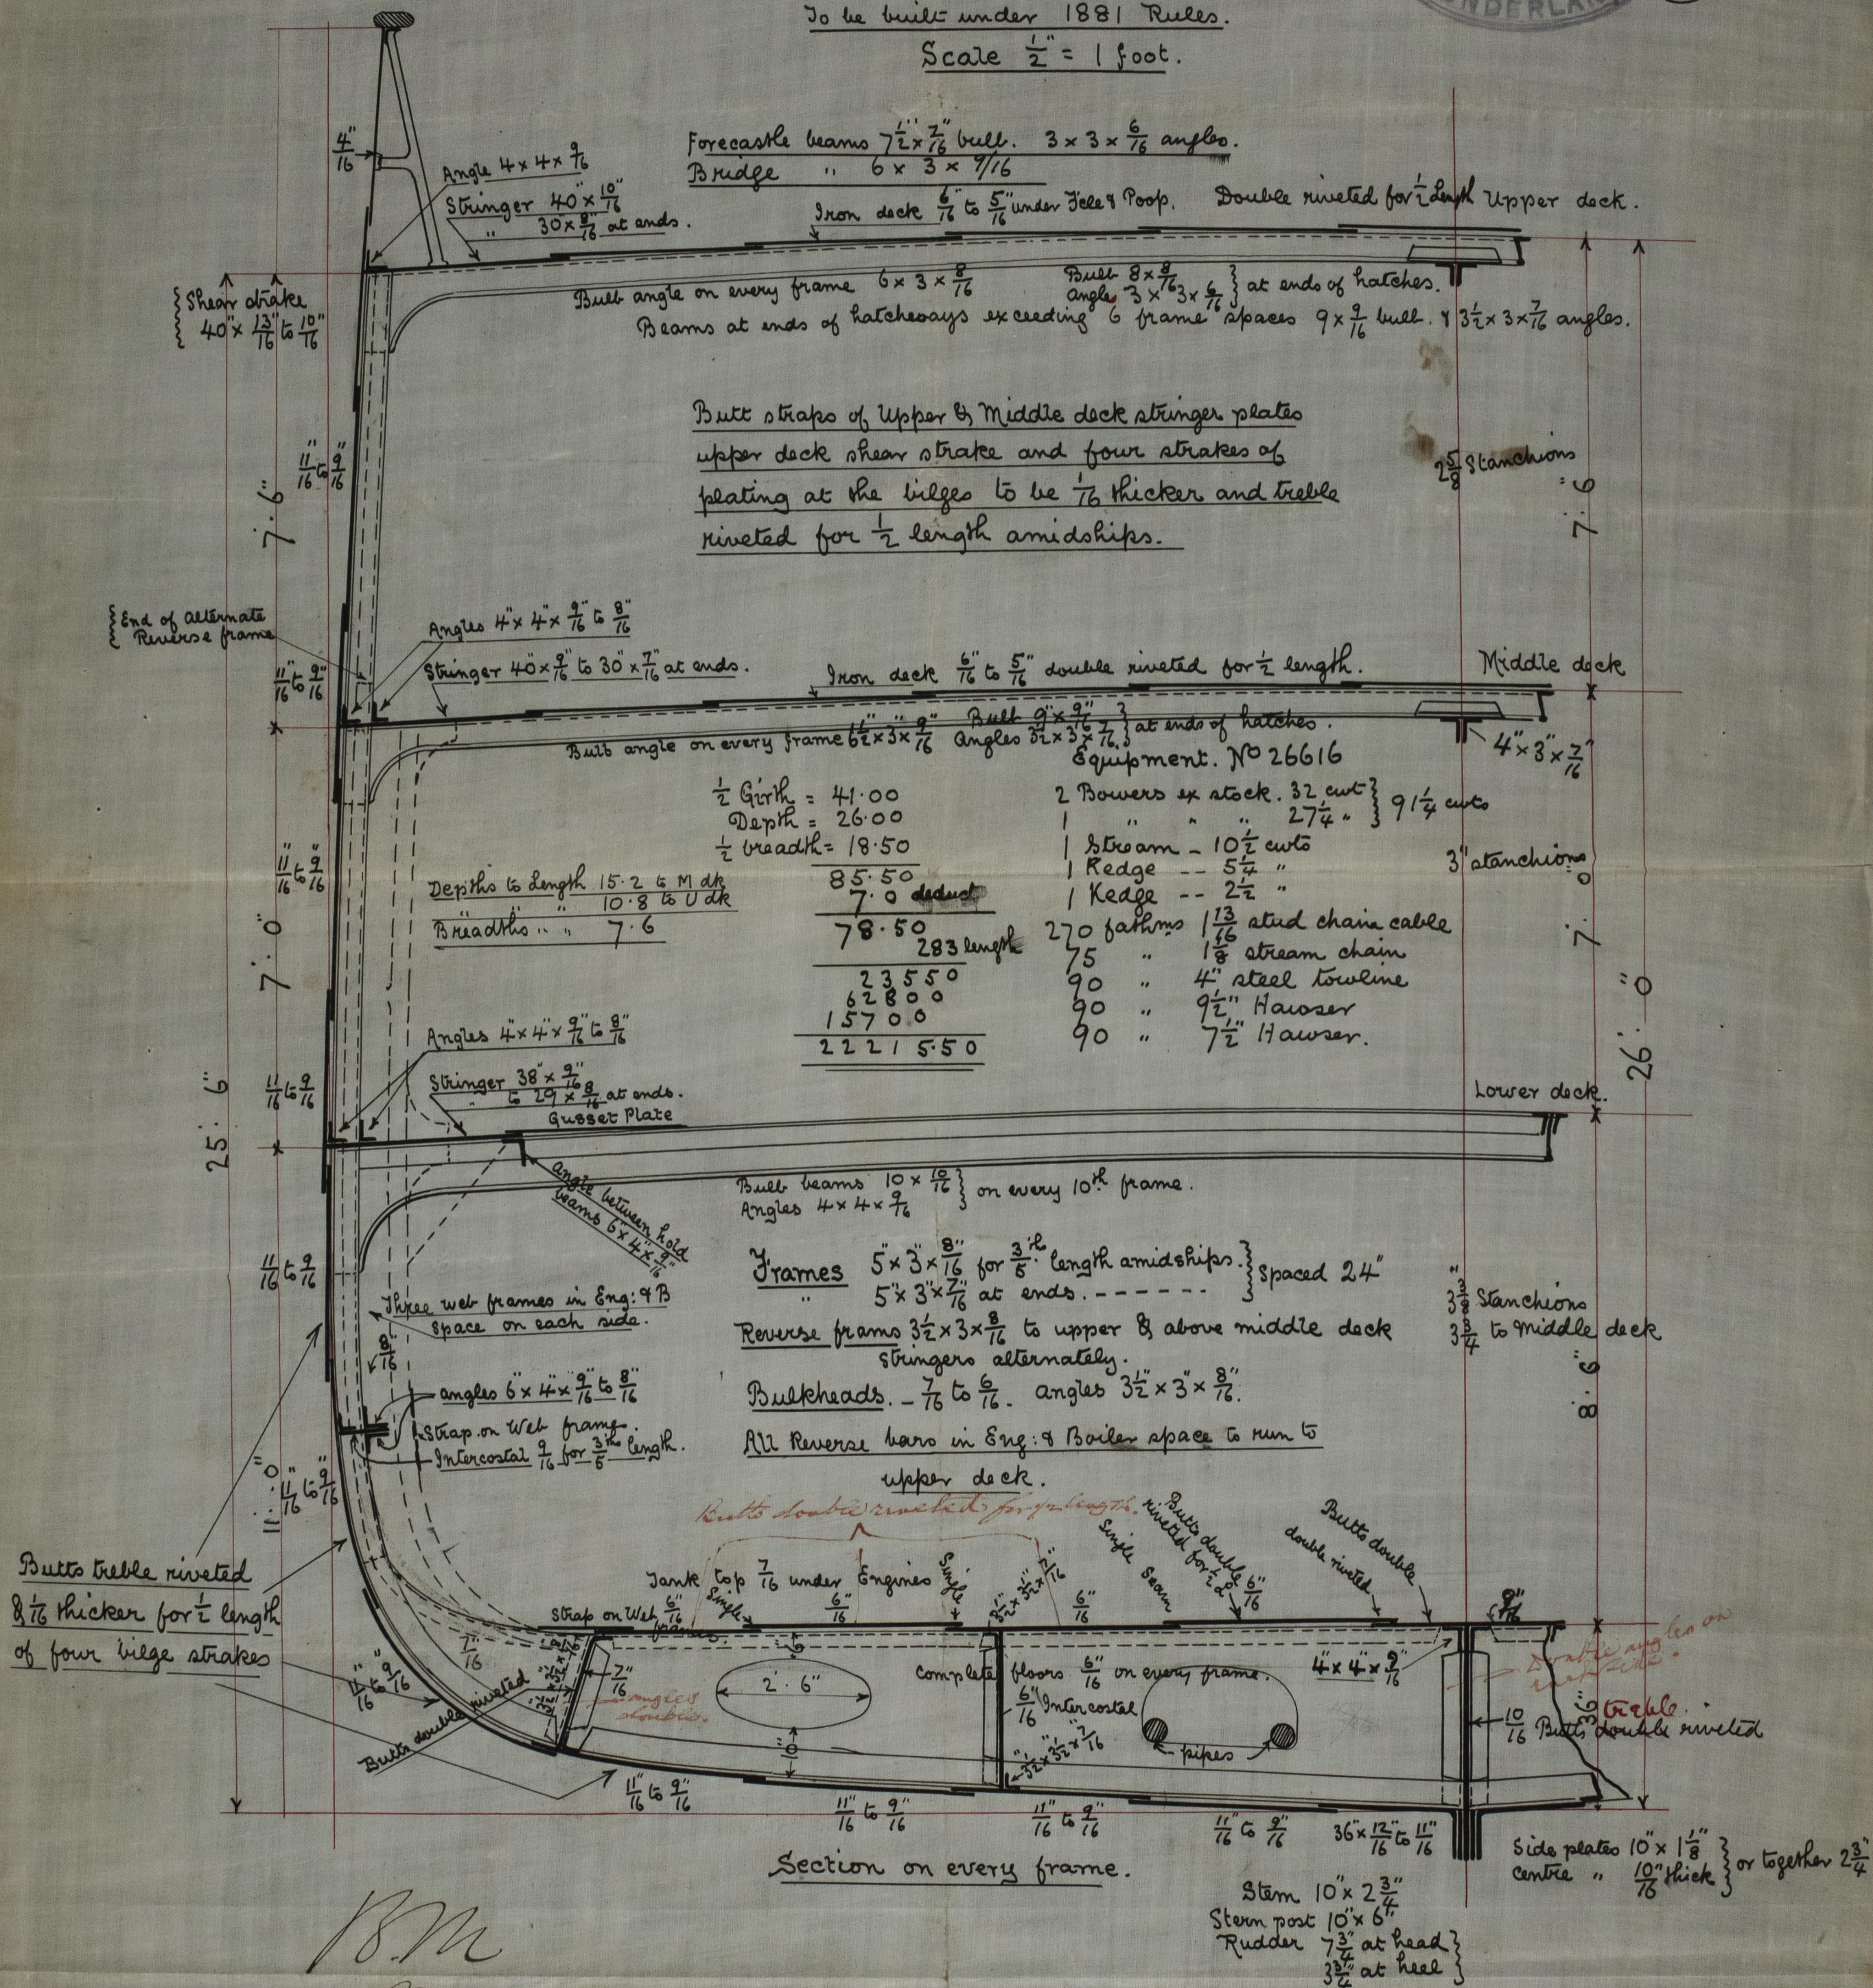

B.M.

77 f2