

S. S. Ataka

Received at West Hartlepool on 12th Jan 1889

Lloyd's Register of British and Foreign Shipping.

W. Pool

(Report on Vessel No. 232 Port W. Hapl.)

No. 984

SHIP FORGINGS OR CASTINGS.

The words FORGINGS or CASTINGS, IRON or STEEL, should be struck out if may be required.

I have to report that the undermentioned Iron or ~~Steel~~ Forgings or Castings, manufactured by

The Darlington Coy. Co. of Darlington

for the Vessel No. 232, being built by Messrs Roper & Sons

of Stockton have been inspected by me as set forth below, and found to be, so far as can be seen, sound


Mark on Forgings.

Lloyd's
No. 984
W. Pool

Wm. Cammell
Lunduland

	STERN FRAME.	RUDDER FRAME.	STEM.
Material*	<u>Scrap iron</u>	<u>Scrap iron</u>	
How made	<u>Fused</u>	<u>Fused</u>	
Dimensions	<u>11' x 4'</u>	<u>9' - 4 1/2"</u>	
Progress on Inspection	<u>Fused finished</u>	<u>Fused finished</u>	<u>Not seen</u>
Dates when Inspected	<u>Aug 4-9-21-25-30</u> <u>Sept 6-8/88</u>	<u>Nov 3-16-21-30 Dec 5</u> <u>6-12-19/88</u>	

SKETCHES OF FRAMES SHEWING POSITION AND DESCRIPTION OF WELDS OF FORGINGS, OR PARTICULARS OF TESTS APPLIED TO CASTINGS.

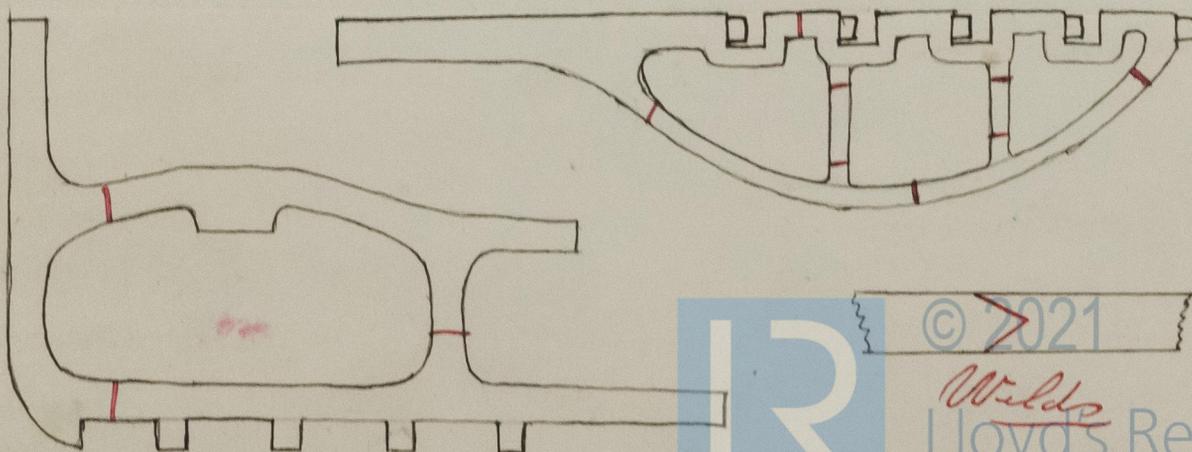

© 2021

Welds
Lloyd's Register
Foundation

984