

Single Screw Cargo Steamer.

No 112. 115, 116,

Midship Section.

Dimensions: 178'-0" x 28'-9" x 13'-3"

To Class 100A1 at Lloyd's Raised Quarter Deck.

Scale: $\frac{1}{2}$ " = 1 Foot.

Lloyd's Numerals.

B	=	28.75
D	=	13.25
B+D	=	42.00 = TRANSVERSE
L	=	178.00
L x (B+D)	=	7476.00 = LONGITUDINAL NO
d	=	10.75 = MAIN DECK.
a	=	13.75 = RAISED QUARTER DECK IN WAY OF DOUBLE BOTTOM.
d	=	14.40 = " " " " FLOOR PLATES.

PROPORTIONS.

OF	=	13.42 MAIN DECK
OF	=	10.95 QUARTER DECK.

Equipment.

RAISED QUARTER DECK	112.5 x 3 =	337.50
BRIDGE DECK	11 x 7 x 75 =	57.66
FORECASTLE DECK	23 x 7 x 75 =	120.75
CASINGS	525 x 7 x 5 =	183.75
2 ND NO		= 7476.00
EQUIPMENT NO		= 8175.66

3 BOWER ANCHORS (STOCK LESS) 48 CWT. COLLECTIVE WEIGHT.

1 STREAM ANCHOR 43 "

1 KEDGE " 24 "

180 FATHOMS OF $\frac{1}{2}$ " STUD LINK CHAIN CABLE.


75 " " $\frac{3}{4}$ " STEEL WIRE TOW LINE.

90 " " $\frac{3}{4}$ " " HAWSER.

60 " " 3 " " STREAM LINE

90 " " $\frac{1}{2}$ " " " WARP.

OWNERS CONSENT TO STEEL WIRE.

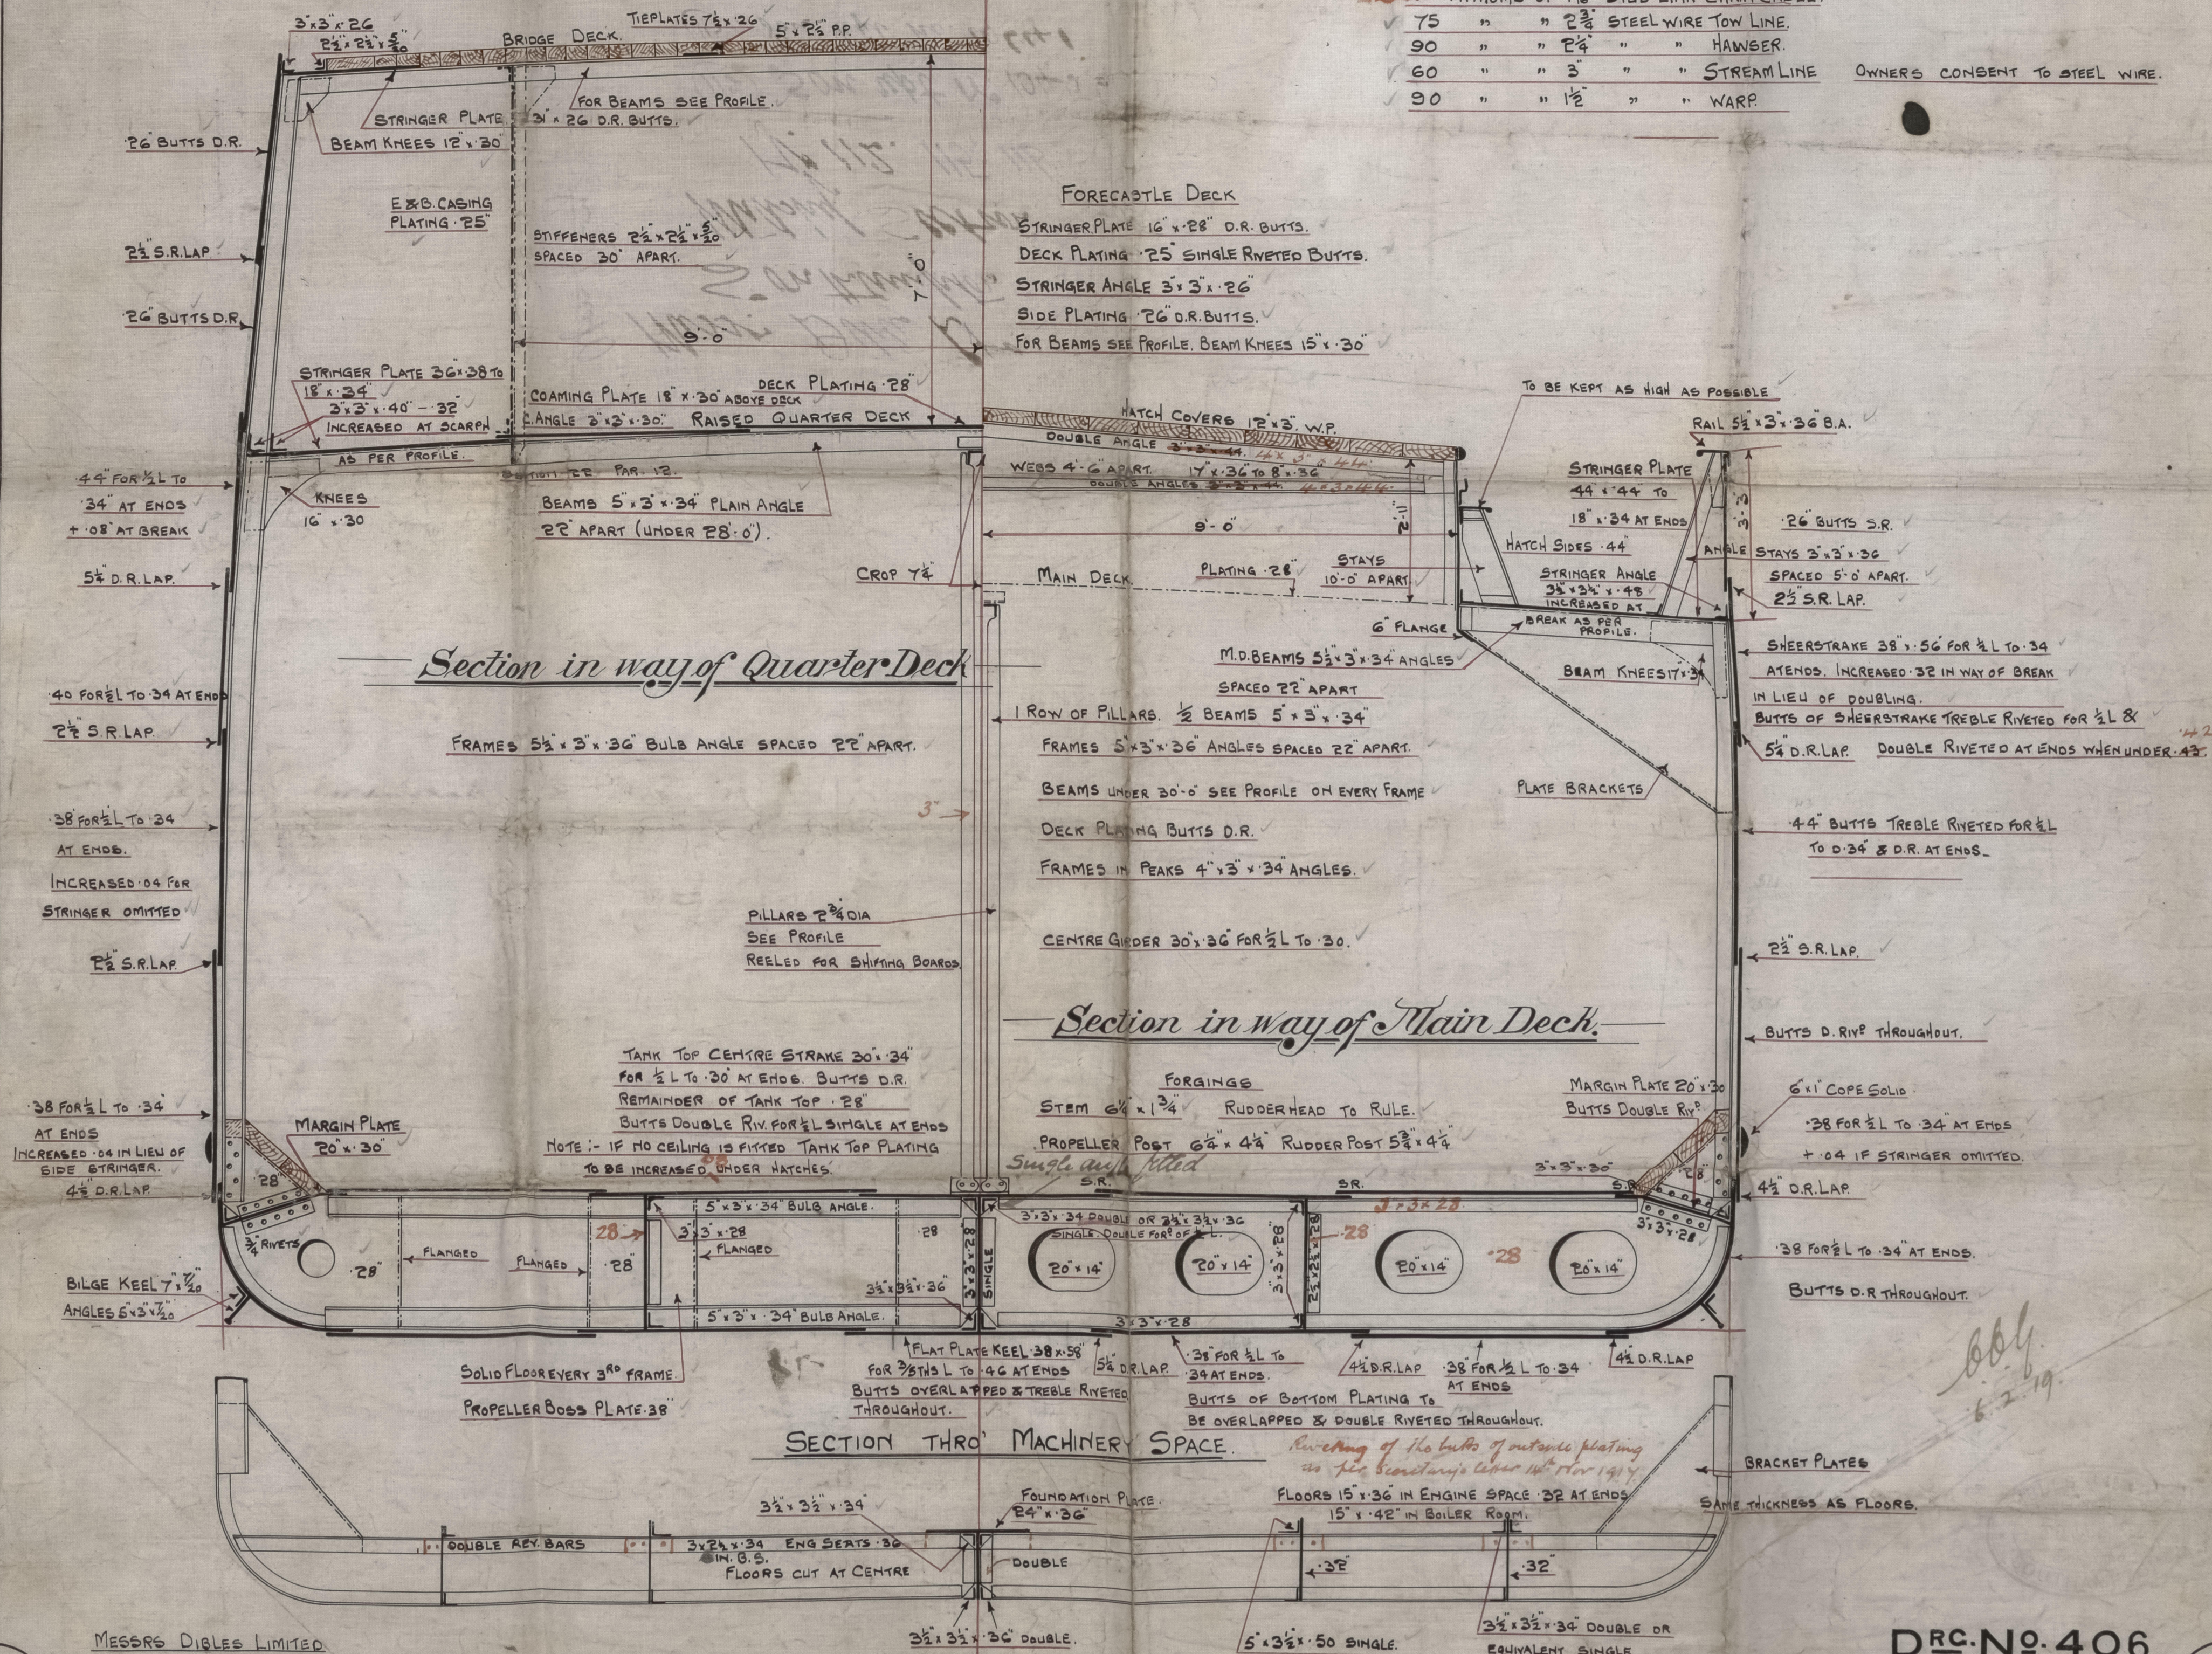




No. 112. 115, 116.

(112) Son rpt No. 10456

(115) Son. Rpt. No. 10641

Report No 10947.



© 2021

Lloyd's Register
Foundation

W10039