

Nº154

PROFILE & DECK PLAN


DIMNS 154'-0" x 30'-0" x 14'-2"

SCALE 1/8" = ONE FOOT

TONNAGE COEFF. .76




SHEER

AT FORE PERPEND = 4.75
AT AFT " = 2.34
AT 1/8 FROM F.P. = 2.84
AT 1/8 FROM A.P. = 1.34

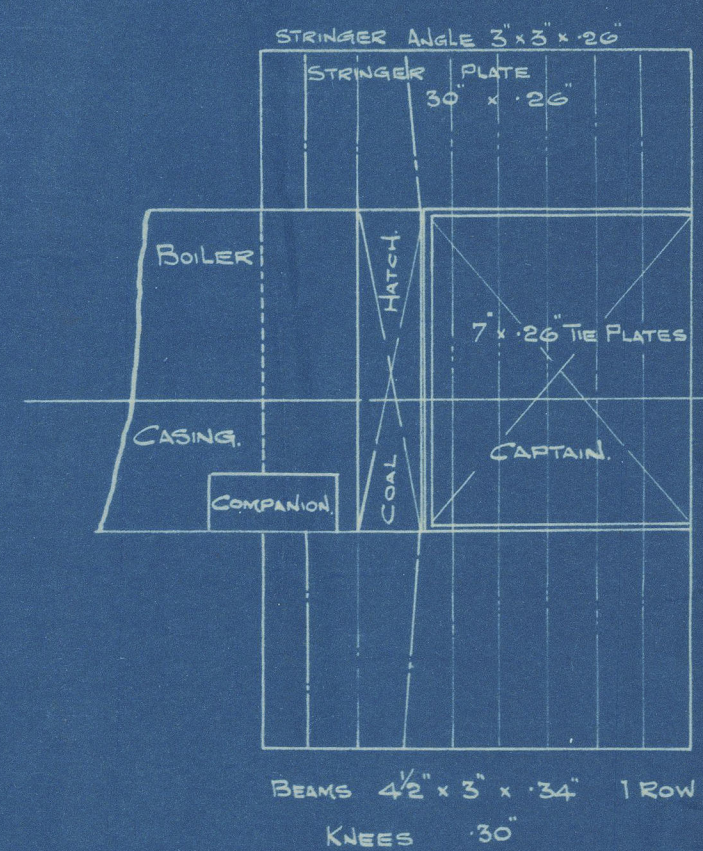


Supports under windlass, winches made as to Engineer's satisfaction.

DECK TO BE SUPPORTED UNDER WINDLASS, WINCHES, MASTS ETC.

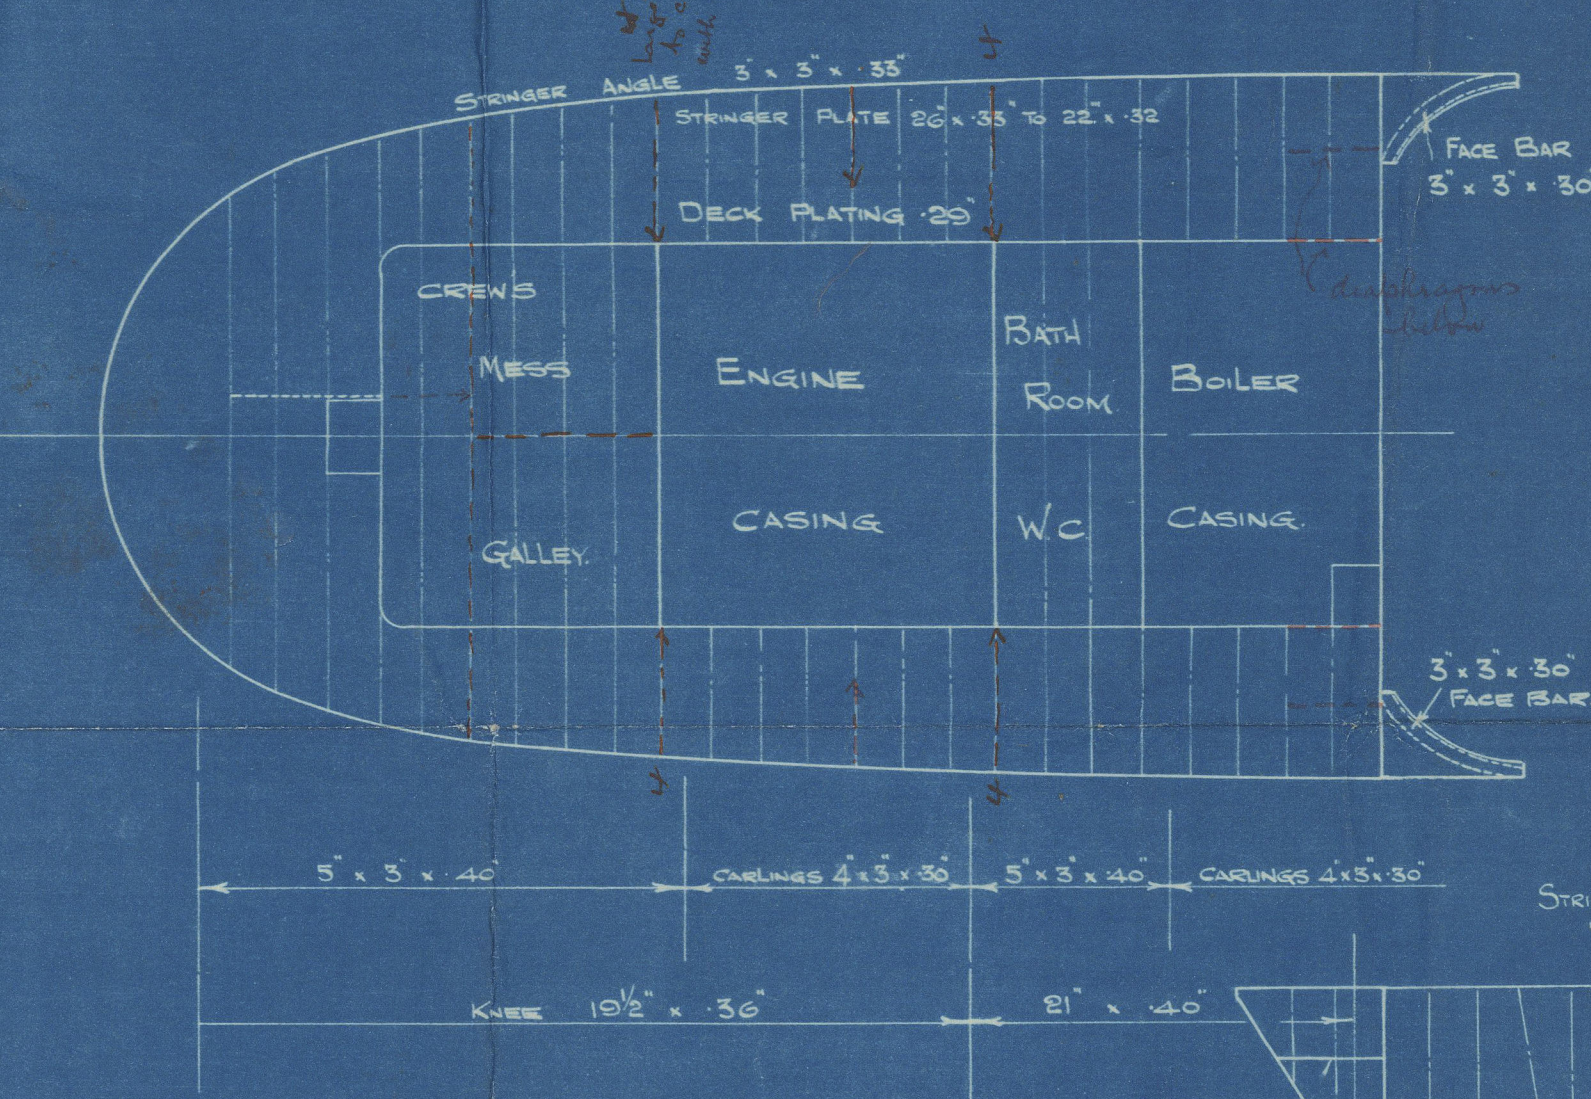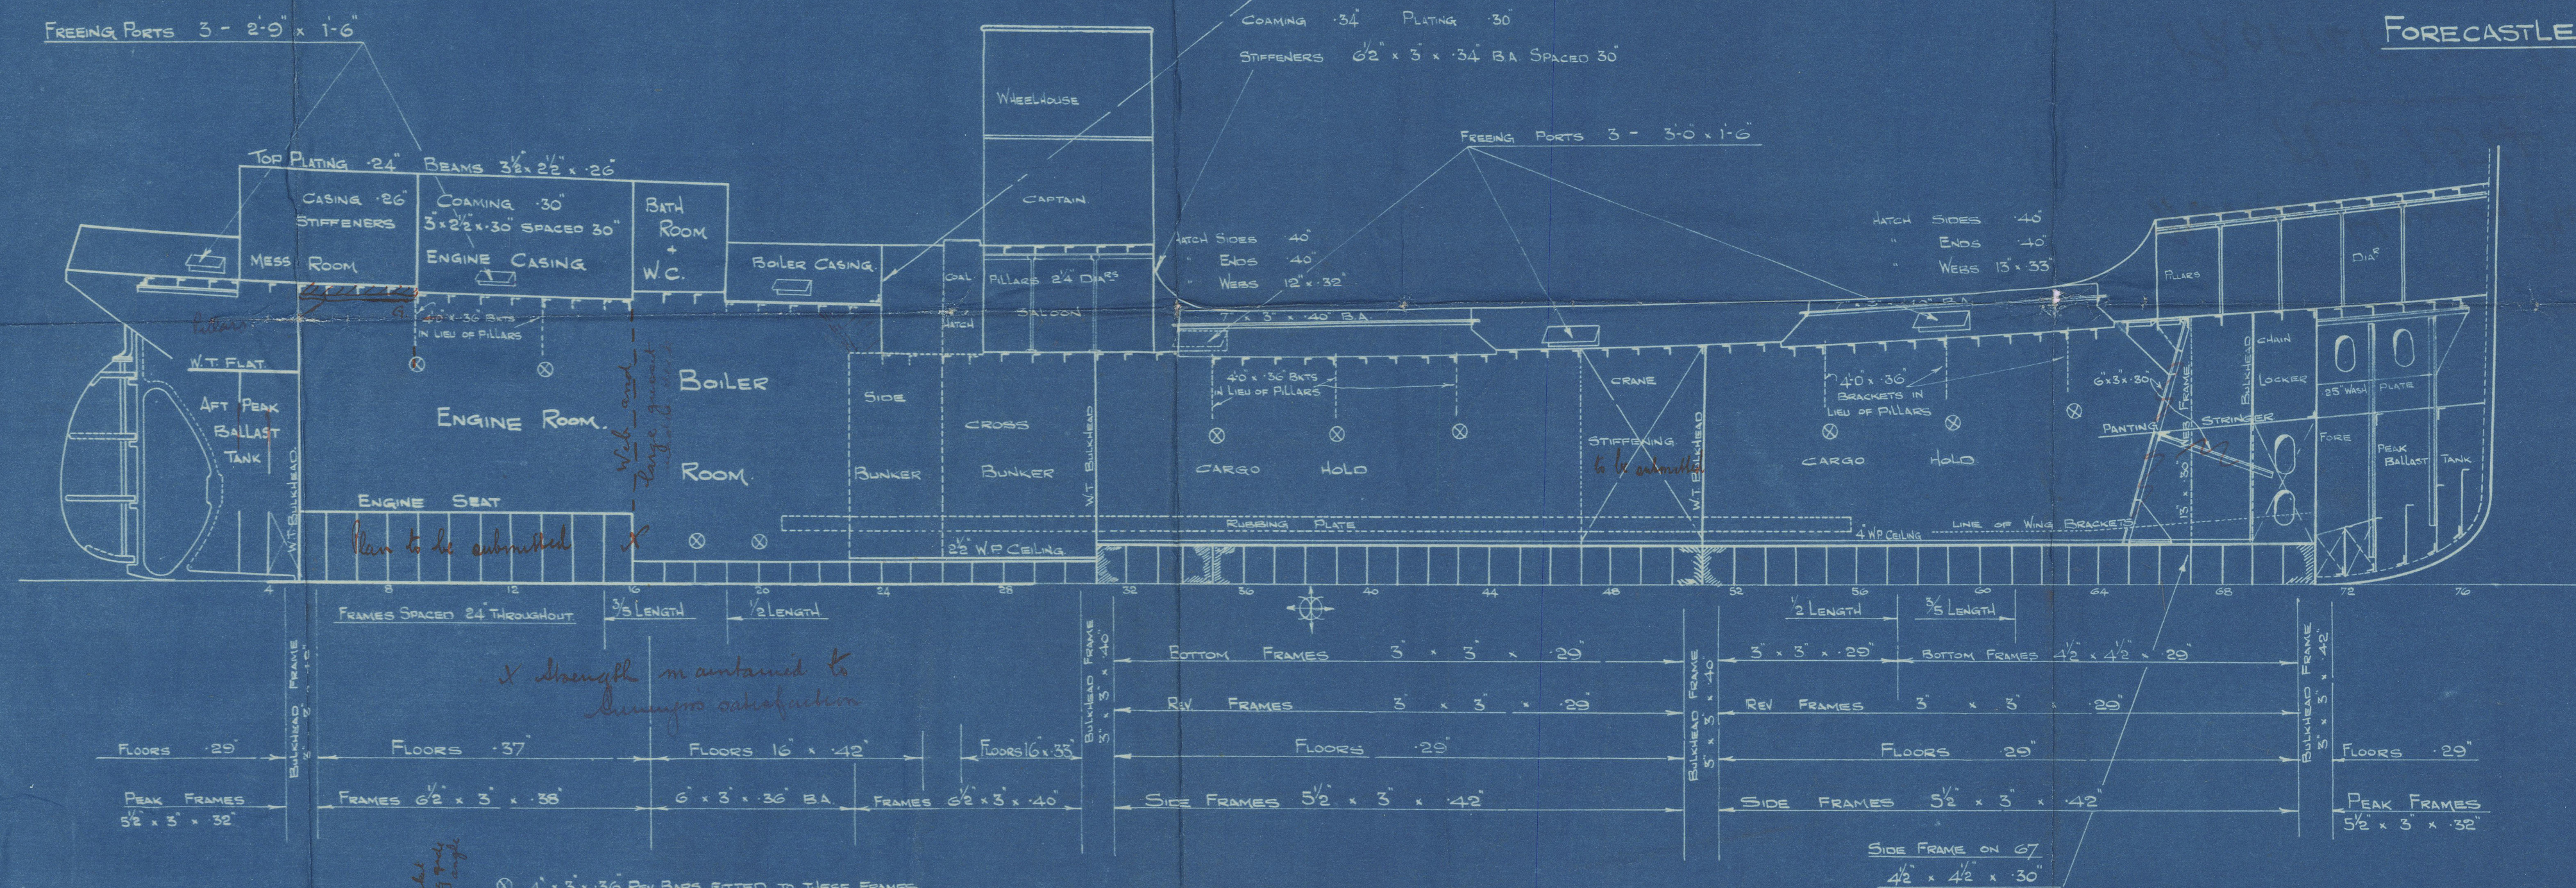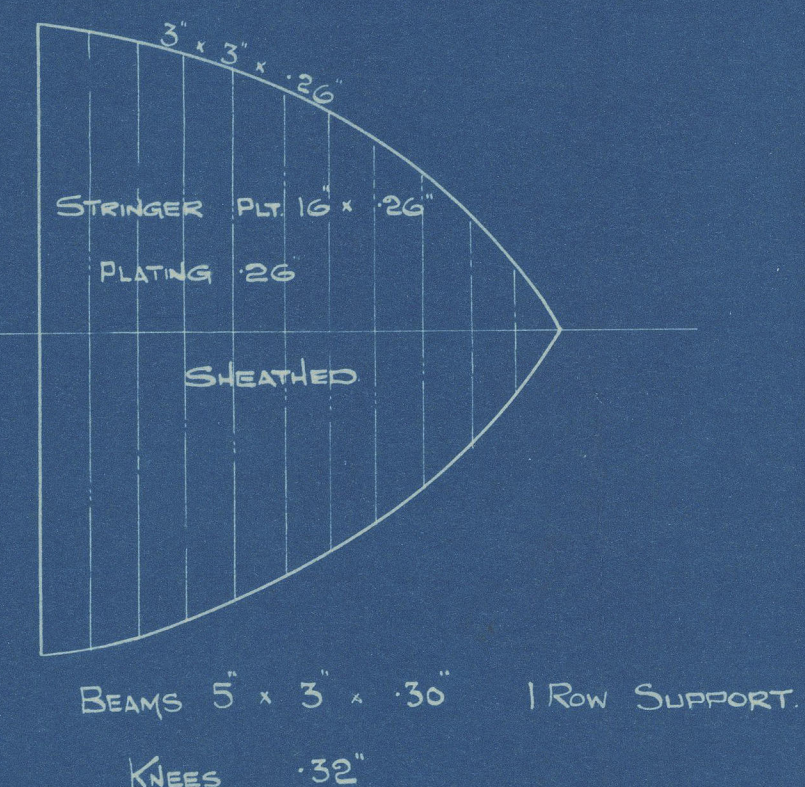


DETAIL OF DIAPHRAGM AT BREAK SCALE 1/4" = 1 FOOT

SEE APPROVED PLAN OF PANTING ARRANGEMENT.

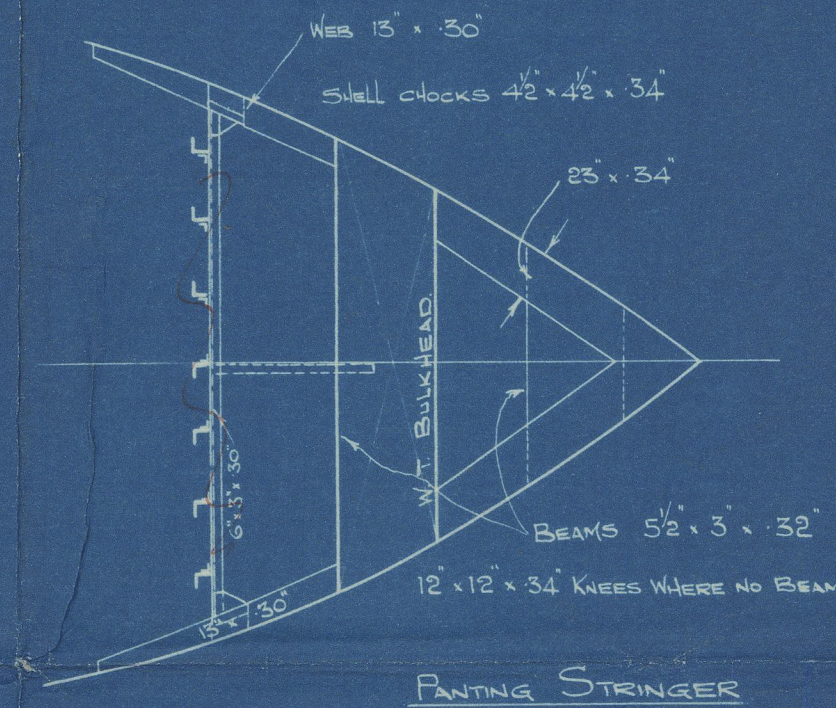

RAISED QUARTER DECK

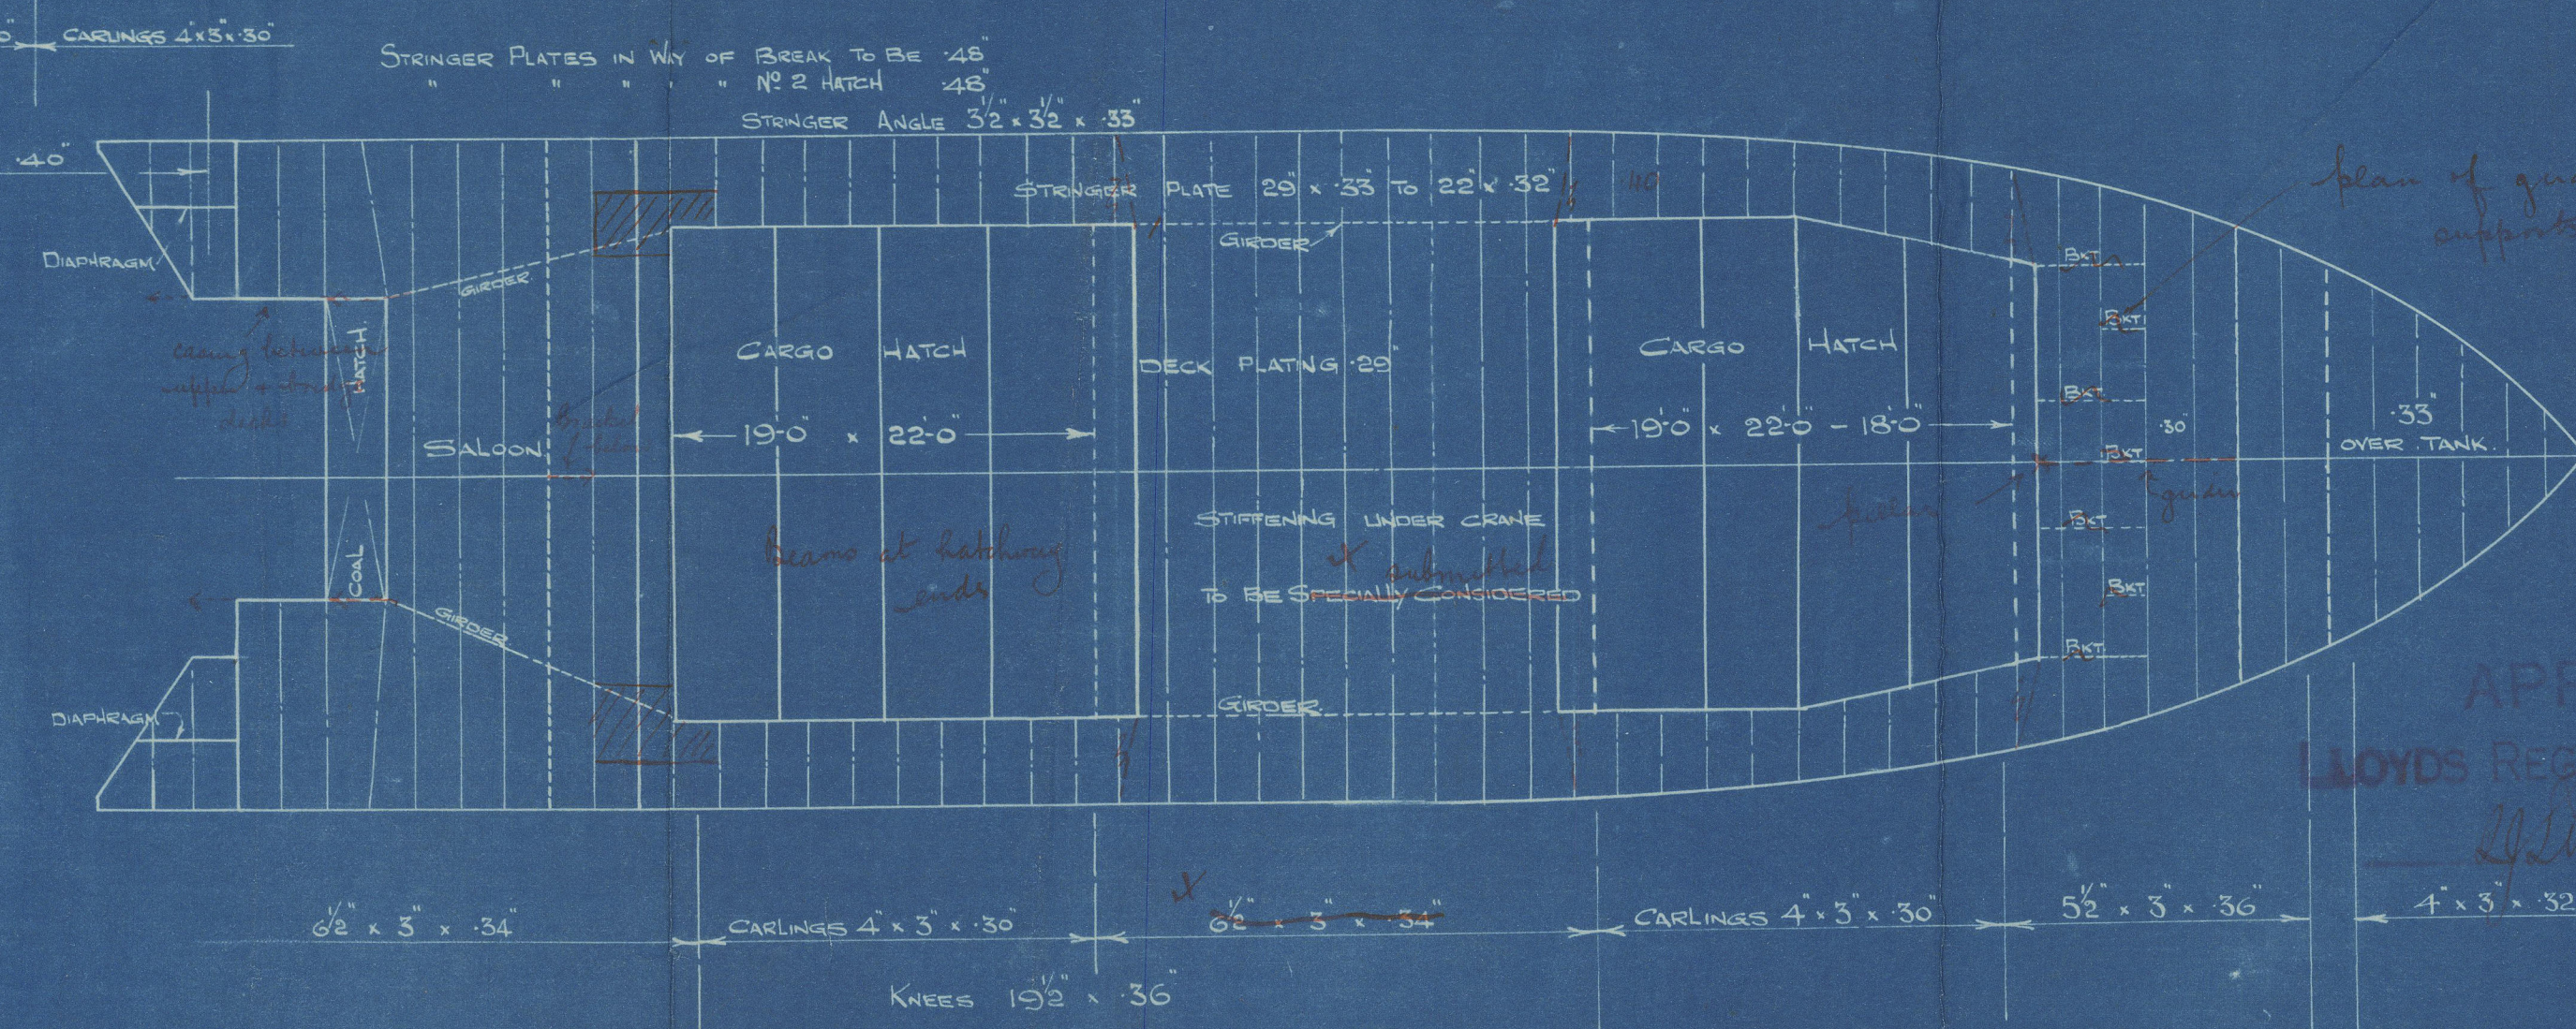

APPROVED LLOYD'S REGISTER OF SHIPPING

DATE 20.8.29

UPPER DECK



Lloyd's Register Foundation 1006-0022

W1006-0022

Thoms Henry Probb h d
N^o 154

PROFILE T DECK

S.S. "Bombo."

Lth. Rjet. 17th 161.

RETAIN



© 2021

Lloyd's Register
Foundation