


29 JUL 1946

Nº1354.  
FRAMING PROFILE.



SCALE  $\frac{1}{8}" = 1 \text{ FOOT.}$

DIMENSIONS 540'-0" x 73'-0" x 45'-0" MLD. TO SHELTER DK.

ALL SECTIONS NEW BRITISH STANDARD.

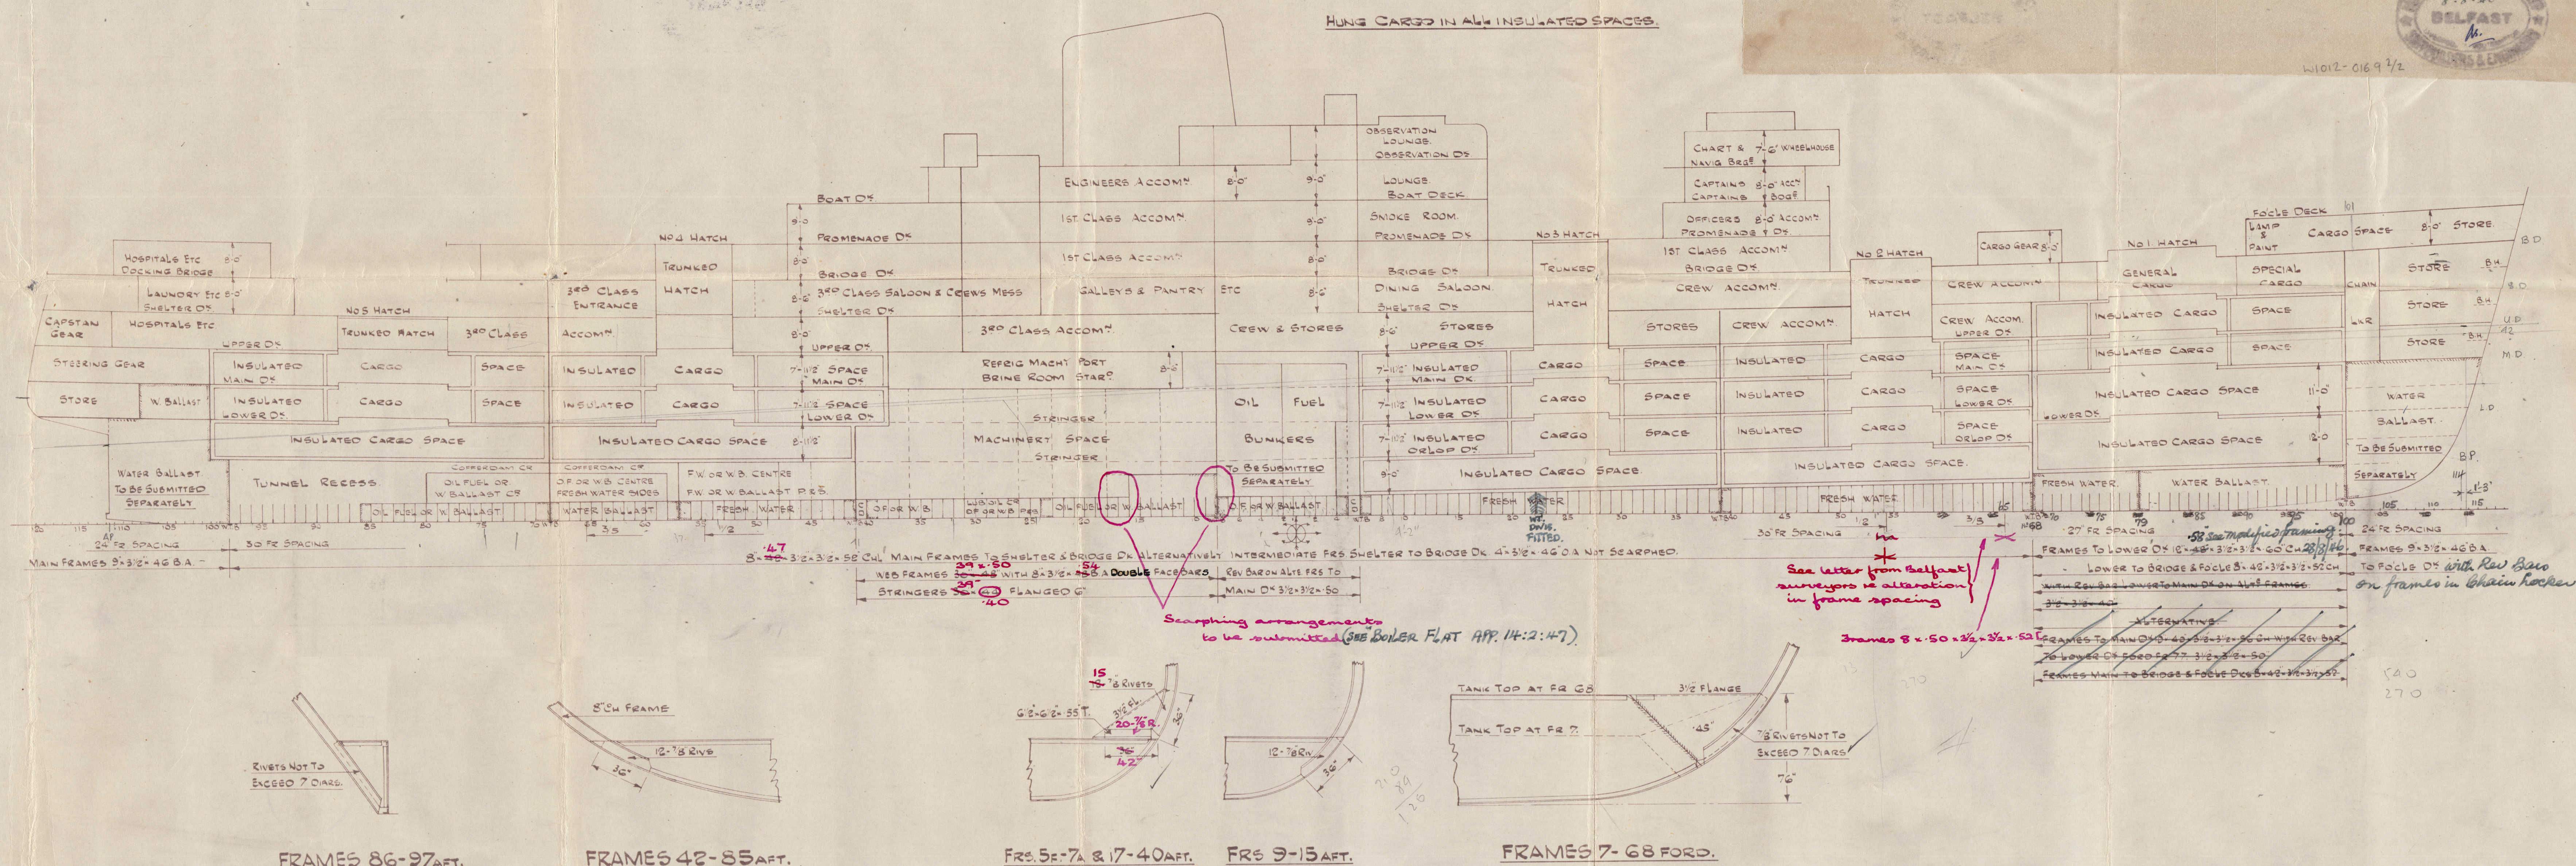


Nº 1354  
FRAME SPACING  
FORE END  
SCALE 1/16" = 1 FOOT

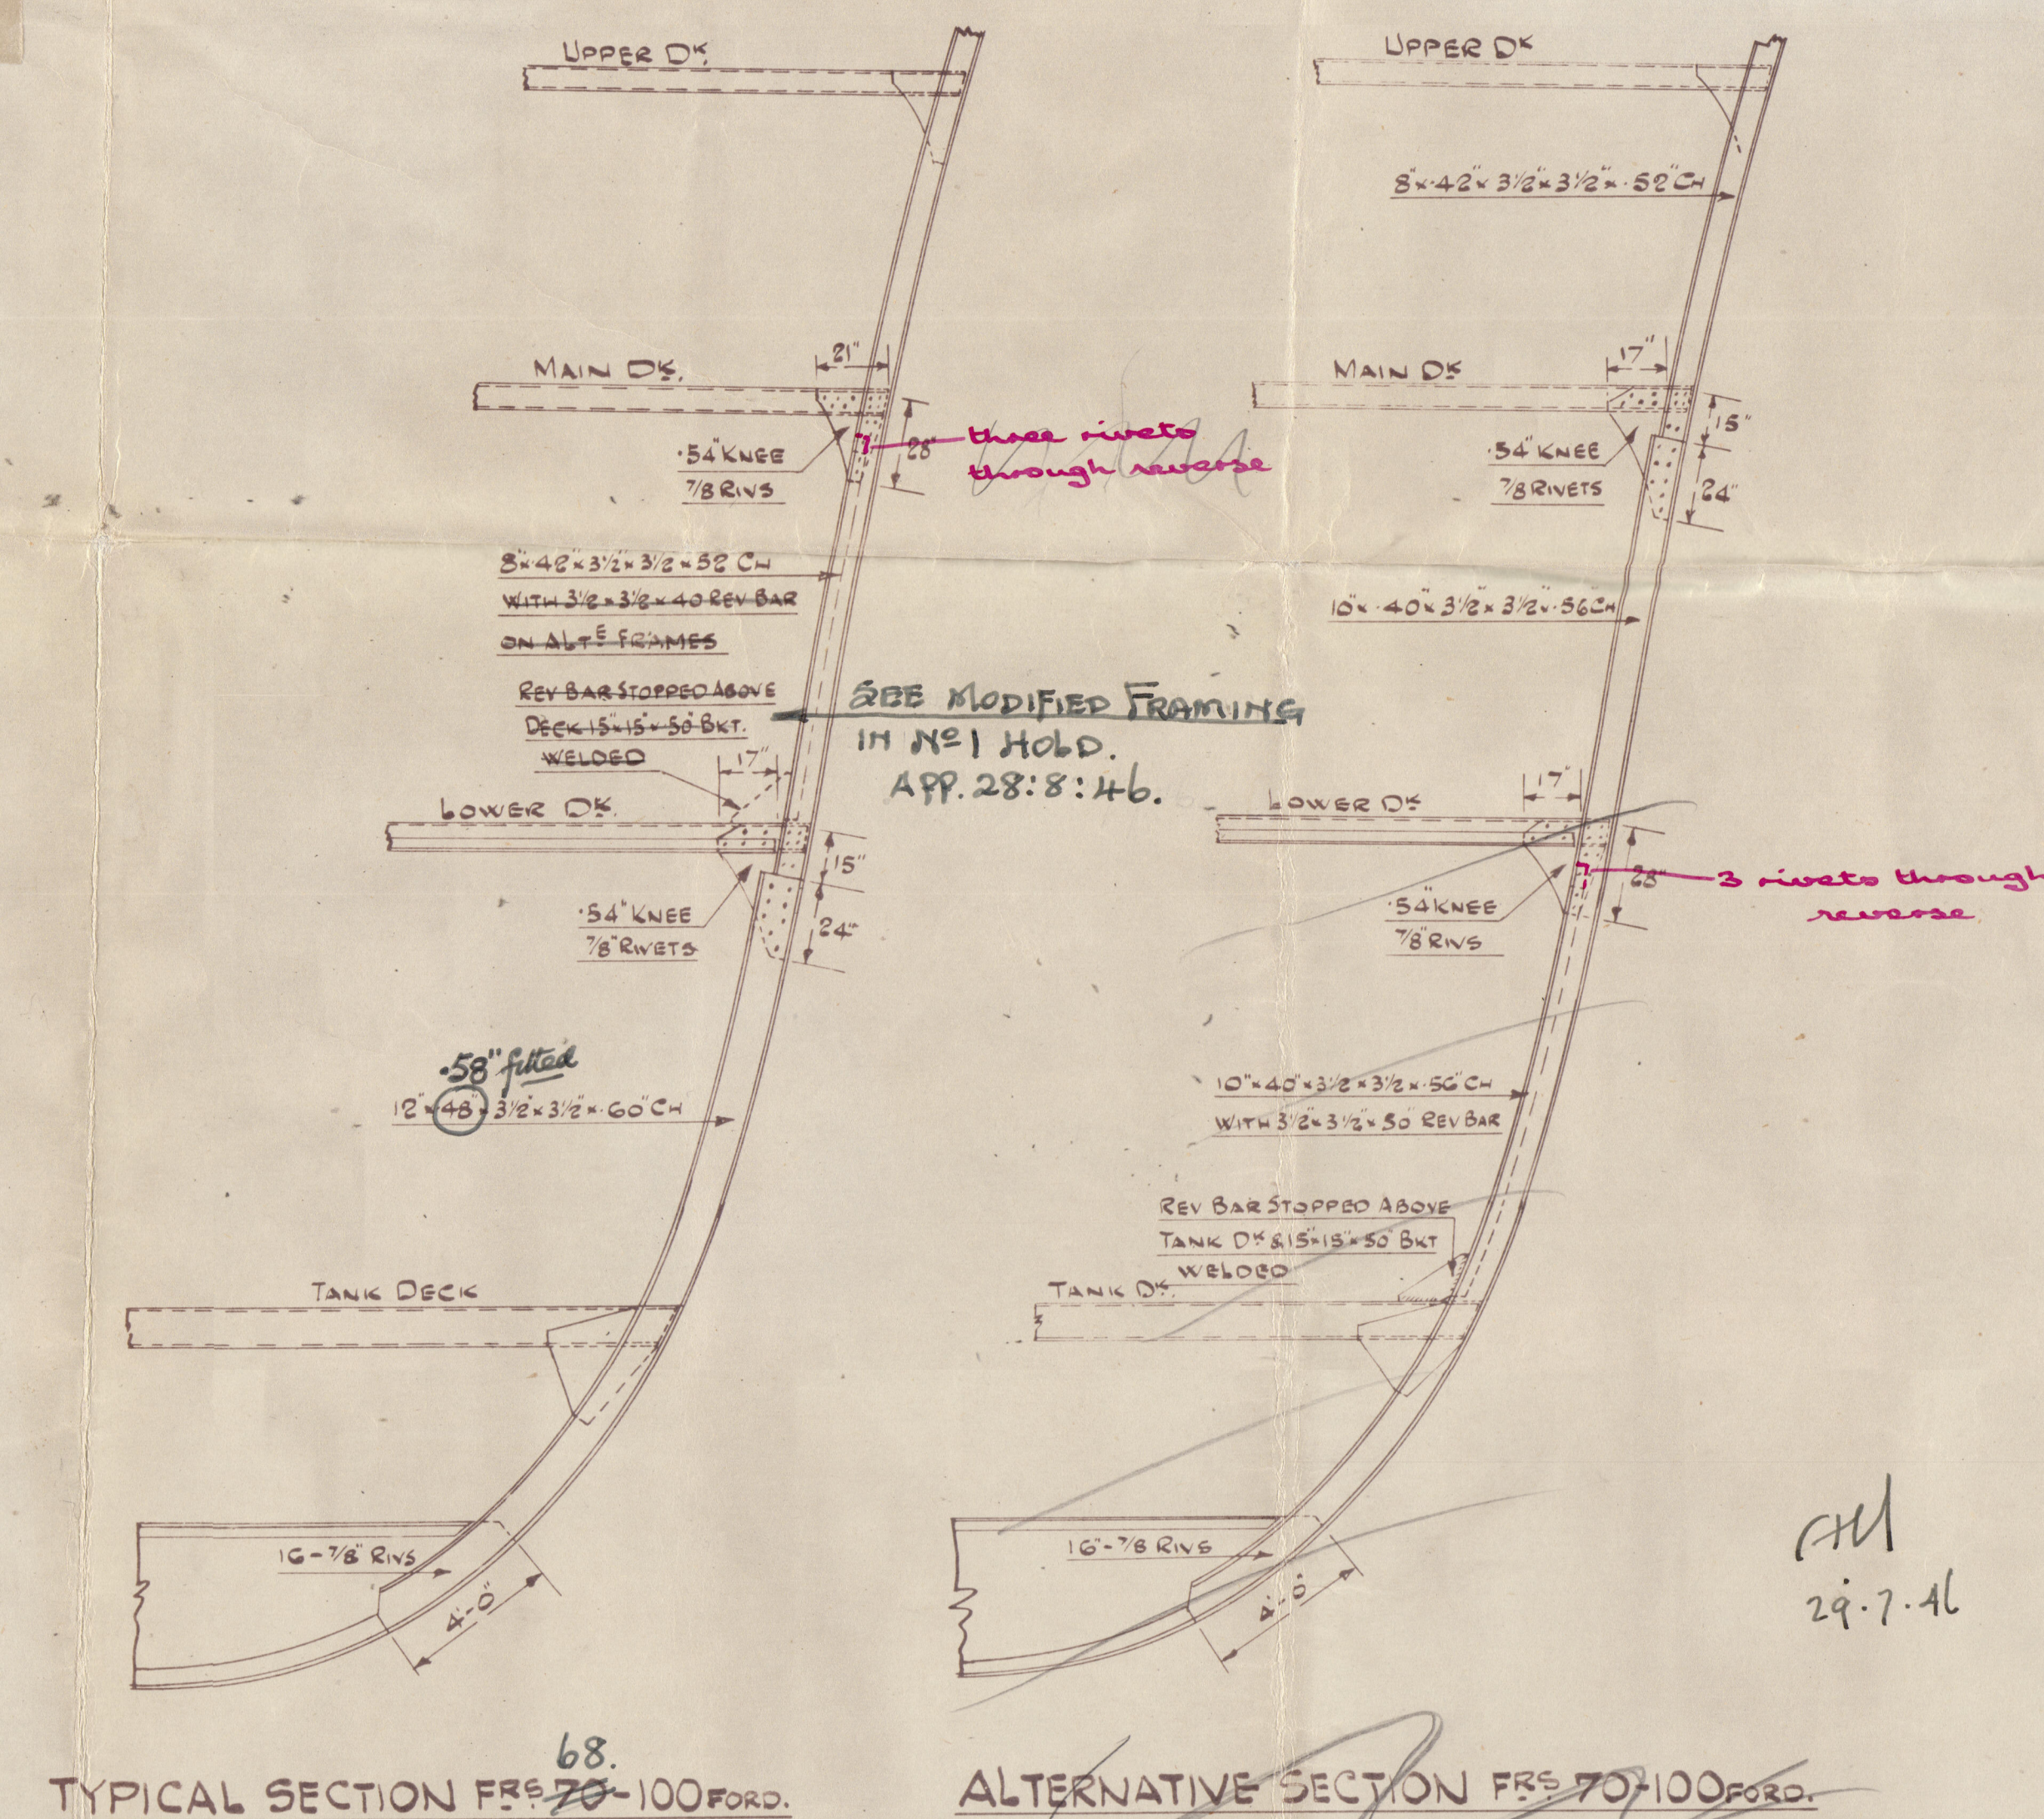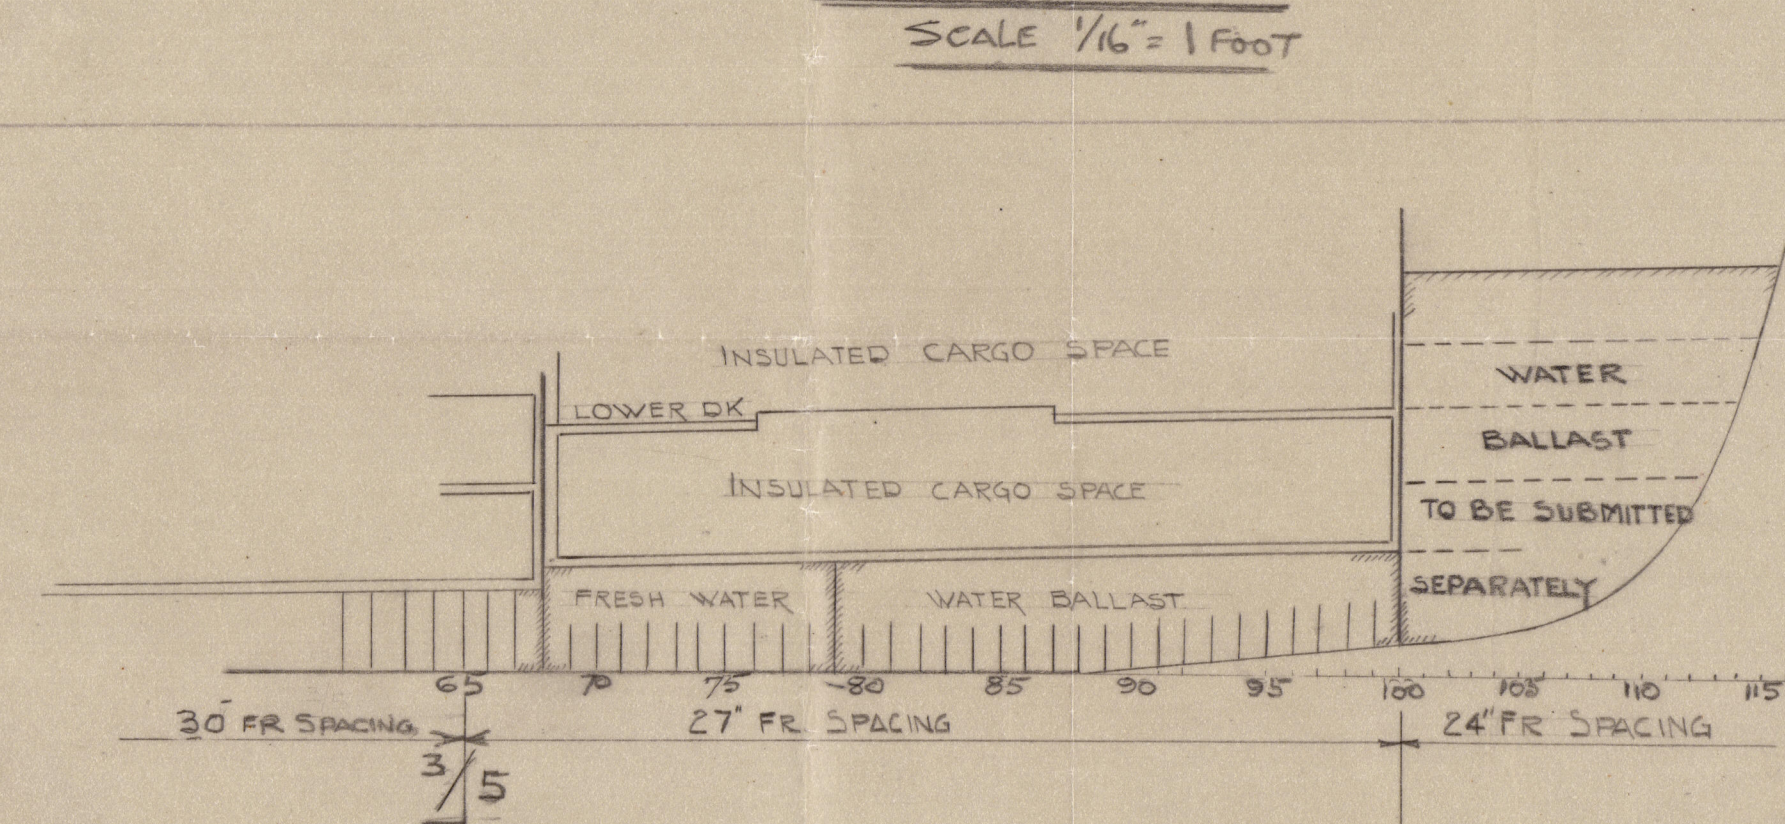

CH  
29.7.41

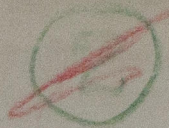


  
HARLAND & WOLFF LTD.  
BELFAST

No. 1354

TITLE Framing Profile

DATE APPROVED 29/7/46

Bel. apt. No. 14714 - Magdalena 

RECORDS DEPT.  
LONDON

(2)

RETAIN



© 2020

Lloyd's Register  
Foundation

W1012-0169/2