


LONDON COPY

LONDON COPY

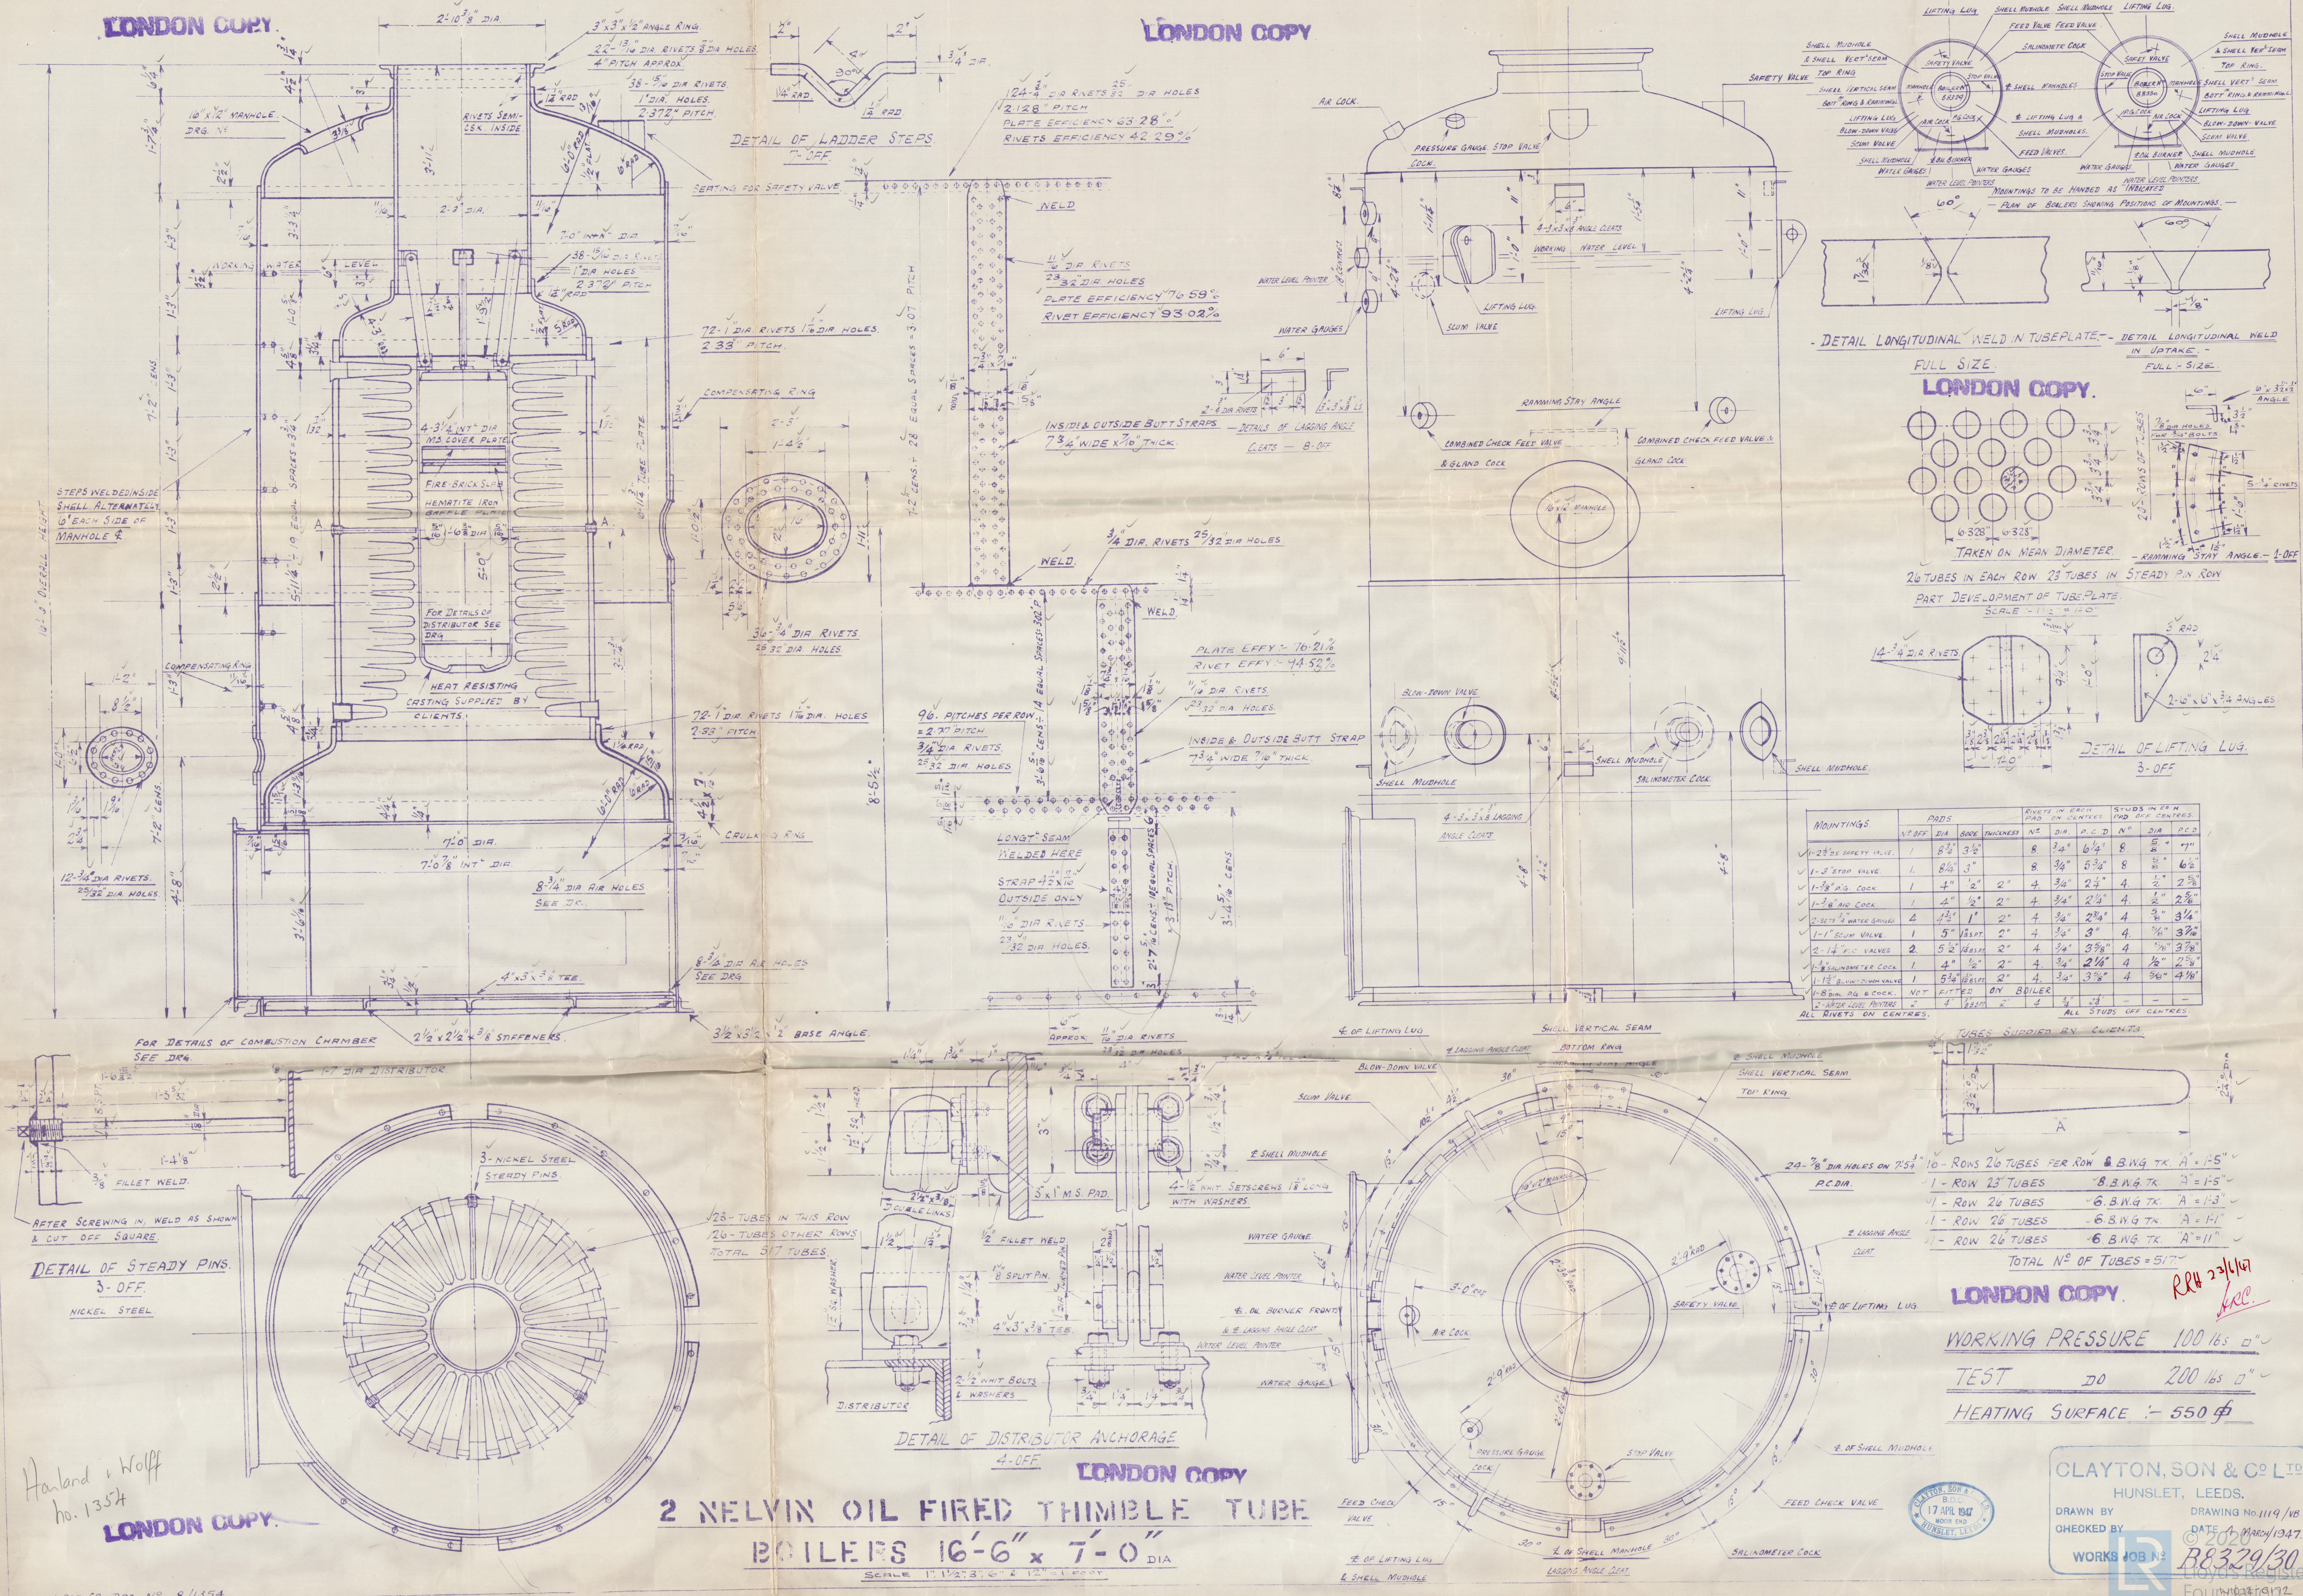

Harland & Wolff
no. 1354
LONDON COPY.

2 NELVIN OIL FIRED THIMBLE TUBE
BOILERS 16'-6" x 7'-0" DIA

LONDON COPY

WORKING PRESSURE 100 lbs \square''

TEST DO 200 lbs 0" ✓

HEATING SURFACE :- 550 ϕ

CLAYTON, SON & CO L^{TD}

HUNSLET, LEEDS.

DRAWN BY DRAWING No. 1119/VB.

CHECKED BY  DATE 4 MARCH/1947.

WORKS JOB № *B83.29/30*

Lloyd's Register

Foundation W101270172

"Magdalena" ★

"NELVIN" ~~Boiler~~ oil-fired boilers.

RECORDS DEPT..
LONDON

107

RETAIN

LONDON 10/12/72

W10 12-0172



© 2020

Lloyd's Register
Foundation