




29.7.14  
12.9.14

# PROFILE AND DECK PLANS.

Dimensions 335.0 x 48.0 x 24.10 moulded.

Scale 1/8 inch = 1 foot.

Note - Minimum scantlings required

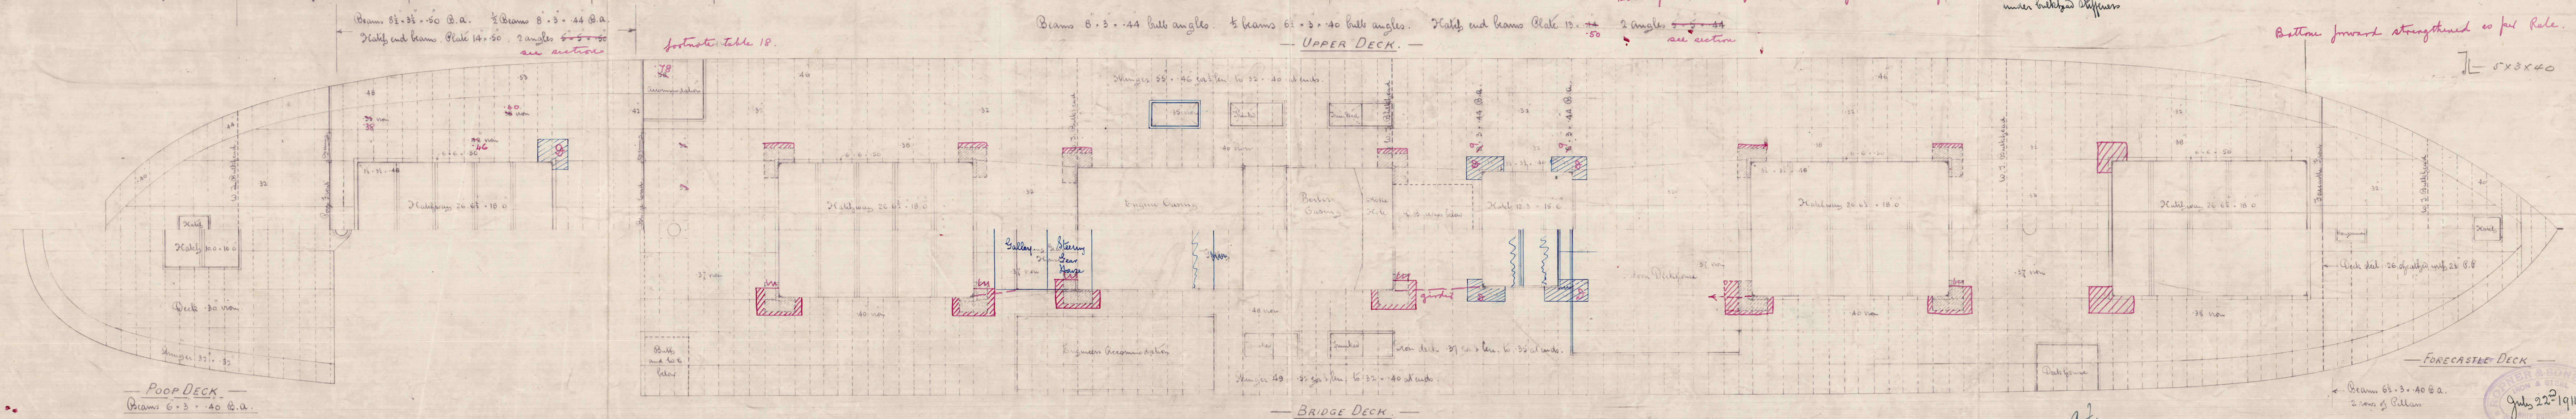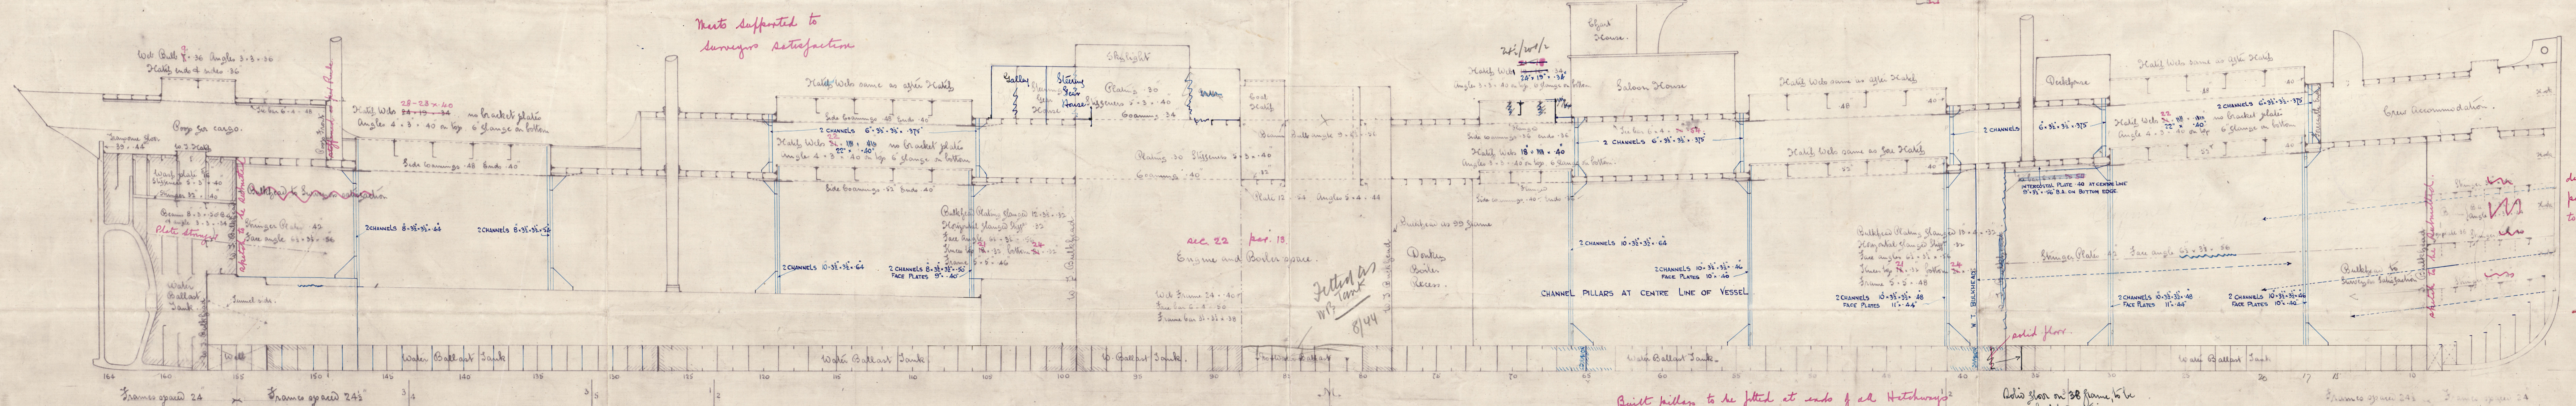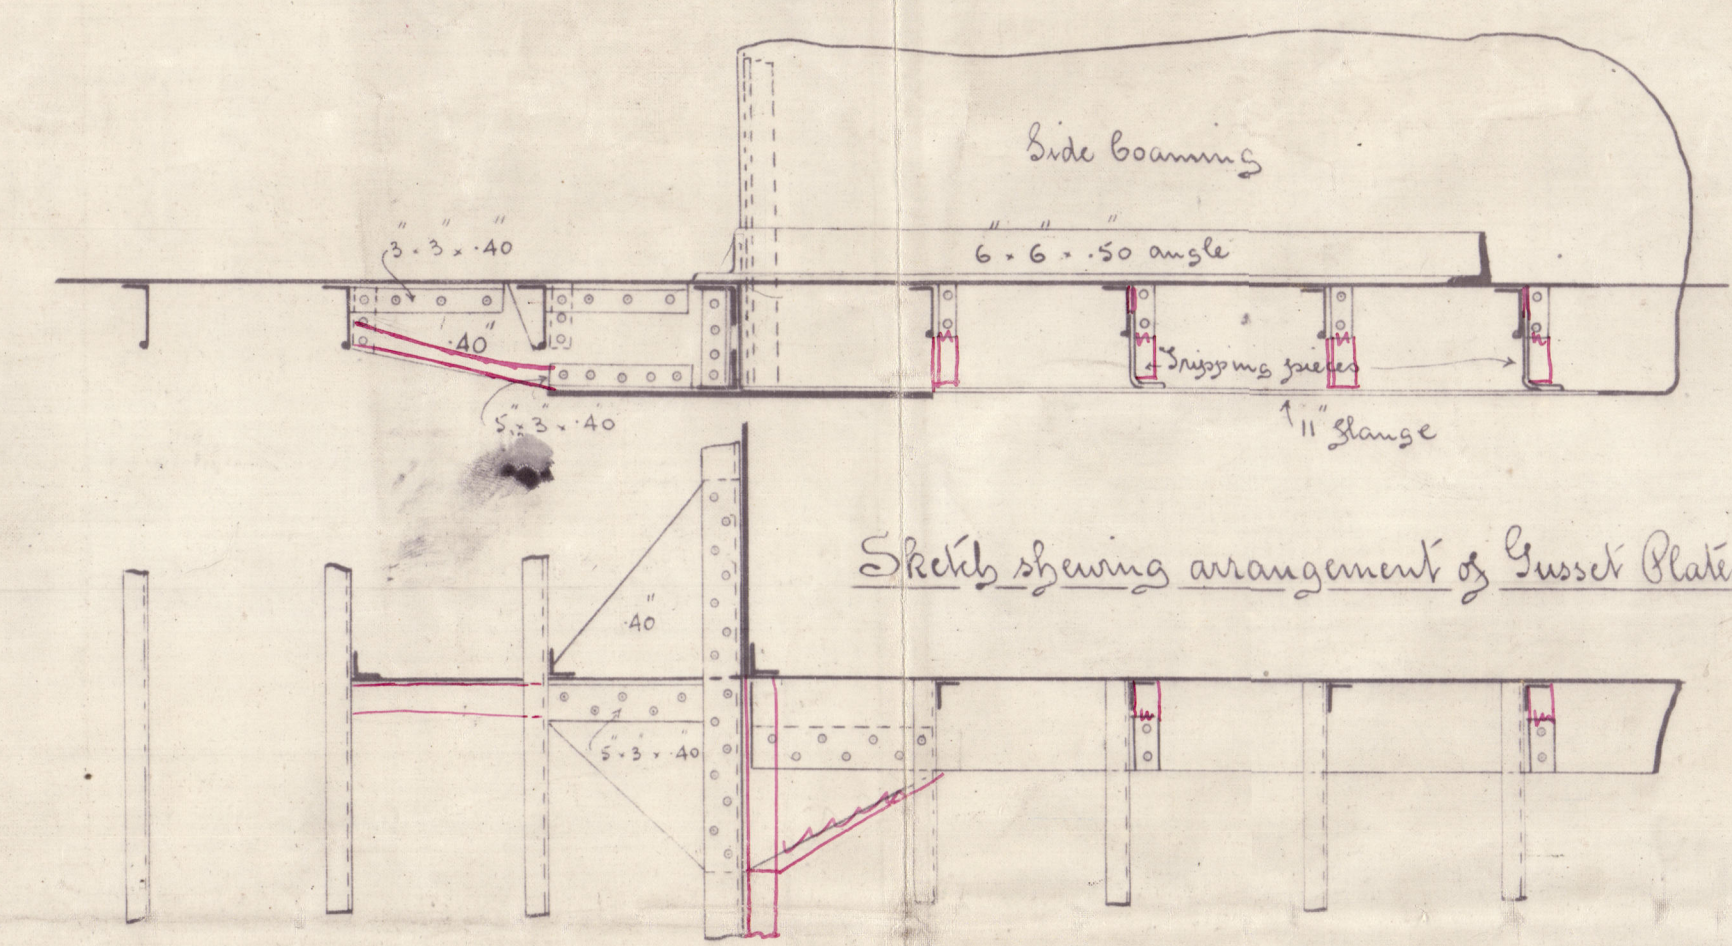

detail sketch of  
fastening arrangement  
to be submitted.

Bottom forward strengthened as per Rule.

Advis show on 38 frame to be  
under bulwark stiffeners

Build pillars to be fitted at ends of all Hatchways<sup>2</sup>

footnote table 18.

POOD DECK  
Beams 6.3 x .40 B.A.

Beams 8.3 x .44 bulb angles 1/2 beams 6.3 x .40 bulb angles. Plating and beams Plate 12.3 x 15.0 2 angles 5.3 x .44 see section

Beams 6.3 x .40 B.A.  
2 rows of Pillars





Miss's Paper House Ld


No 500.501

Profit & Loss Plan.


Paired



No 500 S/s Ellerswood.

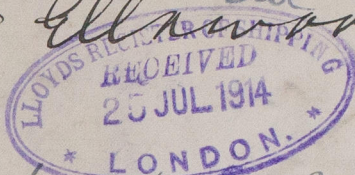

Mab report No. 8926.

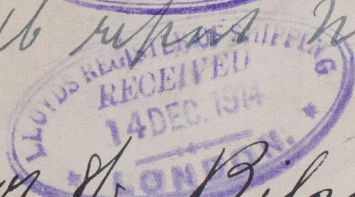

No 501. S/s. Bilewood



Mab report No. 8982.

RECEIVED



© 2020

Lloyd's Register  
Foundation

W1019-0192