



Lloyd's Register of Shipping,

12', Frederiksgade,

Copenhagen, K. 14th Sept. 21.

Communications to be addressed
THE SURVEYORS,
Lloyd's Register of Shipping,
Copenhagen, K.

Reference

The Secretary,

Lloyd's Register of Shipping,

London.

LLOYD'S REGISTER
LONDON.
REC'D SEP 19 1921
AN32

Dear Sir,

Cpn. Rpt. No. 6182. "THORSDAL".

In reply to your letter of the 9th instant we have to inform you that the upperdeck sheerstrake and strake below clear of bridge are as per sketch below.


And further that the depth moulded of the vessel is 21'-5½". The pumping arrangement is in accordance with the approved plan.

I am, Dear Sir,

Yours faithfully,

Jac. v. Rosen.

SURVEYOR TO LLOYD'S
REGISTER OF SHIPPING

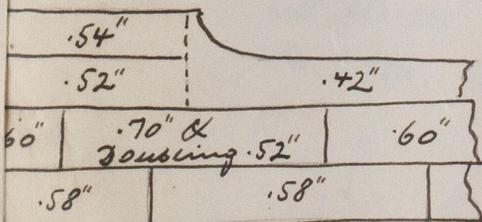

© 2020

Lloyd's Register
Foundation

W1098-0157

