


2/2/17

# MIDSHIPSECTION FOR CARGO STEAMSHIP'S BUILDING NO. 19 to 30.

Sections of equivalent strength to those indicated on the Plans may be approved.

SCALE: 1" = 1' 0".  
CLASS BRITISH LLOYD 100A.1

Boat Deck

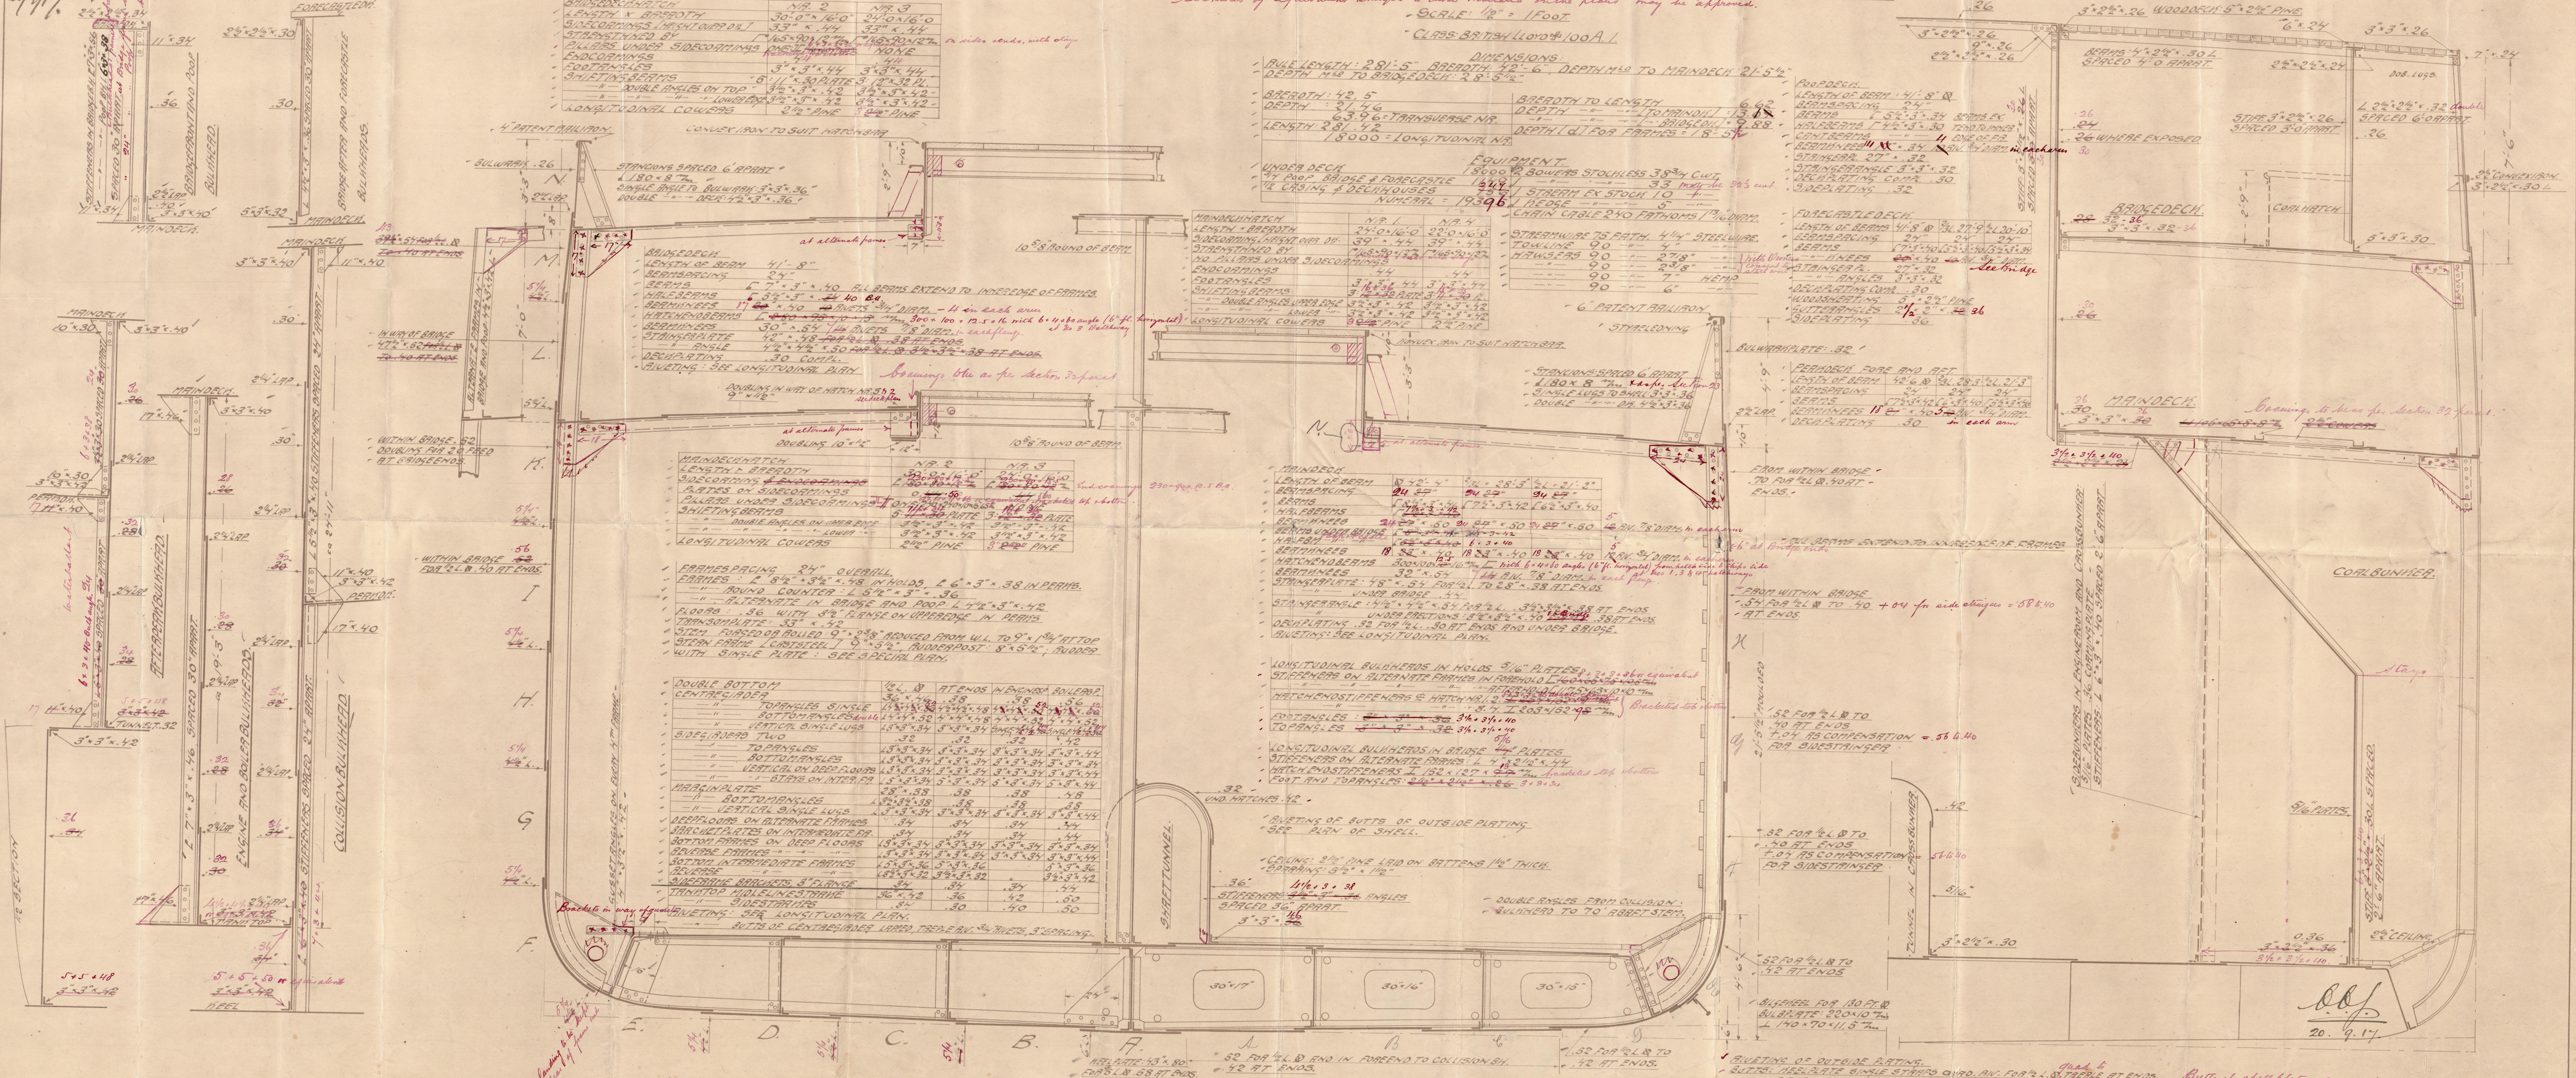

BRIDGE DECK HATCH	NR. 2	NR. 3
LENGTH x BREADTH	30'-0" x 16'-0"	24'-0" x 16'-0"
STRENGTHENING	33" x 14"	33" x 14"
STRENGTHENED BY	165 x 90 x 1/2"	165 x 90 x 1/2"
PILLARS UNDER SIDECORINGS	NONE	NONE
ENDCORINGS	3" x 3" x 1/4"	3" x 3" x 1/4"
FOOTING BEAMS	3" x 3" x 1/4"	3" x 3" x 1/4"
SHIFTER BEAMS	3" x 3" x 1/4"	3" x 3" x 1/4"
DOUBLE ANGLES ON TOP	3" x 3" x 1/4"	3" x 3" x 1/4"
DOUBLE ANGLES ON BOTTOM	3" x 3" x 1/4"	3" x 3" x 1/4"
LONGITUDINAL COWERS	2 1/2" PINE	2 1/2" PINE

DIMENSIONS	
RULE LENGTH: 281'-5"	BREADTH: 42'-6"
18000 - LONGITUDINAL NR.	

EQUIPMENT	
18000 BOWERS STOCKLESS 38 3/4 CWT.	
STEAM EX STOCK 10	
CHAIN CABLE 240 FATHOMS 1 1/2 IN.	

MAIN DECK HATCH	
NR. 1	NR. 2


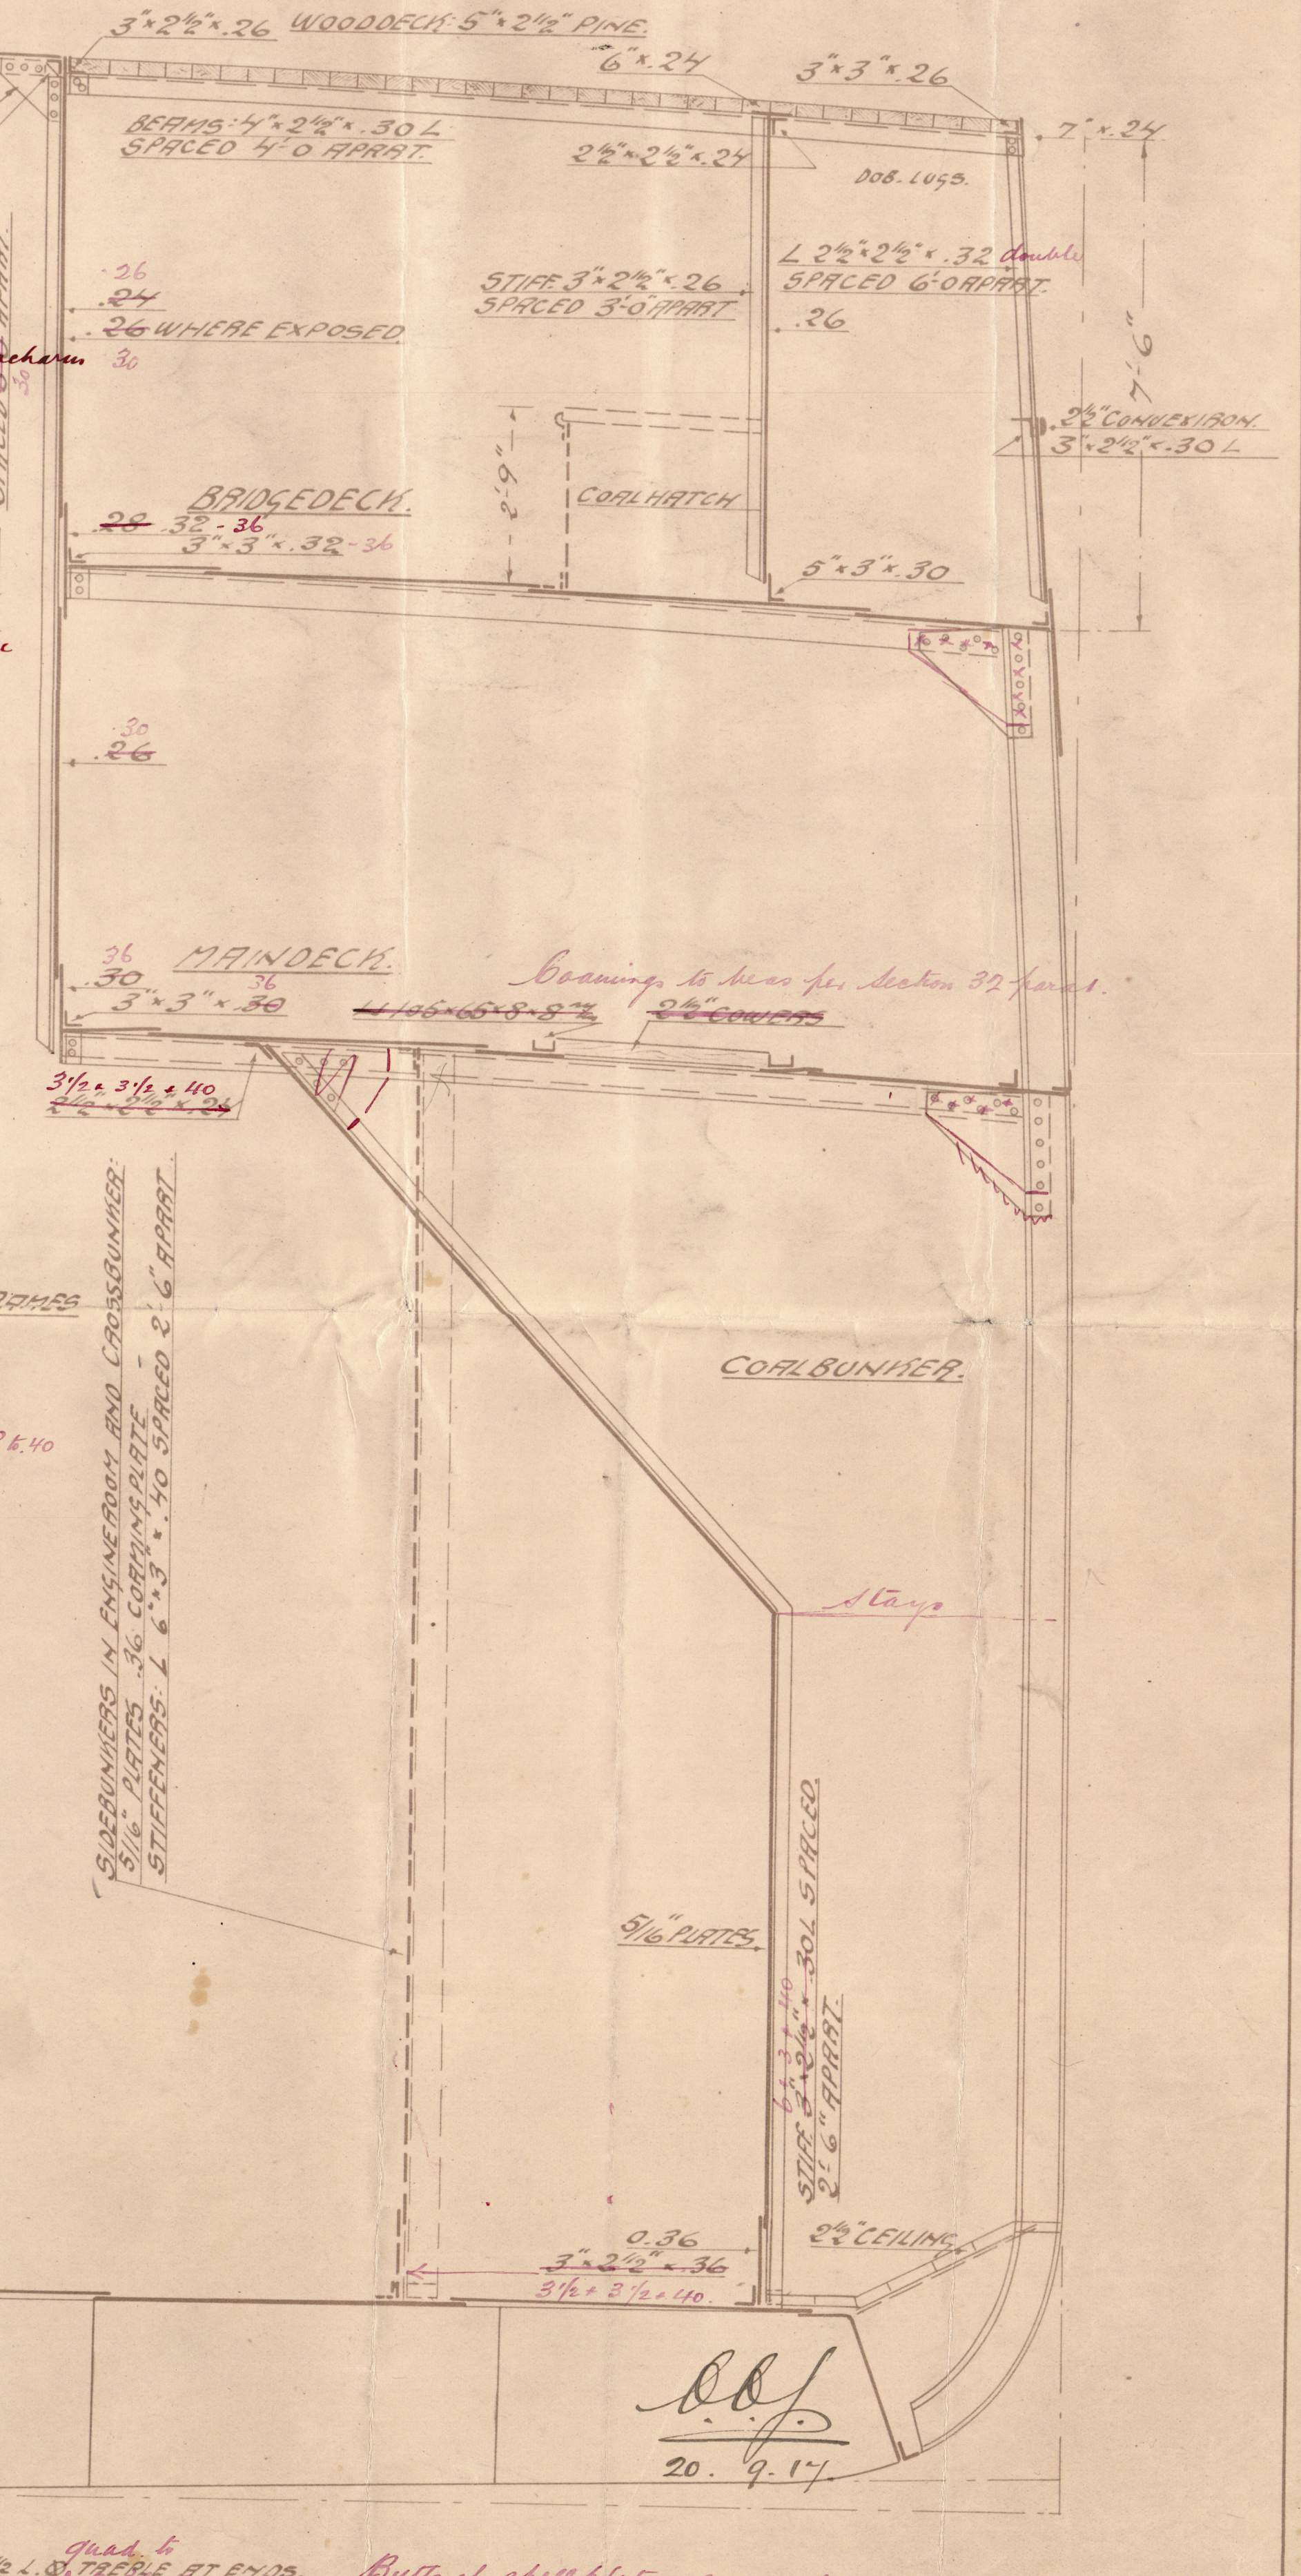



P. Th. Stühr's  
Maskin- og Skibsbyggeri  
Aalborg.  
S.S. YARD N<sup>o</sup> 19 to 30.

Midship Section.

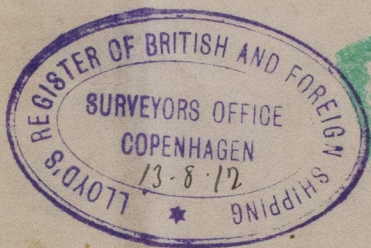

MON. - 3 SEP. 1917

G. J. Thorsdal "2095 Tons,  
1236  
of Kristiania.



© 2020

Lloyd's Register  
Foundation

W1098-0166