

Framespacing = 24"


PILOT DECK

S/S Nos 19 to 30

LONGITUDINAL AND DECK PLANS

LENGTH OUTSIDE STEM AND STERNPOST	281'-5"
BREADTH MOULDED	42'-6"
DEPTH MOULDED TO MAINDECK	21'-5½"
————— TO BRIDGEDECK	28'-5½"

SCALE:  $\frac{1}{8}'' = 1 \text{ FOOT}$ .

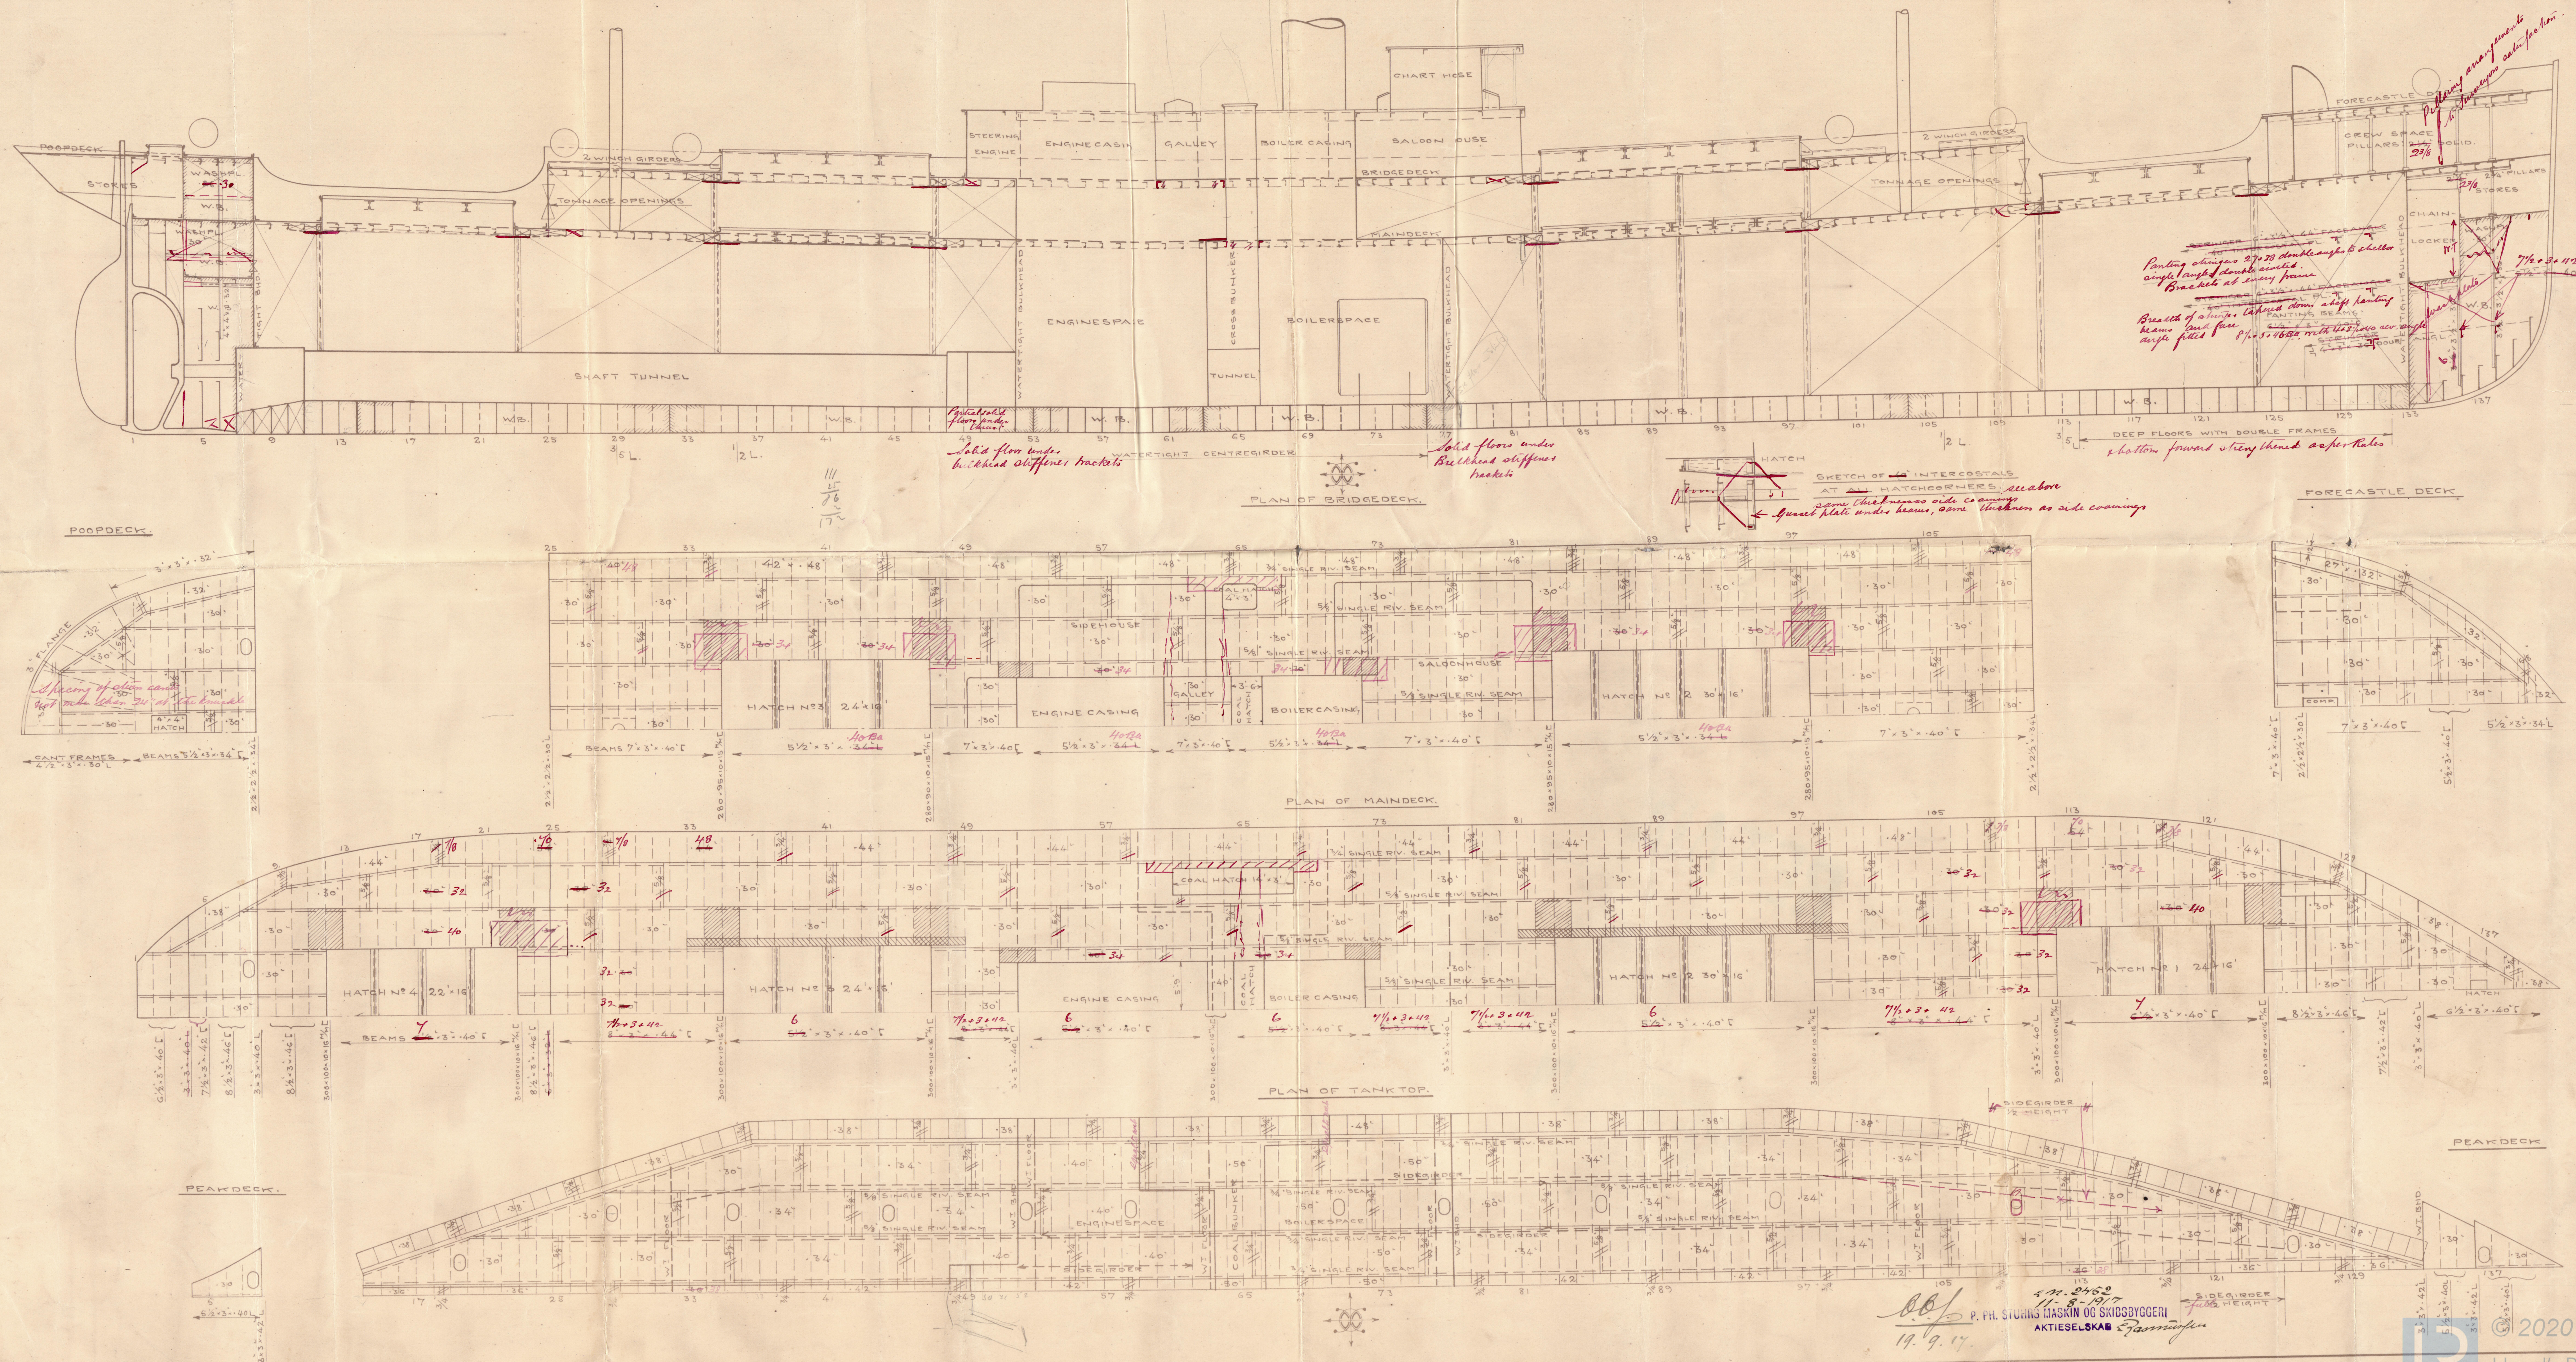

105  
1175  
11-8-1917  
P. PH. STURHS MASKIN OG SKIDSBYGGERI  
AKTIESELSKAB  
19.9.17  
Easmünde



P. M. Stuhls  
Markir - og Skitsbyggeri  
Aalborg.  
SS. YARD N<sup>o</sup> 19.10 30.  
Longitudinal Section.

RETAIN



SEP 1917

J. J. Thorsdøl  $\frac{2095}{1236}$  Tons,  
of Kristiania.

RETAIN



© 2020

Lloyd's Register  
Foundation

W1098-0162