


[illegible]







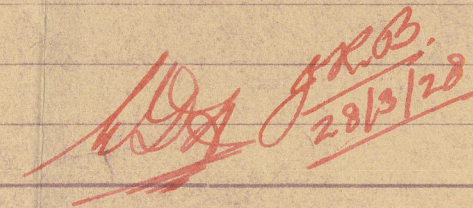Sämtliche Masse sind Fertigmasse.



				Werk Augsburg			
				<i>10.05.22</i> <i>22.03.22</i>			
Werk-Nr.	Kennwort	Typ	Aus- führung			Datum	N a m
<h1>Kurbelwelle, Bestellzeichnung.</h1>							
Maßstab: 1:5.		Gezeichnet für:		Hiezu Blatt:			
Entwurf	2 <sup>x</sup> . 1926			Werk Augsburg.		Typ: 330.6742. 330.67042.	
Gezeichnet		<i>priming</i>		Gruppe:			
Geprüft		Vervielfältigung dieser Zeichnung, unbefugte Verwertung, Mit- teilung an andere ist strafbar und macht Schadensersatzpflichtig. §§ 1, 11, 15, 36 des Urheberrechtsgesetzes vom 19. Juni 1907. § 10 des Gesetzes gegen den unlauteren Wettbewerb vom 1. Juni 1909. § 823 des Bürgerlichen Gesetzbuches.					
Gesehen		Abteilung und Zeichnungs-M. 					
Norm. Abt.		Augsburg, den 22. 1926					
Entstanden aus Nr.		Abgeworfen für Nr.					


Lloyd's Register  
Augsburg, den 2. 1. 1926  
W 1099 - 0114



Messrs. Yarrow & Co. Ltd. Glasgow, Yard No. 1559  
Crank Shaft of Main Diesel Engines for Electric Ship Propulsion.

Norman letter E 21/3/28. "M.O.P. S.B.A."

GEN. BOX NO ~~110~~

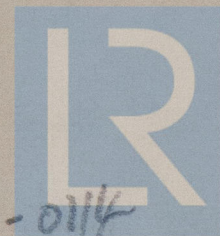

W1099-0114

© 2020

Lloyd's Register  
Foundation