

Engine Room ... }
 TONNAGE FOR FEES.. 1337.11

Proportions—Depth to Length—Upper Deck Beam at side to top of keel } 13.57
 R.Q.D. 11.7

Residence Ro

Hamburg Report Nr. 15831

6. For the information of Surveyors and the Committee only.
 Received at _____ Office _____ 19

Lloyd's Register of Shipping.

(Report on Vessel No. 457 Port Rotterdam)

No. 61 SHIP FORGINGS OR CASTINGS.

I have to report that the undermentioned ~~Iron or Steel Forgings or Castings~~, manufactured by Messrs Wilton's Eng. & Shipway Co of Rotterdam for the Vessel No. 457, being built by Friedr. Krupp Germania Werf of Kiel-Gaarden have been inspected by me as set forth below and found to be, so far as can be seen, sound and free from defects


Report on Forgings or Castings.

Lloyd's
 No. 61
 M.J. 11-6-23


Rotterdam 12th of June 1923
 H.P. Jonker

	STERN FRAME.	RUDDER FRAME.	STEM.
Material*	Siemens Martin Steel		
made	forged		
Dimensions	as per plan		
Process on Inspection	Forged & machined		
when Inspected	5-14-22-28-30/5 4-6-11/6-23		
CASTINGS.			
Tests on Standard Test Pieces.			
Tensile Test—	25½ tons		
Tons per square inch	39%		
Elongation per cent. ...	180° good.		
Bending Test—			
Angle before fracture			
Test—			
Height from ground ...			
Numbering Test—			
made according to Rules and found satisfactory ...			

SKETCHES OF FRAMES SHOWING POSITION AND DESCRIPTION OF WELDS OF FORGINGS.

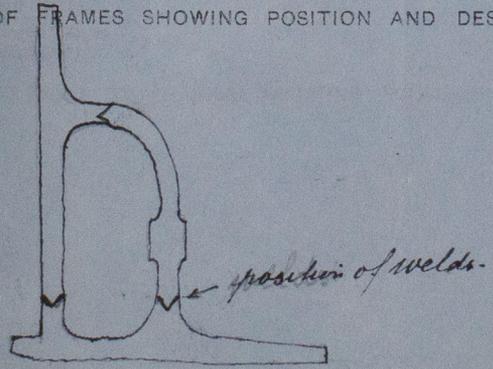

Fee (if any chargeable) £ : :
 To be paid at Rotterdam

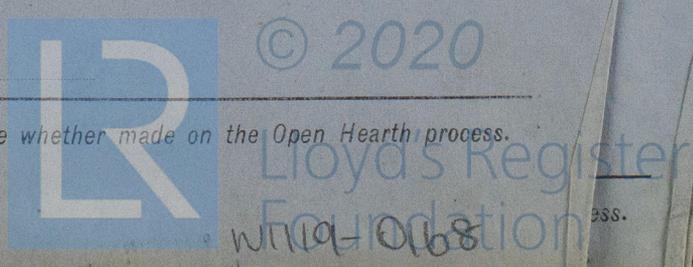

of Iron, state whether scrap or puddled Iron. If of Steel, state whether made on the Open Hearth process.