



15/2/27



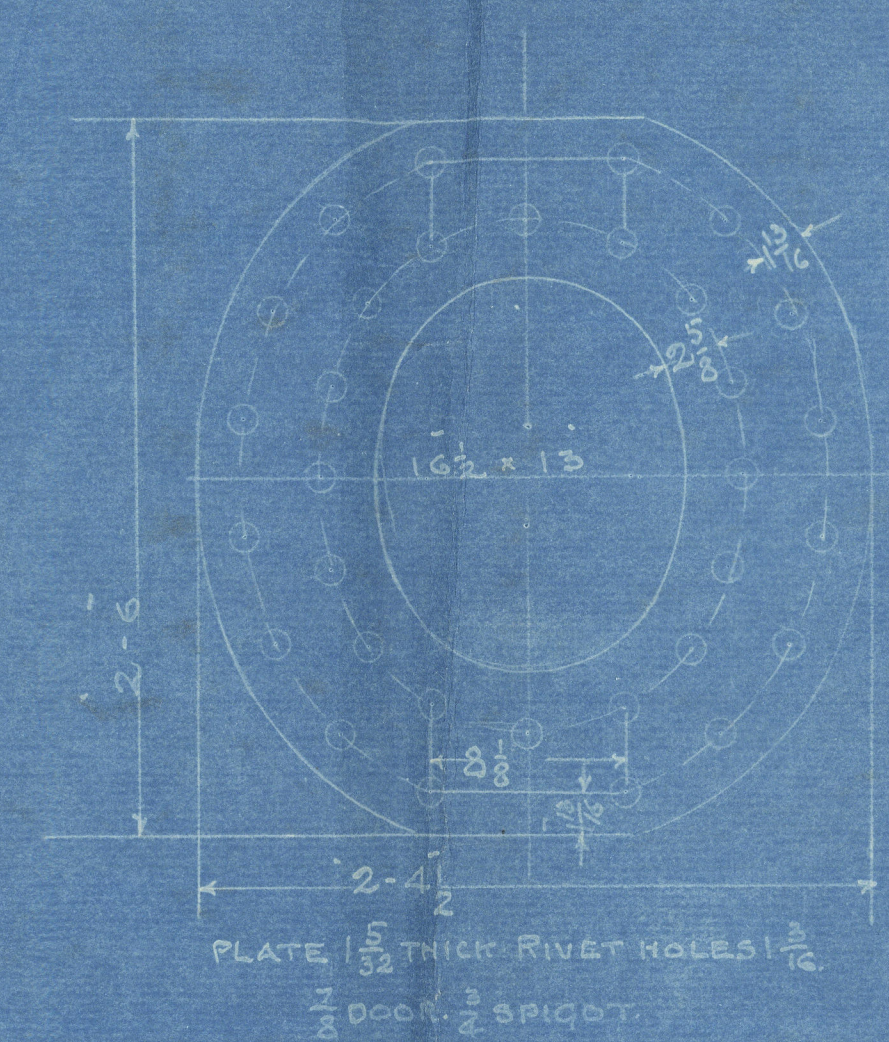


TO BE FITTED TO MESSRS PALMERS, S. D. CO. SS N° 974-5-6
TO PASS LLOYD'S SURVEY FOR 180 LBS PER SQ. IN. WORKING PRESSURE
NATURAL DRAUGHT OIL BURNING.

TENSILE OF SHELL PLATES & GIRDERS	28.0 TO 52.0 TON
FLANGE & FURNACES	26.0 - 30.0
MAIN STAY BARS	28.0 - 52.0
SCREW & RIVET BARS	26.0 - 30.0

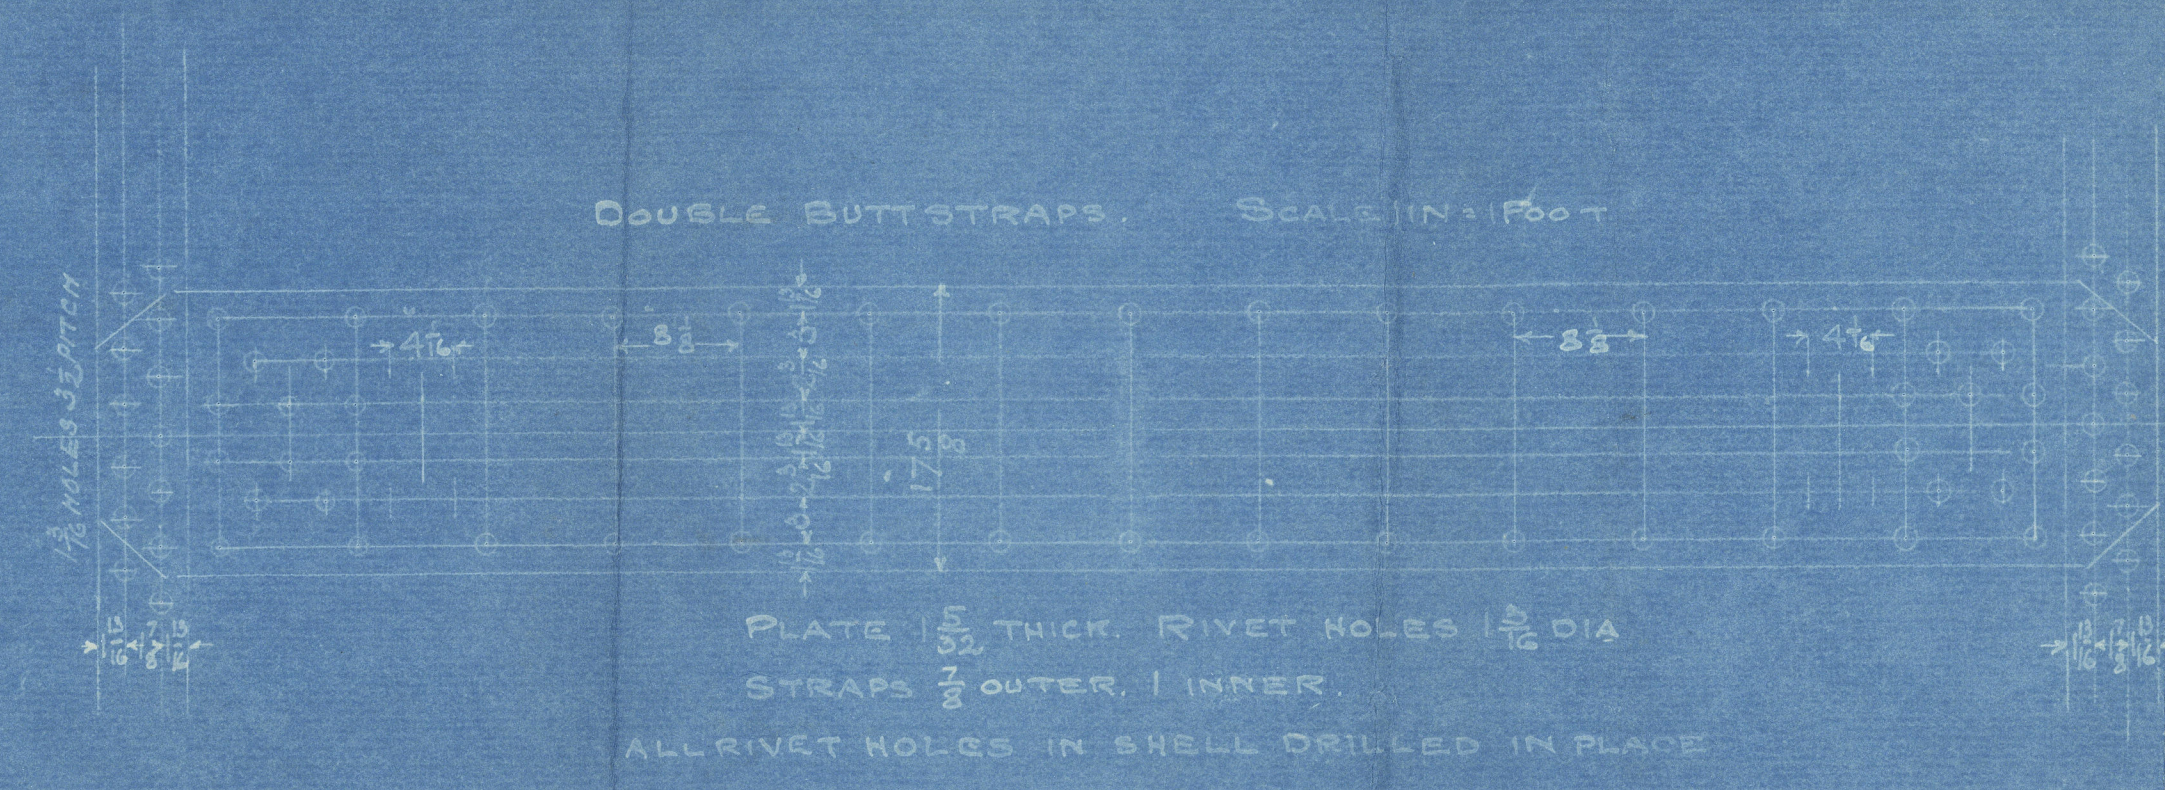

2. OFF
SCALE 1 IN. = 1 FOOT

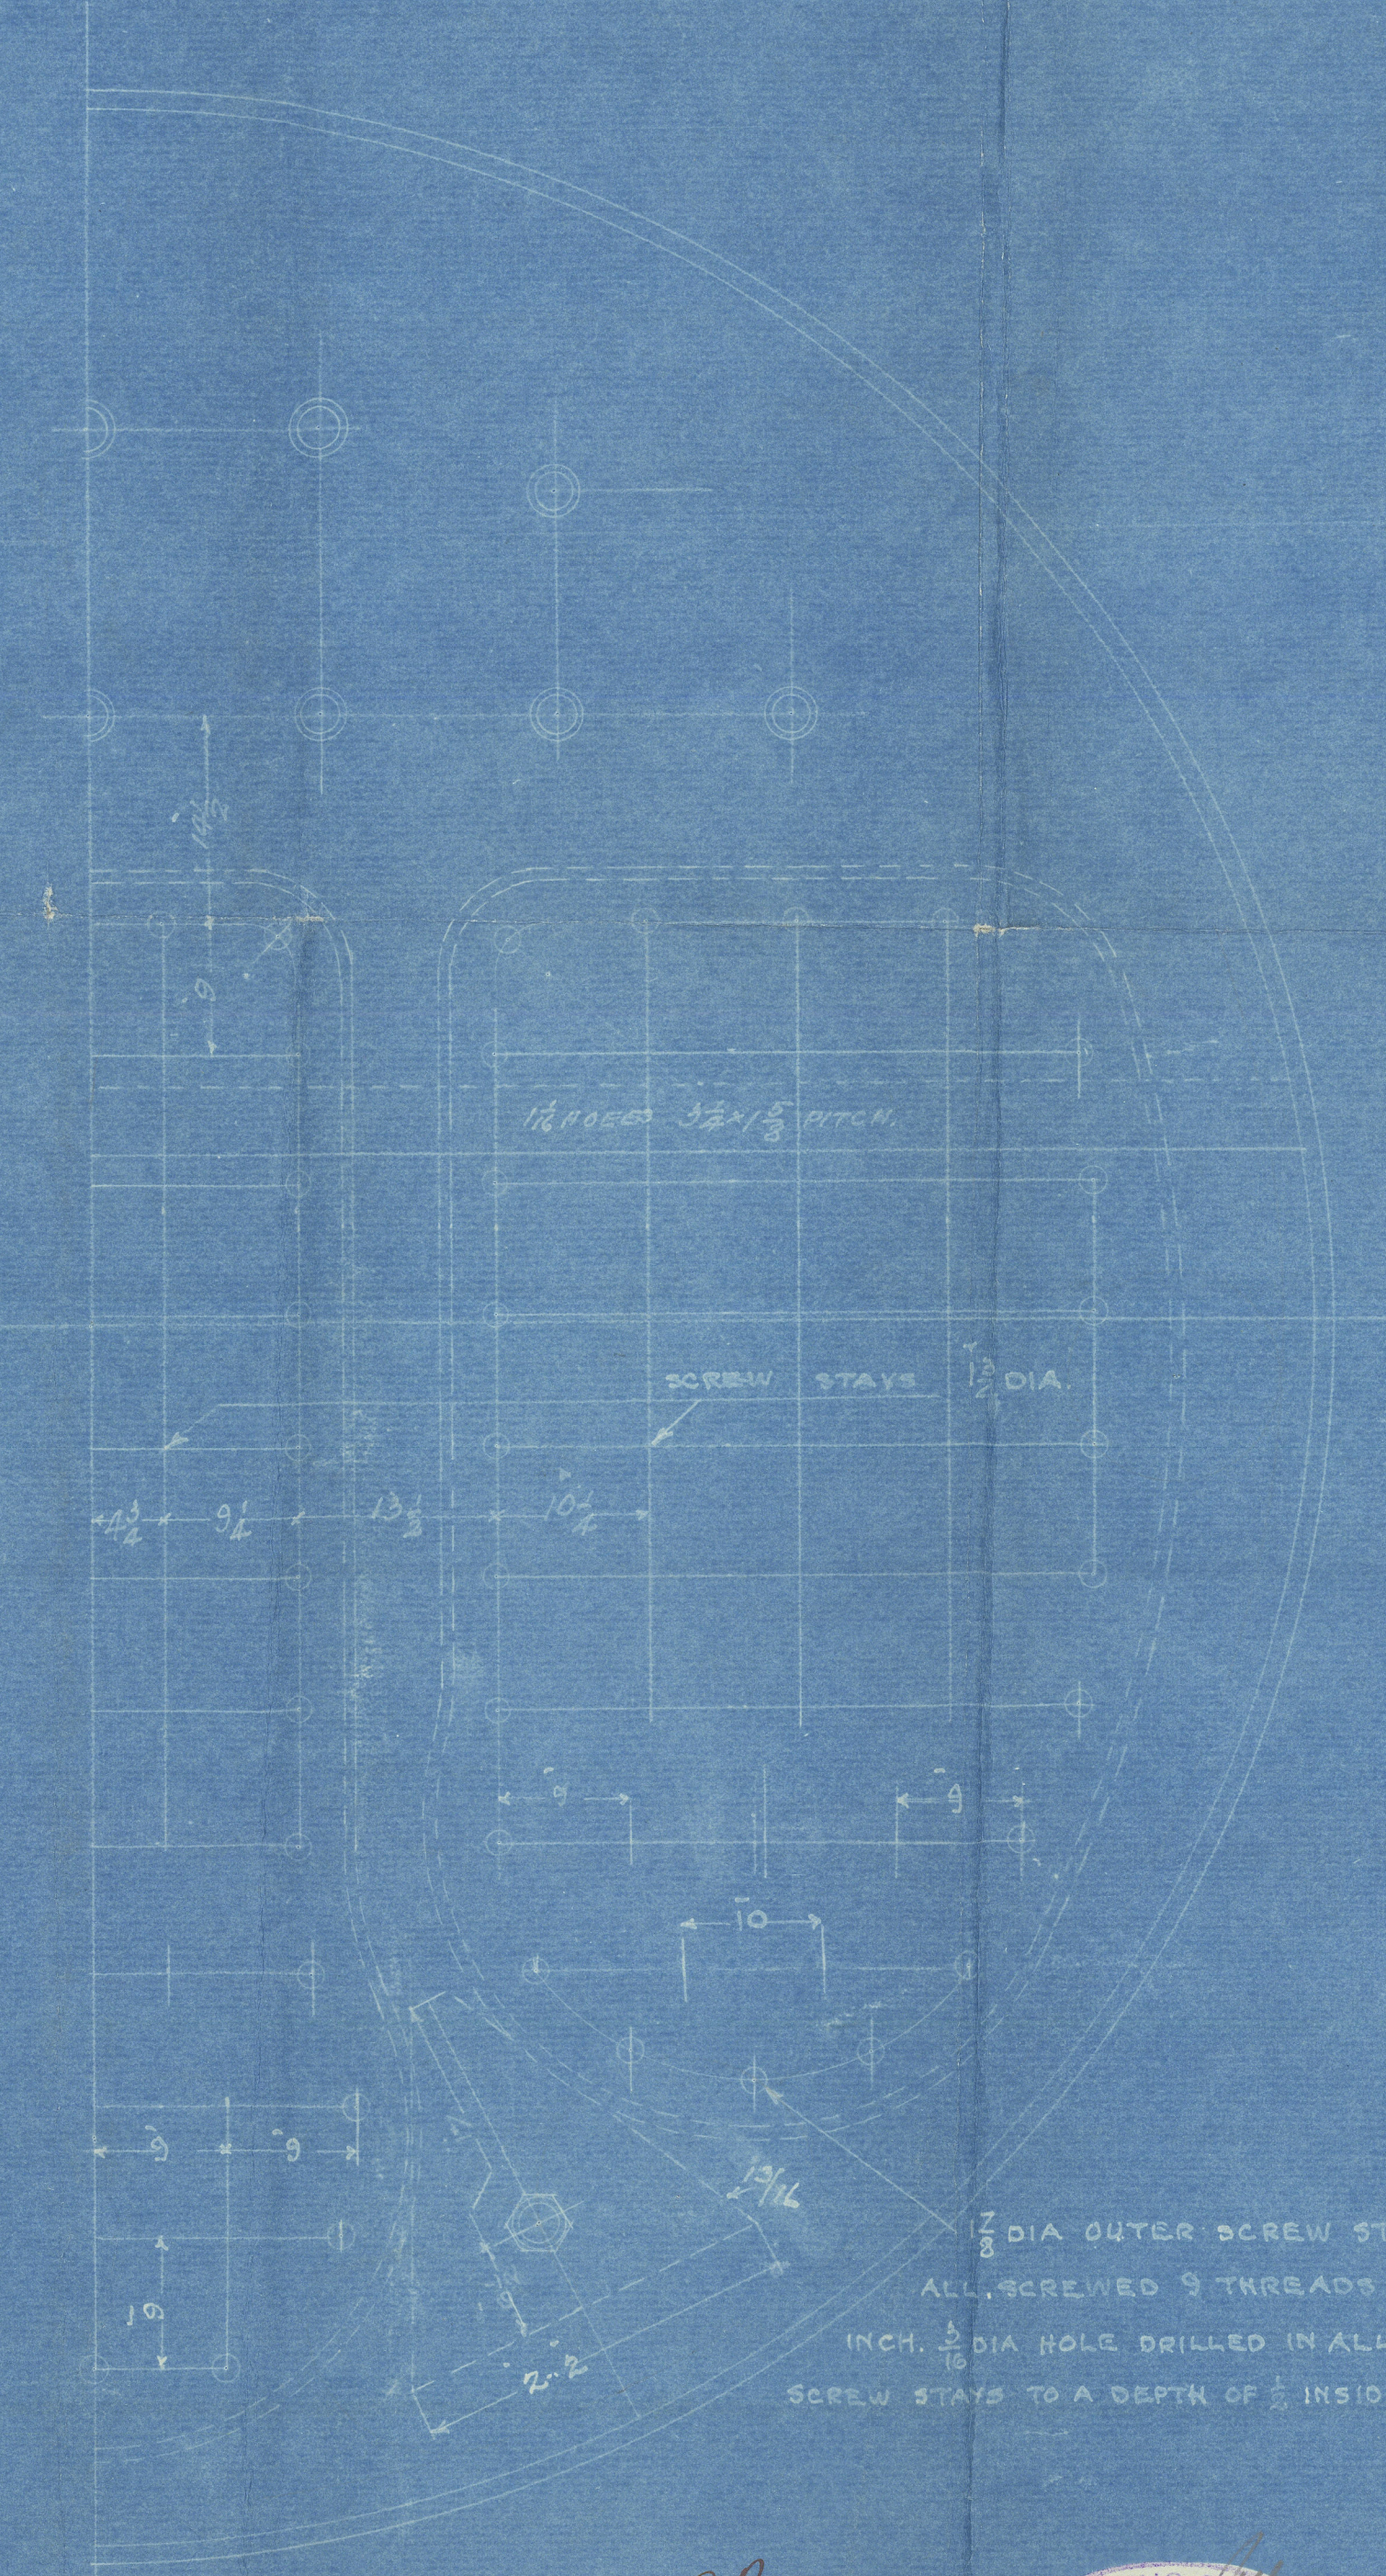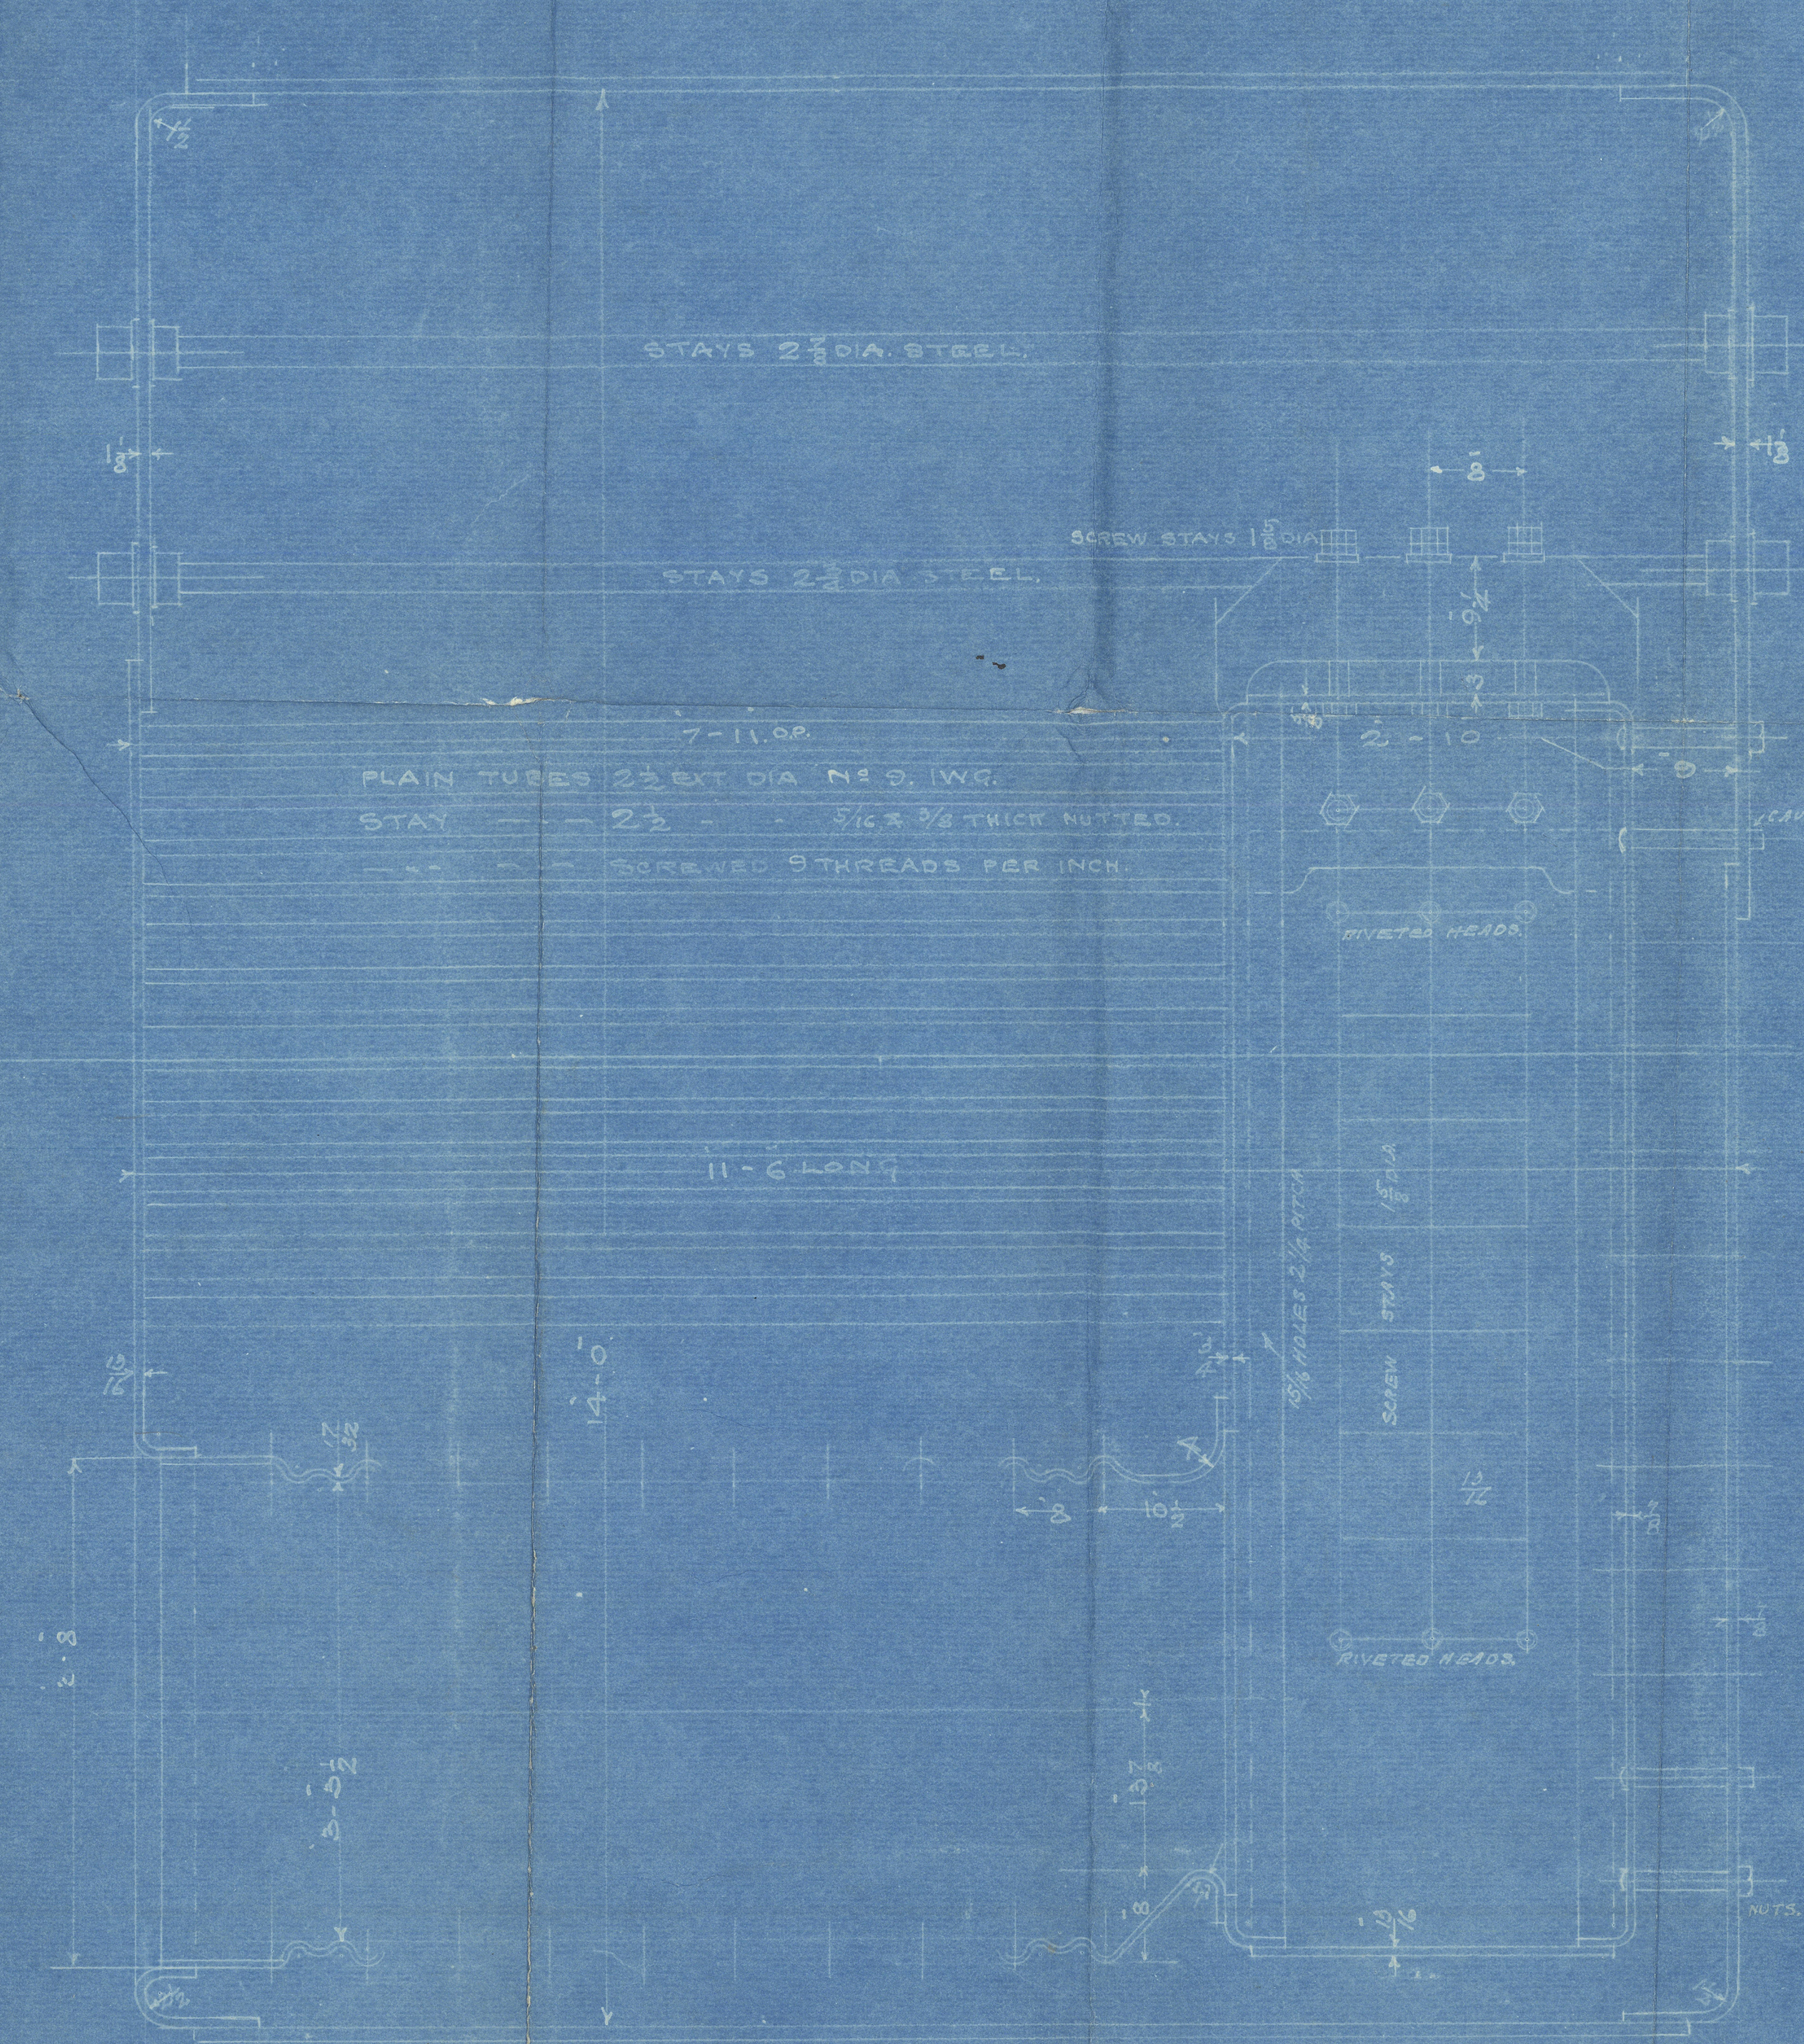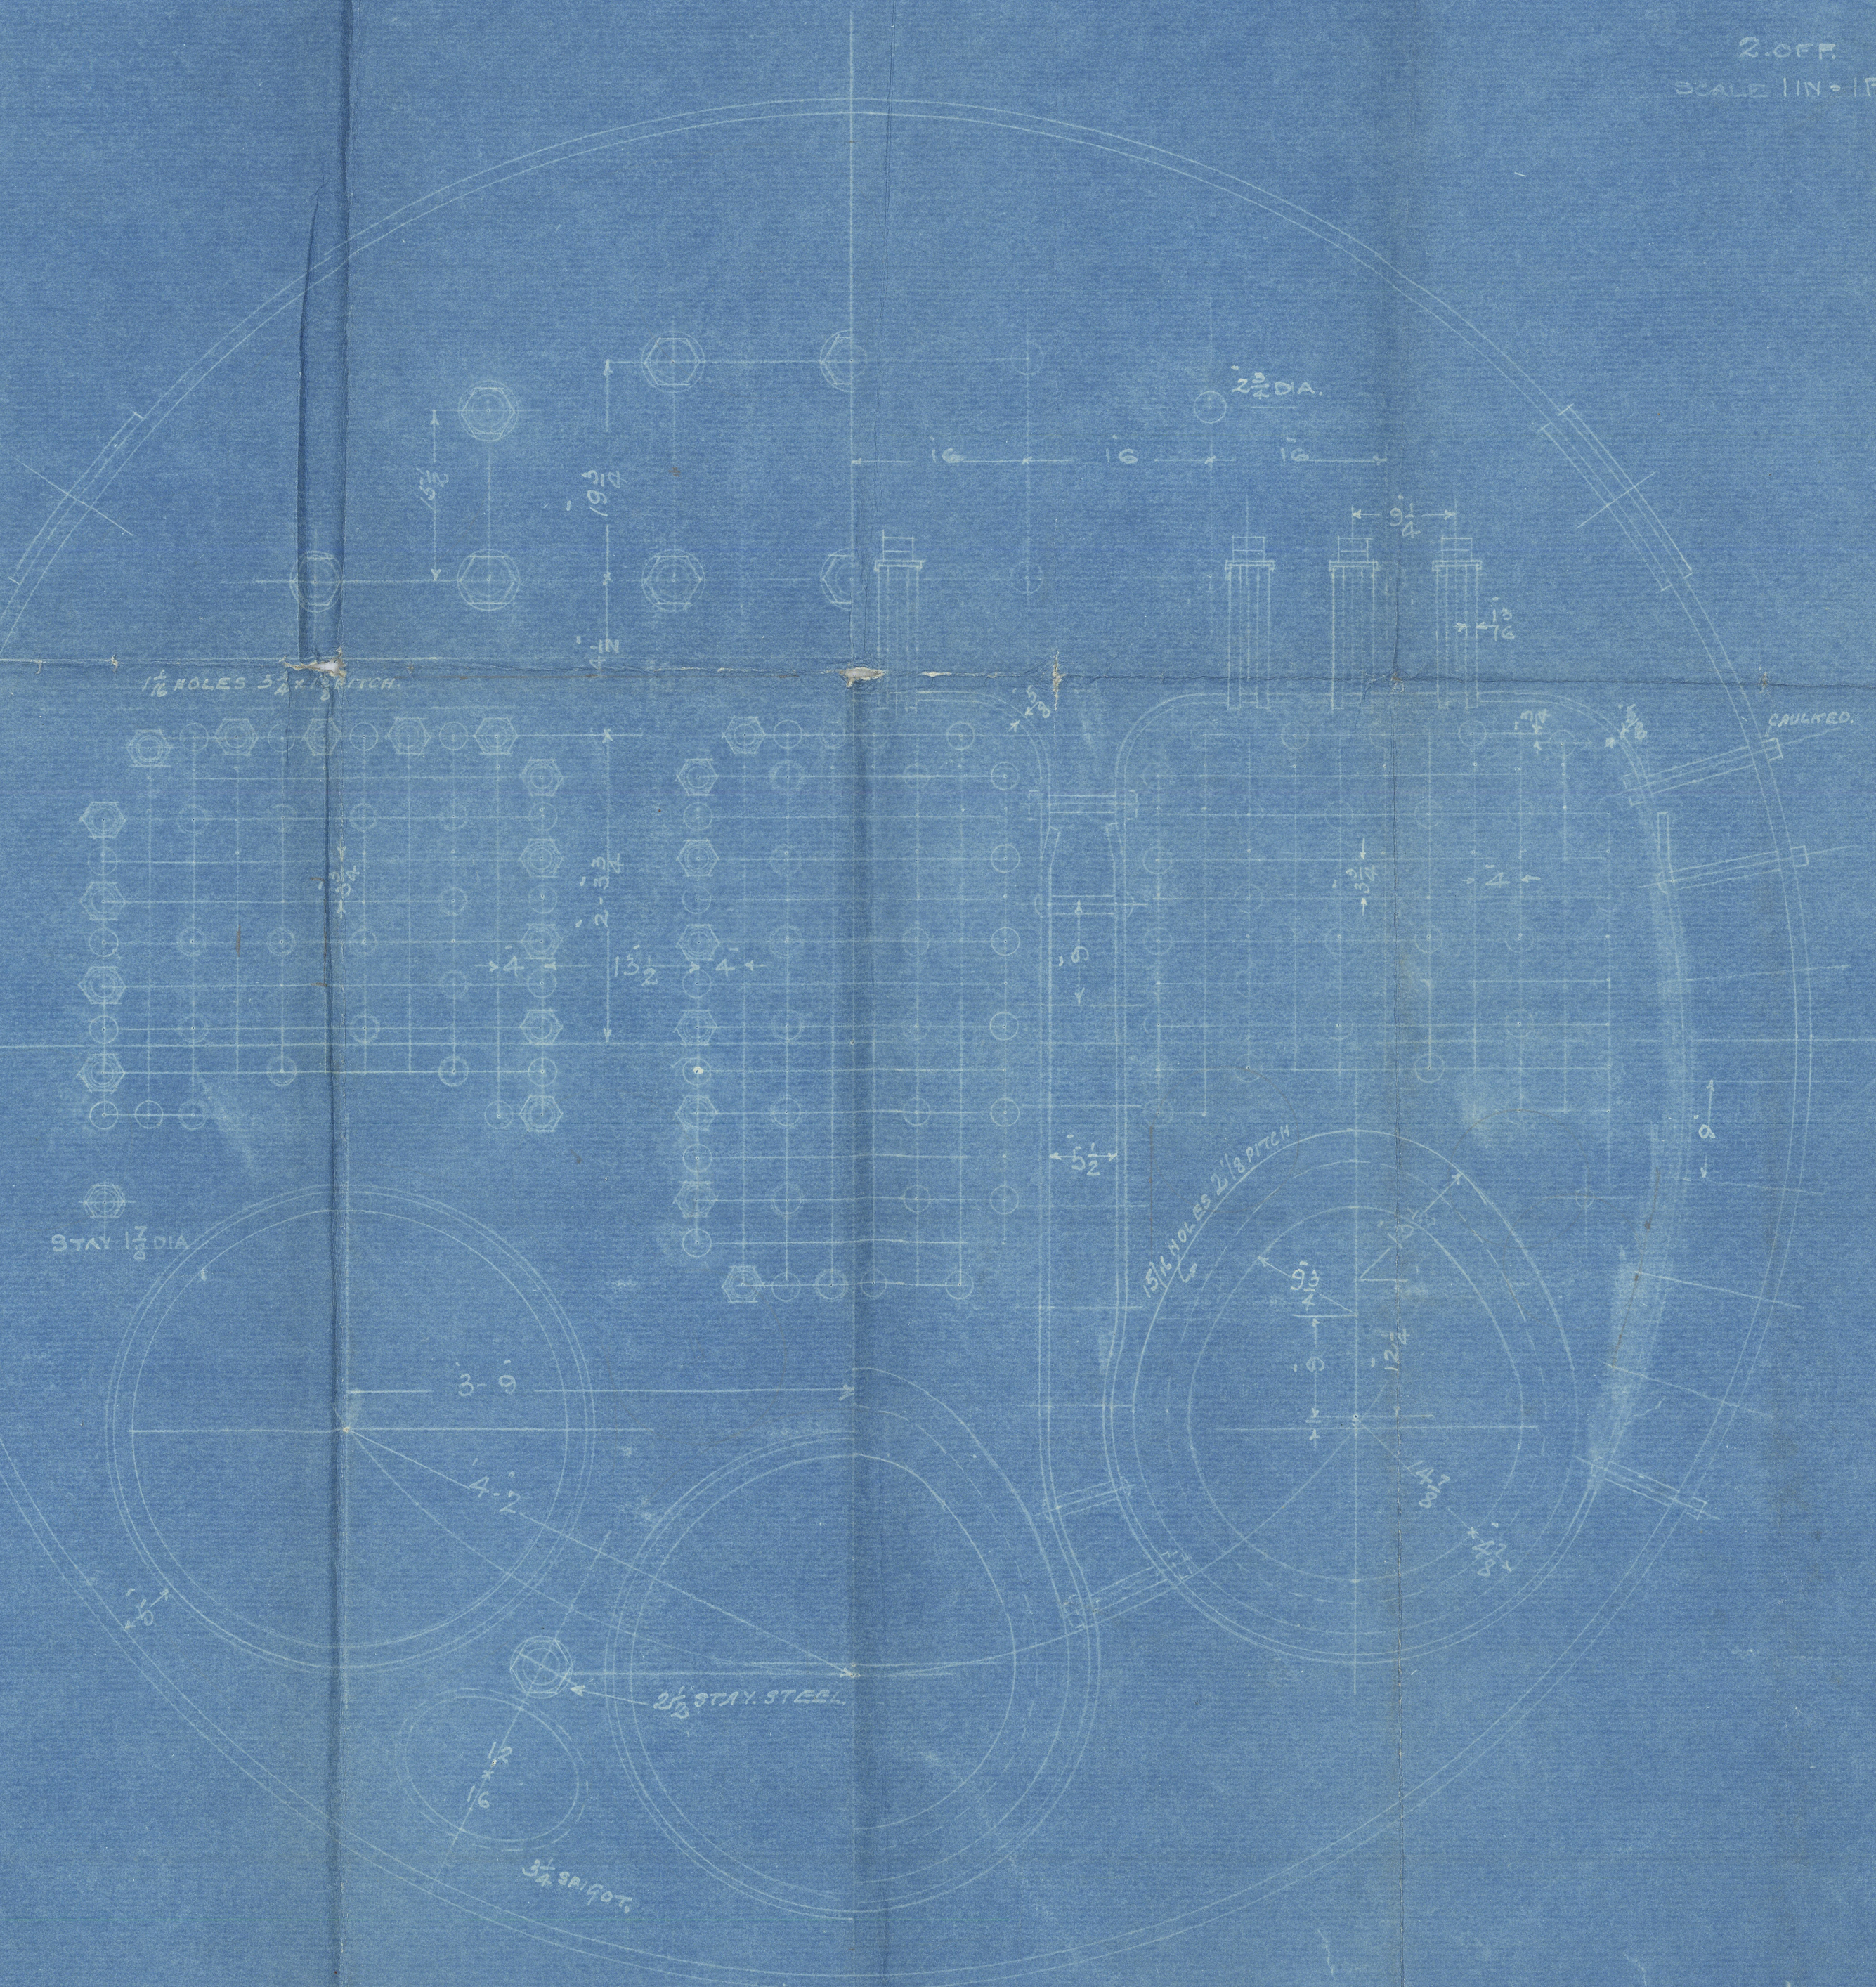

BOILERS N° 2571-2-3.

CB
15/2/27
W.D.



Lloyd's Register Foundation



2571 (S/S Monagas)
MDB. RPT. No. 13027
NWC. 81746

2572 S/S "ARAGUA"

2573 S/S "PERUJA"

Richardson's Repairs & Co. Ltd.

Boilers Nos 2571. 2. 3.

intended for

Palmer S. & S. Co's 974. 5. 6.

S.S. 2571
MDB. RPT. No. 13027

S.S. 2572
MDB. RPT. No. 13056

S.S. 2573
MDB. RPT. No. 13088

Star. 2571
No. 6555
LLOYD'S TEST.
320 lbs.
WP 180 lbs.
9.4.24 PTB.

Pat. 2571.
No. 6558
LLOYD'S TEST.
320 lbs.
WP 180 lbs.
16.4.24 PTB.

Monagas

Star. 2572
No. 6563.
LLOYD'S TEST.
320 lbs.
W.P. 180 lbs.
2.8.27 PTB.

Pat 2572.
No. 6569
LLOYD'S TEST.
320 lbs.
W.P. 180 lbs.
15.8.27 S.W.

Star 2573
No. 6574
LLOYD'S TEST.
320 lbs.
WP 180 lbs.
5.9.27 PTB.

Pat 2573
No. 6578
LLOYD'S TEST.
320 lbs.
WP 180 lbs.
16.9.27 PTB.

S/S "Peruja"

W1151 - 0071